

FILE NAME: V2G PROJECTS??-105 George and Sallie Meyer N7423 E Lakeshore Dr Town of Whitewater

PLAT OF SURVEY


BEING LOT 14 AND PART OF LOT 15, THORNE HEIGHTS SUBDIVISION, LOCATED IN PART OF THE SOUTHEAST ¼ AND IN THE SOUTHWEST ¼ OF SECTION 35, TOWNSHIP 4 NORTH, RANGE 15 EAST, WALWORTH COUNTY, WISCONSIN.



WHITEWATER
LAKE

LEGEND:


- (100.00') RECORDED DISTANCE
- 100.00' MEASURED DISTANCE
- 1" FOUND IRON PIPE, UNLESS NOTED
- ⊗ ¾" x 18" IRON PIPE SET, 1.13 lbs./L.F.
- ⚠ WELL
- Ⓢ SEPTIC TANK
- Ⓢ SEPTIC VENT
- Ⓟ POWER POLE

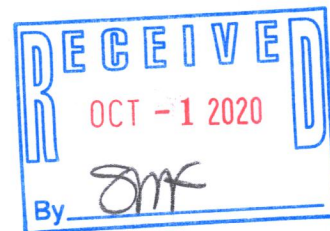

PLOT DATE: 07/07/2020

V2G JOB#: 2020-105

DTH-14

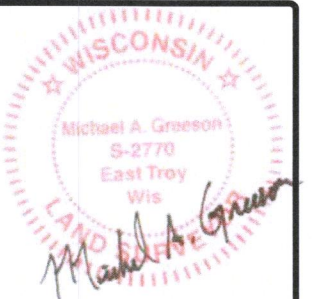

I, MICHAEL A. GREESON P.L.S. #2770, HEREBY CERTIFY THAT THIS SURVEY WAS DONE UNDER MY DIRECTION AND THAT THE ABOVE MAP IS A TRUE REPRESENTATION THEREOF AND SHOWS THE SIZE AND LOCATION OF THE PROPERTY, ITS EXTERIOR BOUNDARIES, THE LOCATION OF ALL VISIBLE STRUCTURES AND DIMENSIONS OF ALL PRINCIPAL BUILDINGS THEREON, BOUNDARY FENCES, APPARENT EASEMENTS, ROADWAYS AND VISIBLE ENCROACHMENTS, IF ANY.

THIS SURVEY IS MADE FOR THE USE OF THE PRESENT OWNERS OF THE PROPERTY, AND ALSO THOSE WHO PURCHASE, MORTGAGE OR GUARANTEE TITLE TO WITHIN ONE (1) YEAR FROM DATE HERETO.

SURVEY MADE FOR:
SALLIE AND GEORGE
MEYER
14940 JUNOEAL BLVD.
ELM GROVE, WI 53122

DATE	ITEM
07/07/2020	ORIGINAL SURVEY



415-1509