LAND-MARK SURVEYING
Mark L. Miritz
Wisconsin Professional Land Surveyor S-2582

N9330 Knuteson Drive
Whitewater, WI 53190
Phone:(262)495-3284
MARKMIRITZ@
LAND-MARKSURVEYING.COM

ORDERED BY:
EHLERT CONSTRUCTION
291 COBURN LANE
WHITEWATER, WI 53190

PLAT OF SURVEY

A SURVEY OF THE SOUTH LINE OF LOT 2, BLOCK 6 OF GRAND VIEW SUBDIVISION, LOCATED IN THE SOUTHEAST 1/4 OF SECTION 34, TOWN 4 NORTH, RANGE 15 EAST, WHITEWATER TOWNSHIP, WALWORTH COUNTY, WISCONSIN.

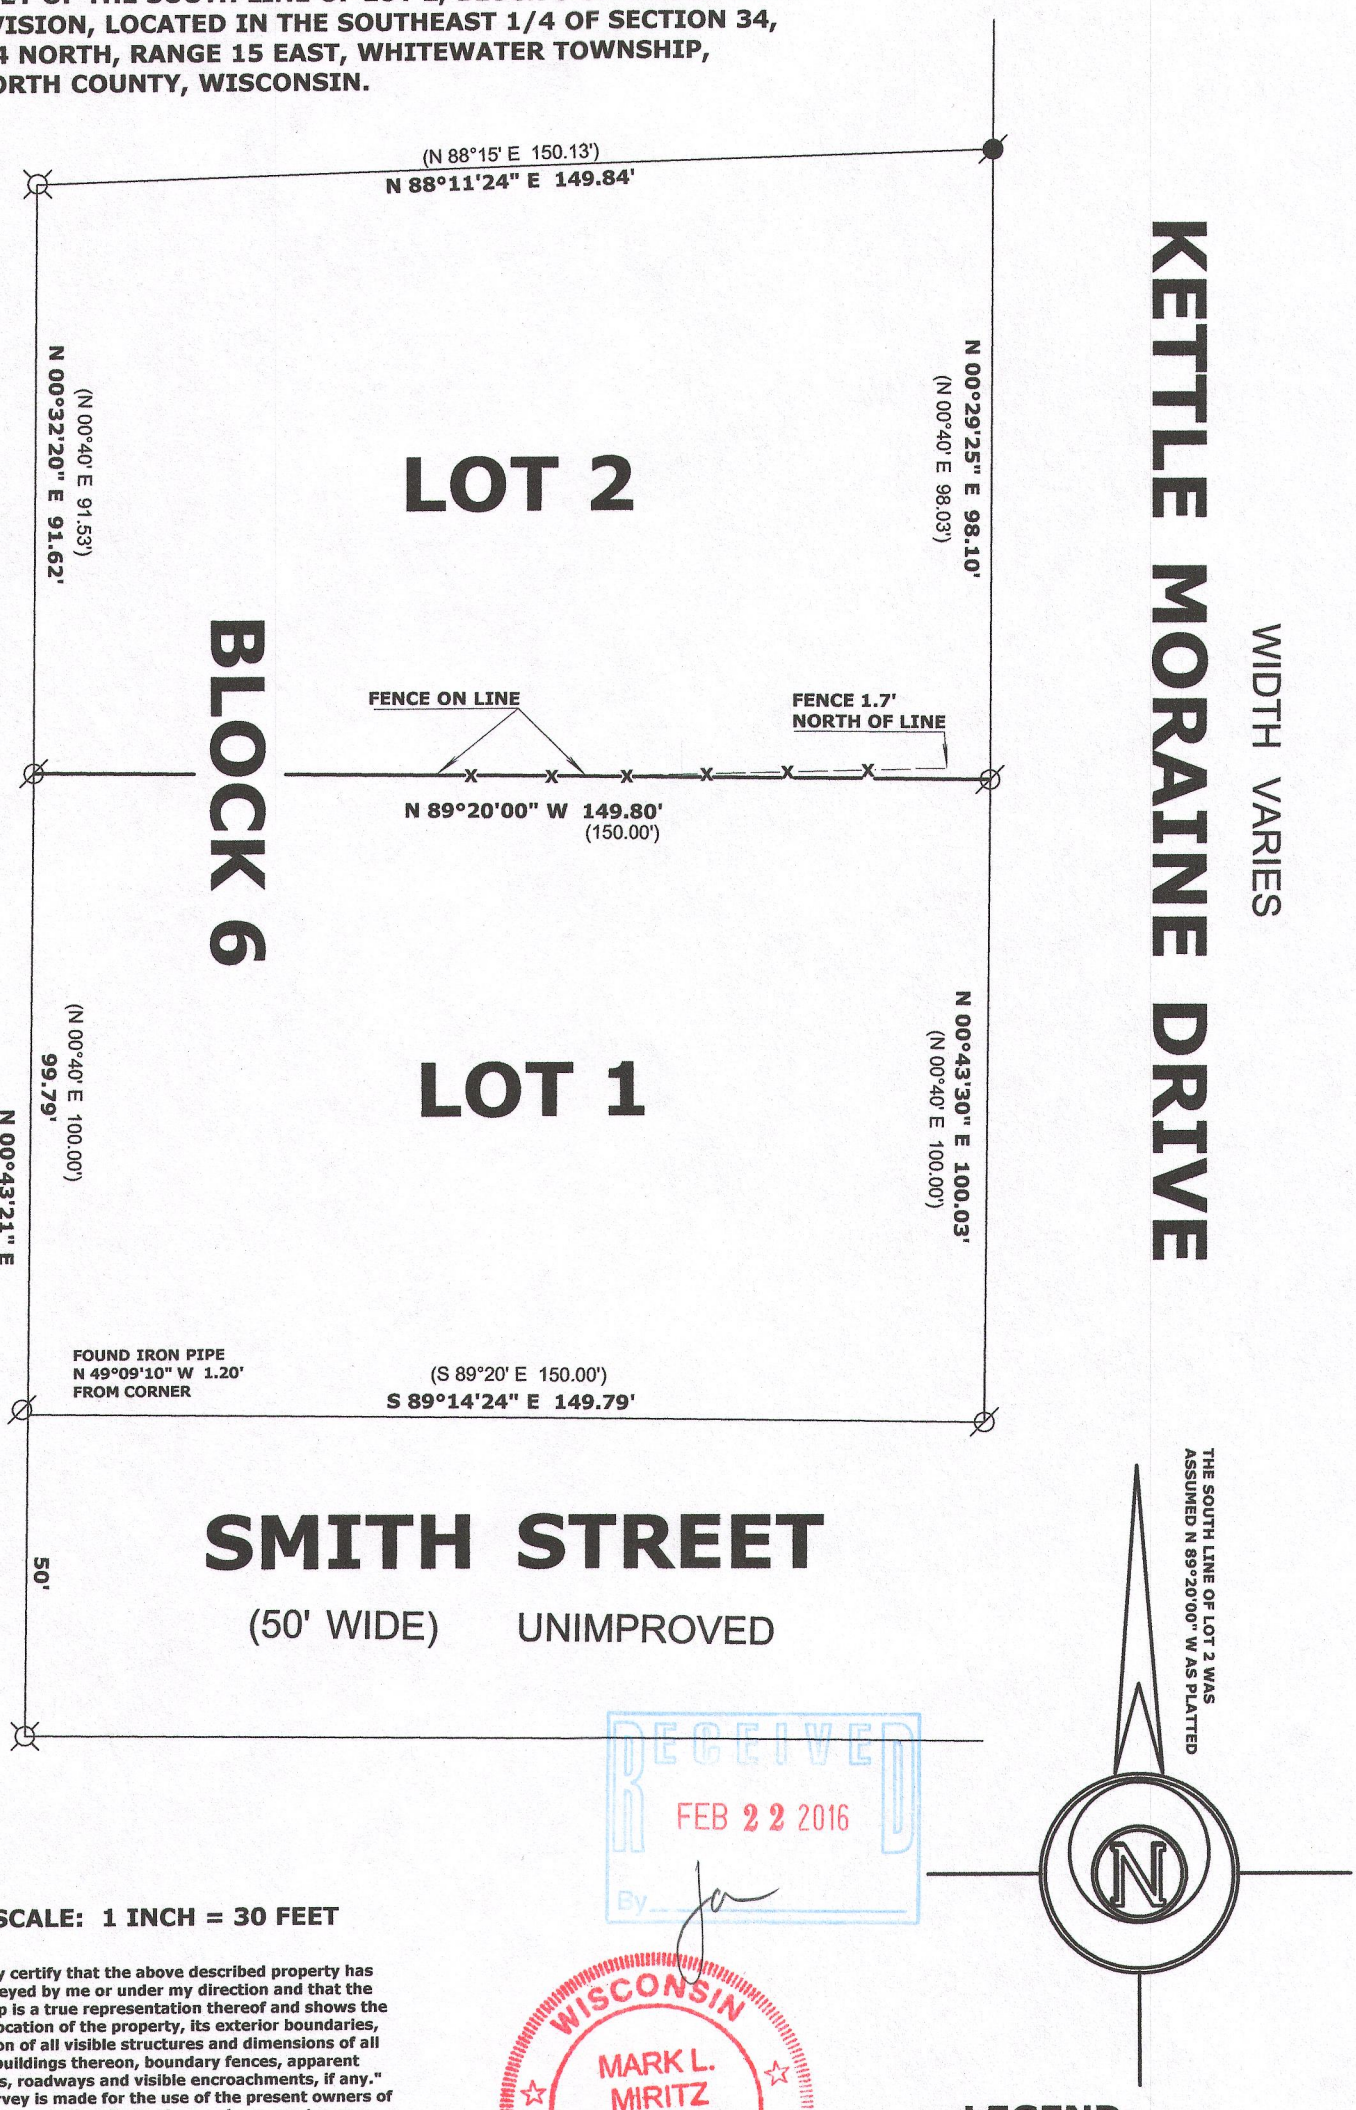

RECEIVED
FEB 22 2016
By

SCALE: 1 INCH = 30 FEET

"I hereby certify that the above described property has been surveyed by me or under my direction and that the above map is a true representation thereof and shows the size and location of the property, its exterior boundaries, the location of all visible structures and dimensions of all principal buildings thereon, boundary fences, apparent easements, roadways and visible encroachments, if any."
"This survey is made for the use of the present owners of the property, and also those who purchase, mortgage, or guarantee the title thereto within one year from date hereof."

Mark L. Miritz

MARK L. MIRITZ
WISCONSIN PROFESSIONAL
LAND SURVEYOR S-2582

WISCONSIN
MARK L. MIRITZ
S-2582
WHITEWATER, WI
LAND SURVEYOR

DATE: DEC. 18, 2015 **JOB NO.** 15.1202

dGd-67
dGd-68
415-1383

LEGEND

⌀	FOUND IRON PIPE 2"
⌀	FOUND IRON PIPE 1 1/4"
●	FOUND IRON ROD 3/4"
(xx)	RECORDED AS DIMENSION
—x—x—	EXISTING WOOD FENCE