




PLAT OF SURVEY
LOT 31 BLOCK 1 OF MORaine PARK SUBDIVISION
LOCATED IN PART OF THE SW 1/4 AND NW 1/4 OF THE NW 1/4 OF SECTION 35, TOWN 4 NORTH, RANGE 15 EAST,
TOWN OF WHITEWATER, WALWORTH COUNTY, WISCONSIN

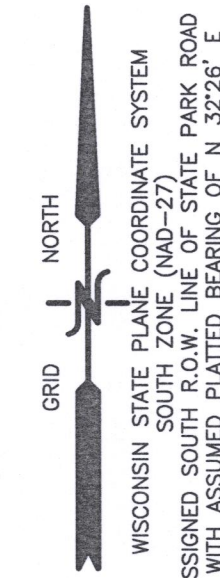

10 5 0 10 20 30 40
MAP SCALE IN FEET - ORIGINAL 1"=10'

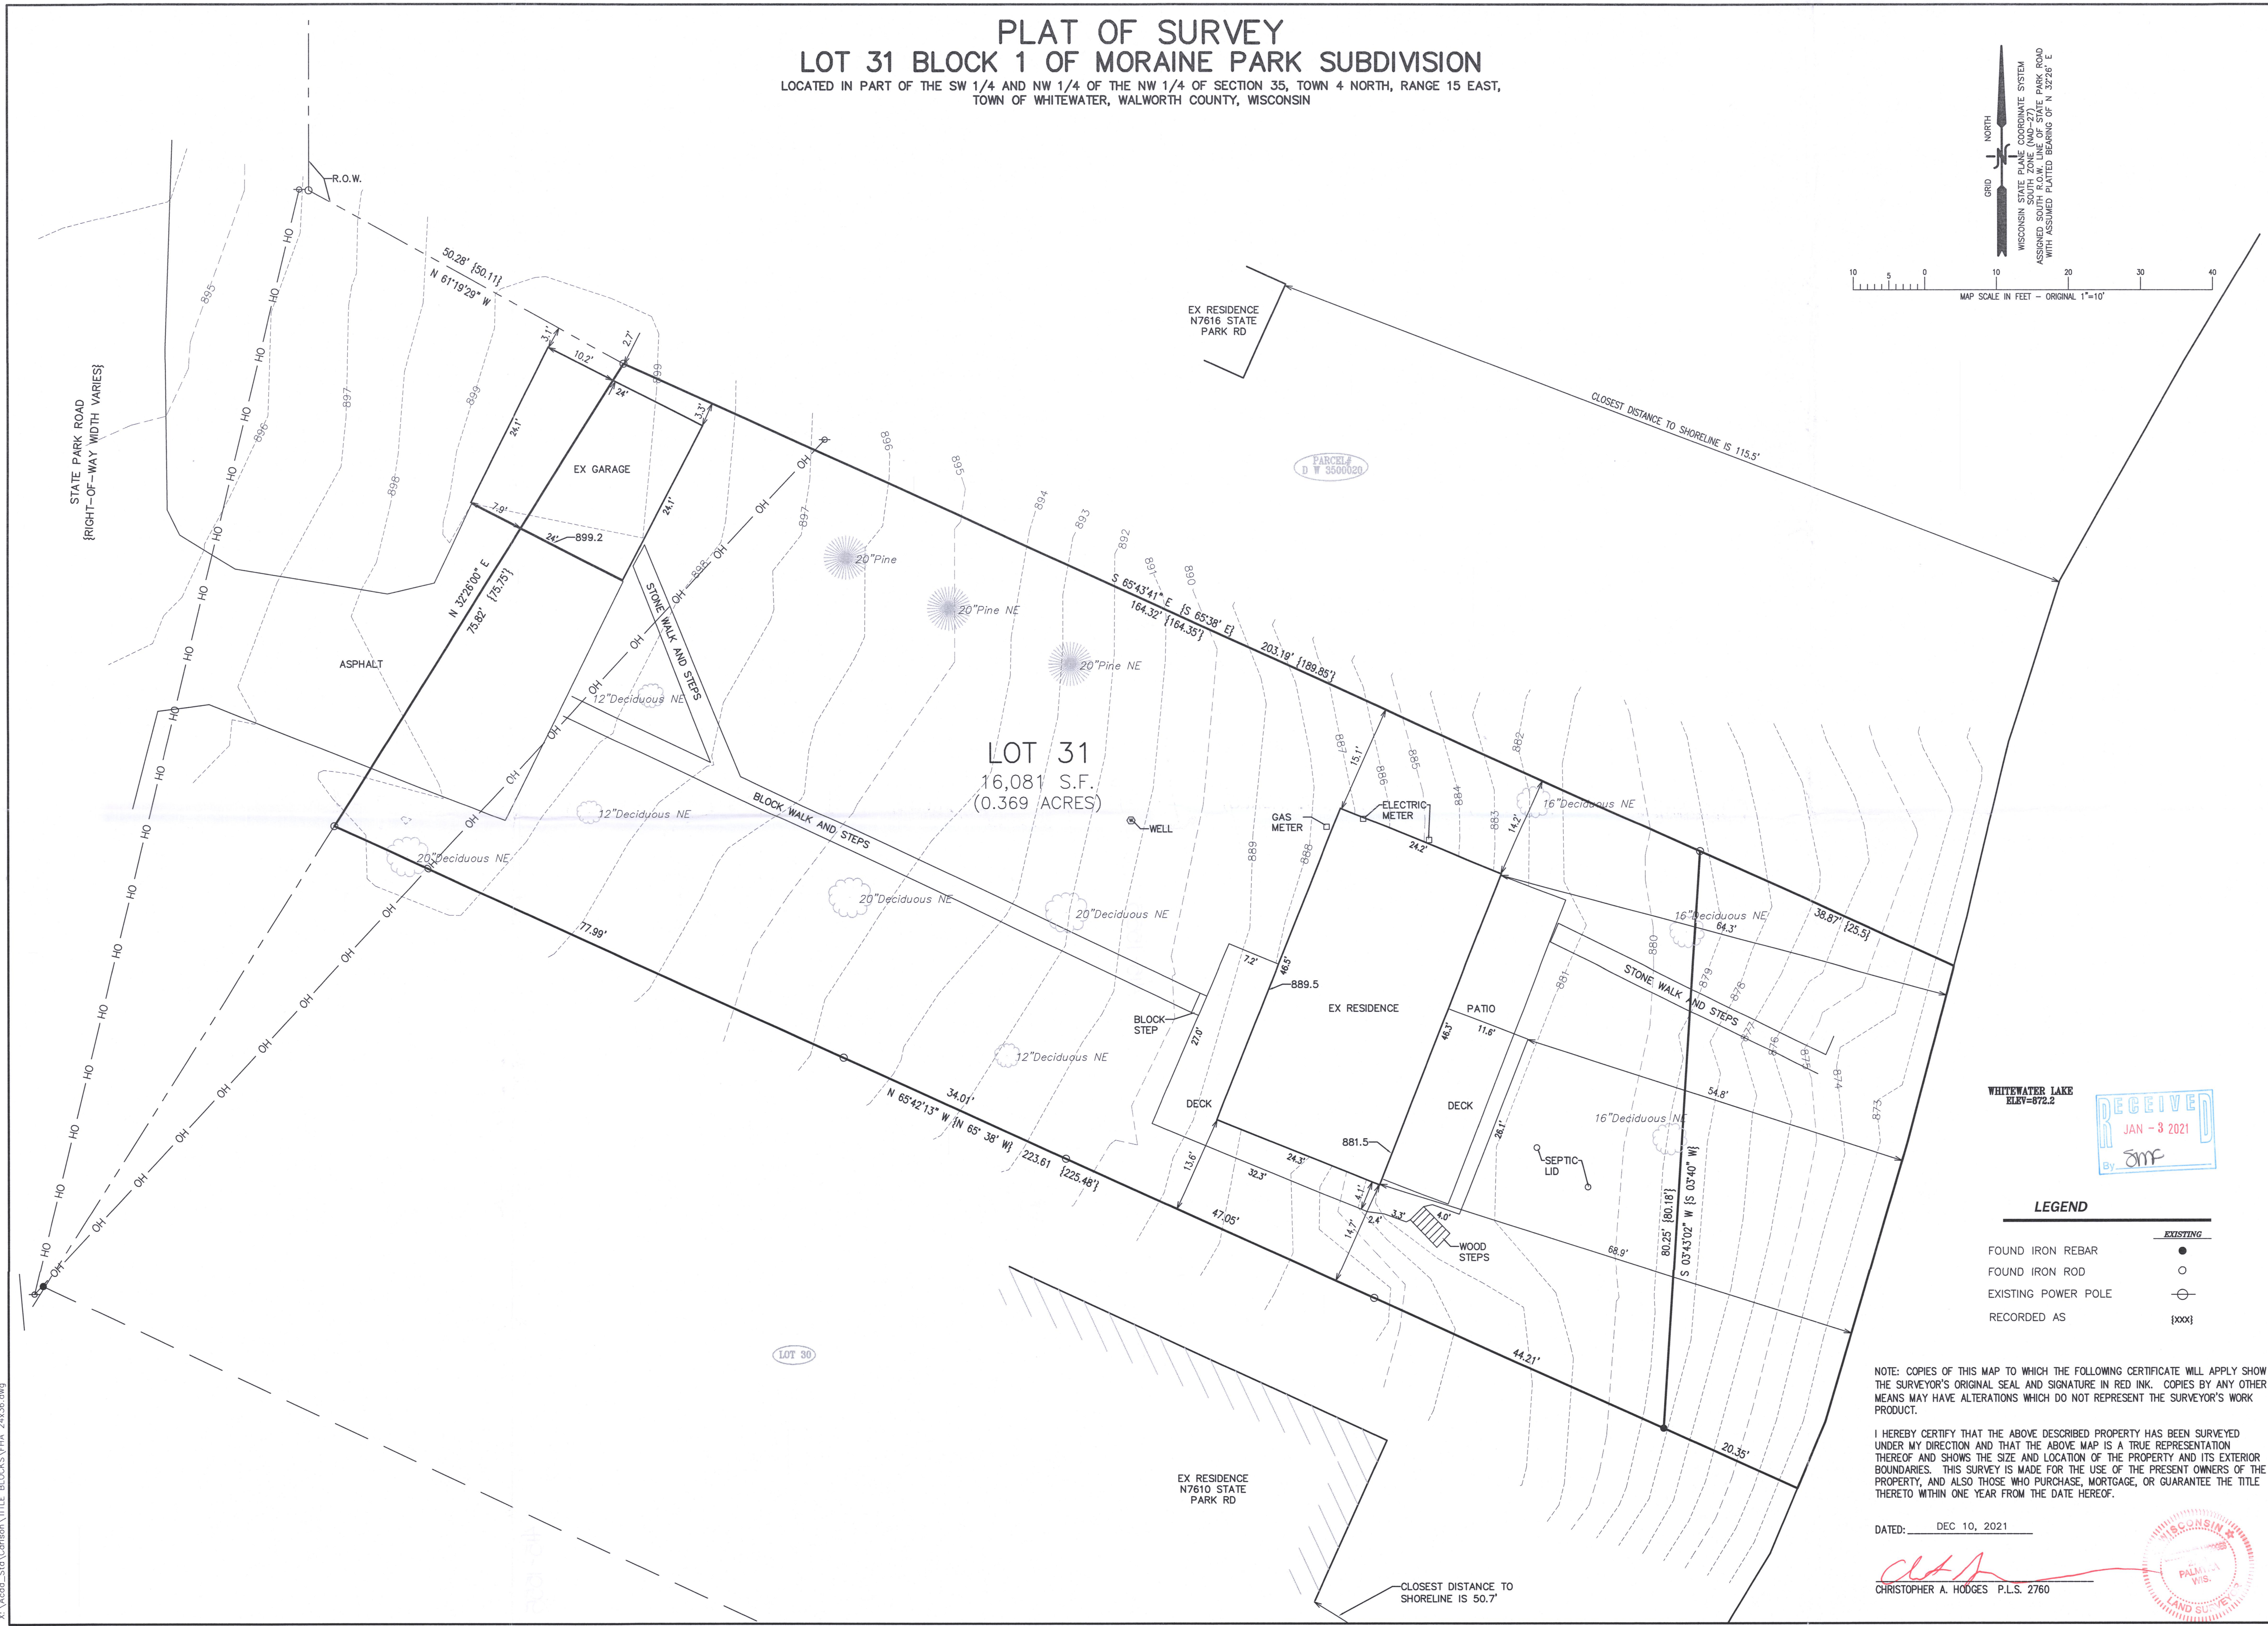

WHITEWATER LAKE
ELEV=872.2

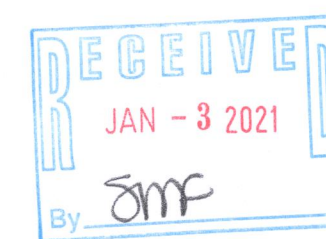

LEGEND


	EXISTING
FOUND IRON REBAR	●
FOUND IRON ROD	○
EXISTING POWER POLE	⊗
RECORDED AS	{xxx}

NOTE: COPIES OF THIS MAP TO WHICH THE FOLLOWING CERTIFICATE WILL APPLY SHOW THE SURVEYOR'S ORIGINAL SEAL AND SIGNATURE IN RED INK. COPIES BY ANY OTHER MEANS MAY HAVE ALTERATIONS WHICH DO NOT REPRESENT THE SURVEYOR'S WORK PRODUCT.

I HEREBY CERTIFY THAT THE ABOVE DESCRIBED PROPERTY HAS BEEN SURVEYED UNDER MY DIRECTION AND THAT THE ABOVE MAP IS A TRUE REPRESENTATION THEREOF AND SHOWS THE SIZE AND LOCATION OF THE PROPERTY AND ITS EXTERIOR BOUNDARIES. THIS SURVEY IS MADE FOR THE USE OF THE PRESENT OWNERS OF THE PROPERTY, AND ALSO THOSE WHO PURCHASE, MORTGAGE, OR GUARANTEE THE TITLE THERETO WITHIN ONE YEAR FROM THE DATE HEREOF.

DATED: DEC 10, 2021

CHRISTOPHER A. HODGES P.L.S. 2760

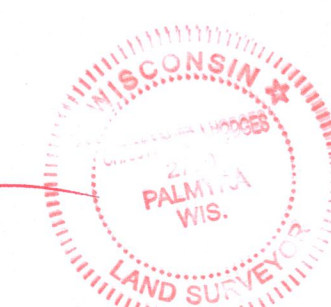

N7612 STATE PARK ROAD
PLAT OF SURVEY
N7612 STATE PARK ROAD
WHITEWATER, WISCONSIN

WORK ORDERED BY -
WILLIAM WOLSKI
166 LOS LAGOS DRIVE
BLOOMINGDALE, IL 60108

FARRIS, HANSEN & ASSOCIATES, INC.
ENGINEERING - ARCHITECTURE - SURVEYING
7 RIDGWAY COURT P.O. BOX 437
ELKHORN, WISCONSIN 53121
OFFICE: (262) 723-2098 FAX: (262) 723-5886

REVISIONS
PROJECT NO. 10586
DATE 12/9/21
SHEET NO. 1 OF 1