


Legend:

- Found 1" Iron Pipe
- Utility Pole
- Guy Anchor
- Utility Pedestal

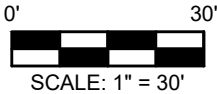


"APPROXIMATE ORDINARY HIGH WATER MARK - FOR REFERENCE ONLY PER WI STATUTE 236.025. "ANY LAND BELOW THE ORDINARY HIGH WATER MARK OF A LAKE OF A NAVIGABLE STREAM IS SUBJECT TO THE PUBLIC TRUST IN NAVIGABLE WATERS THAT IS ESTABLISHED UNDER ARTICLE IX, SECTION 1, OF THE STATE CONSTITUTION."

BEARINGS HEREON RELATE TO THE EAST LINE OF BLOCK 2 OF MINNIESKA SUBDIVISION AS PLATTED; ASSUMED BEARING SOUTH 09°10' WEST.

LOCATION: N7497 E Lakeshore Dr, Whitewater, WI 53190
PREPARED FOR: Bob Szczinski
PROPERTY DESCRIPTION: Per Doc. No. 1017629
Lot 11, Block 2 in Minnieska Subdivision as recorded in the Register of Deeds office on February 13, 1954 in Volume 12 of Plats on Page 93, Town of Whitewater, Walworth County, Wisconsin.
Also the following described parcel of land. Beginning at the Southwest corner of said Lot 11 as shown on the recorded plat; thence South 82°45' West, 47.0 feet to the shore of Whitewater Lake as established at this date, thence Northwesterly along the shore 96.5 feet to the most Westerly point of said Lot 11; thence Southeasterly along the shore of said Lake as shown on the recorded plat, 154.0 to the place of beginning.

TAX ID: DM 00034

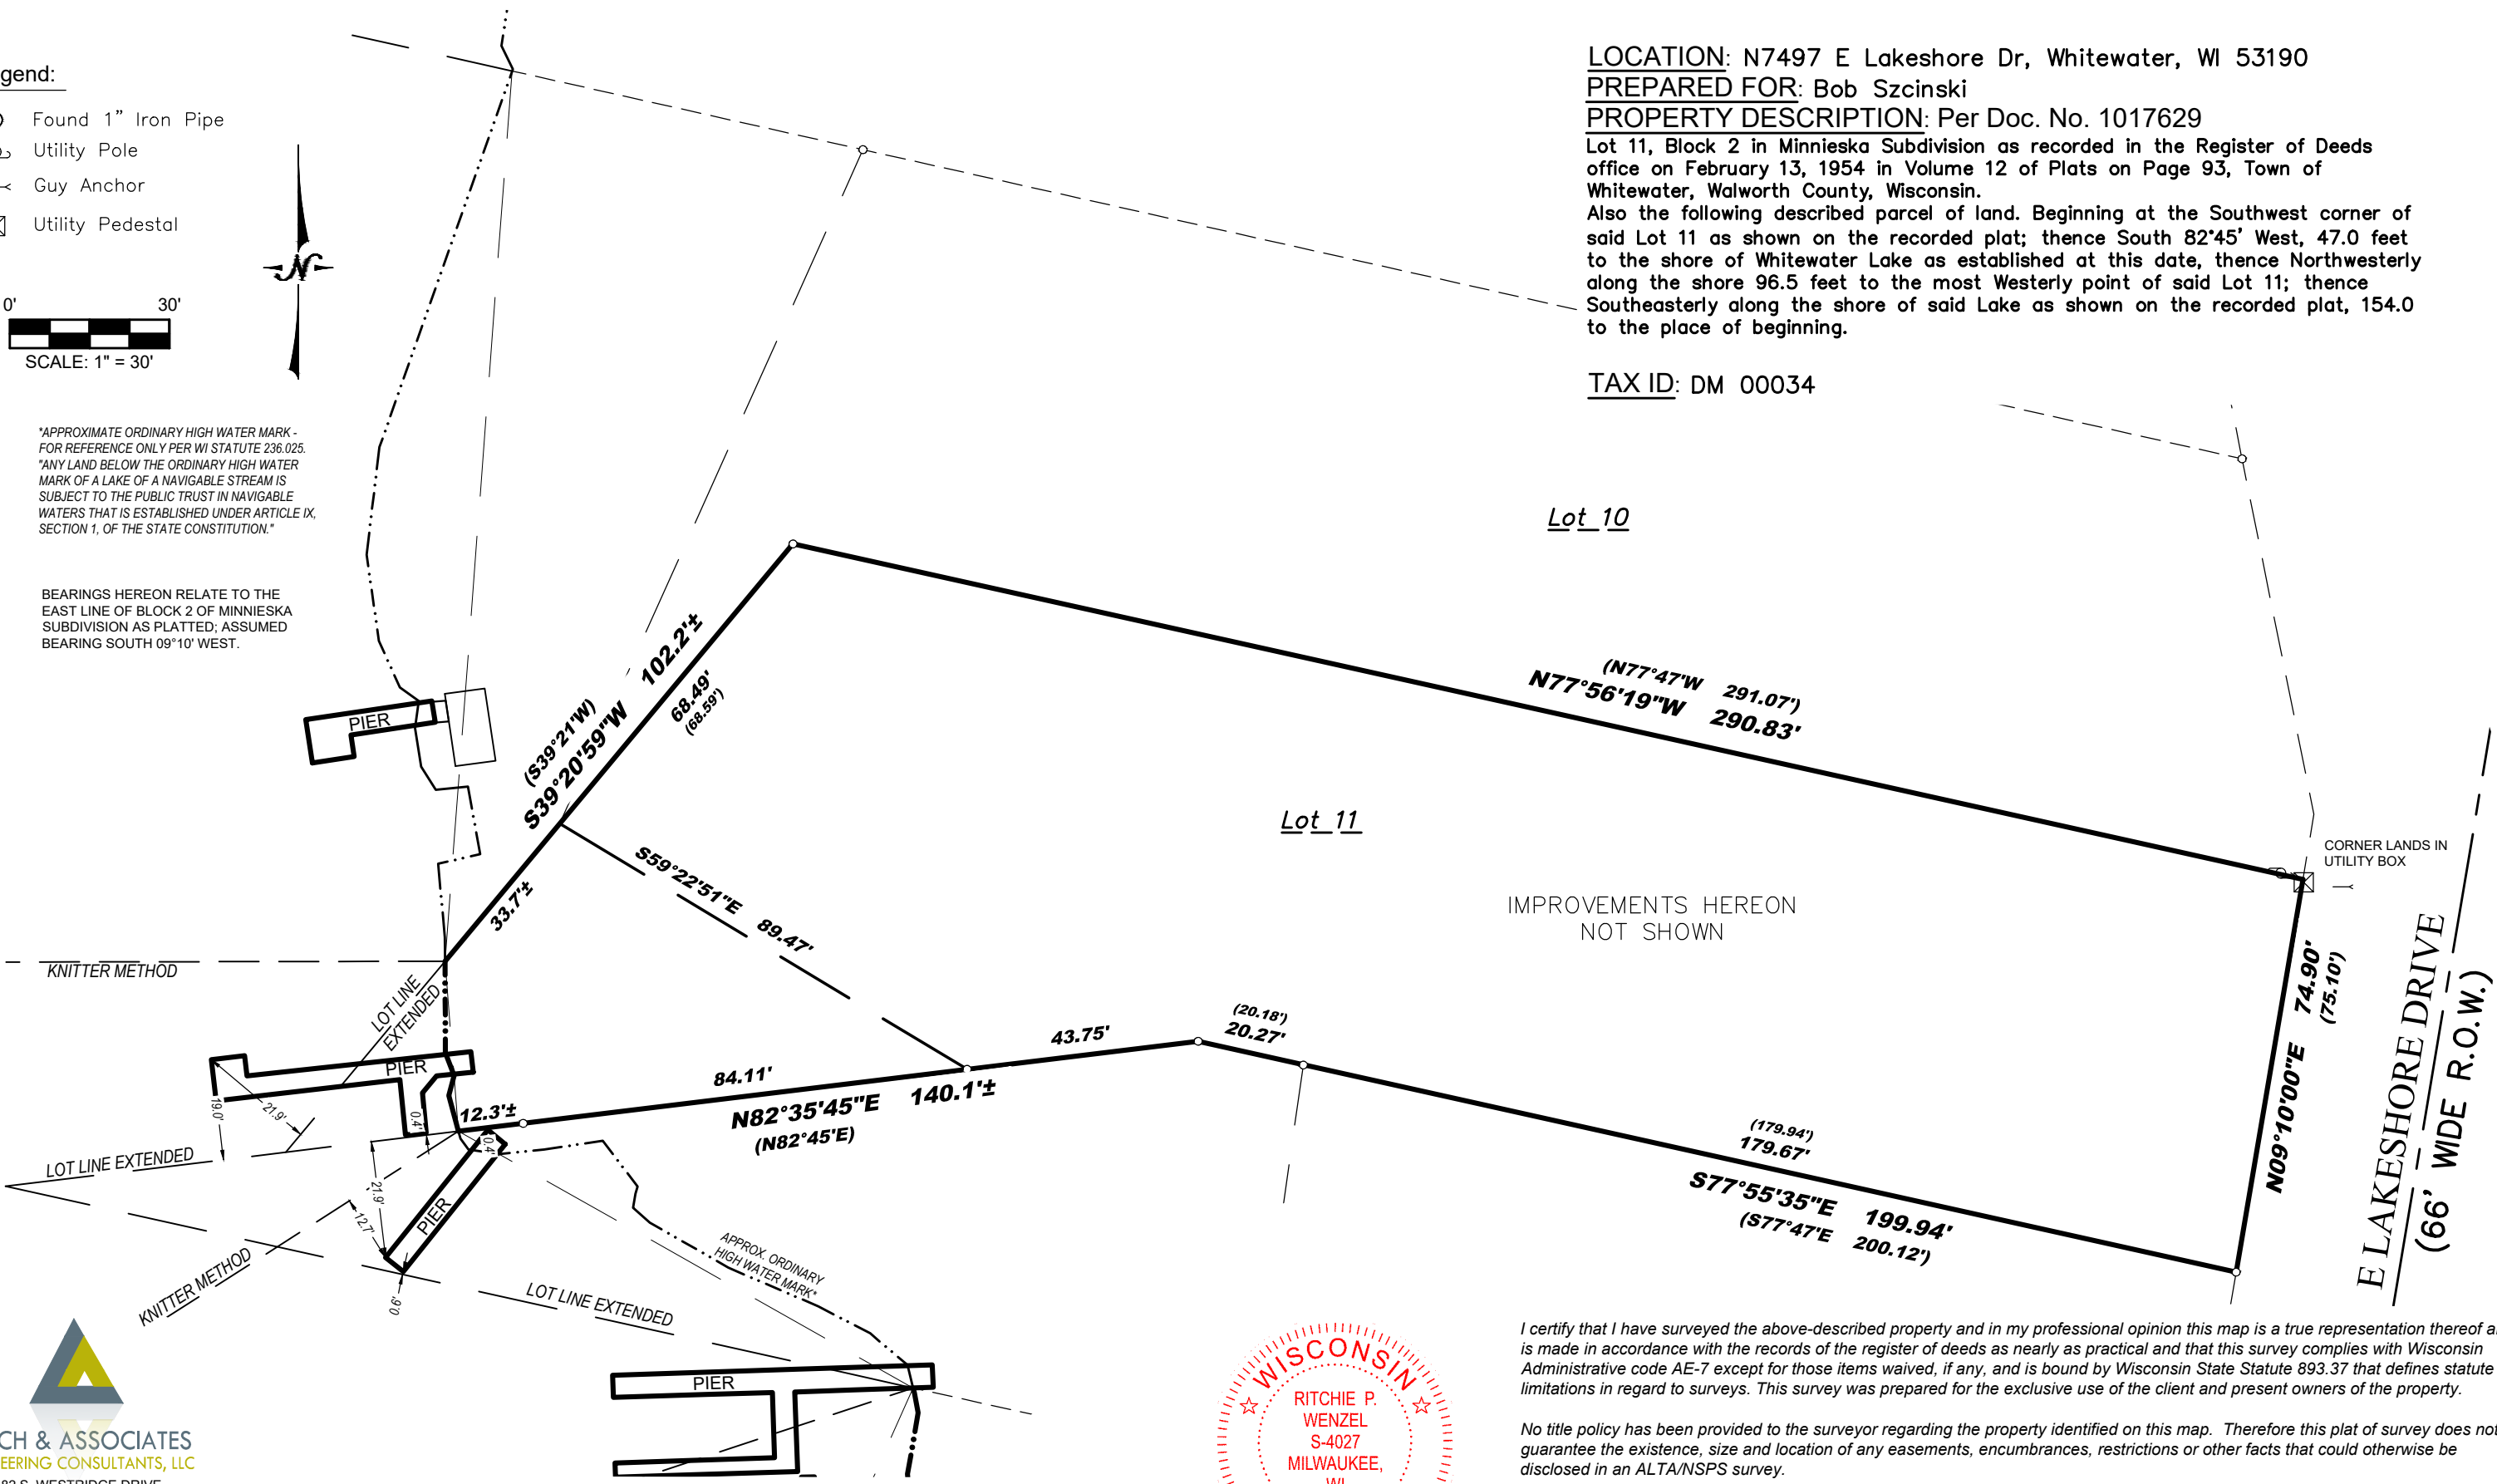



LYNCH & ASSOCIATES
ENGINEERING CONSULTANTS, LLC

5482 S. WESTRIDGE DRIVE
NEW BERLIN, WI 53151


440 MILWAUKEE AVENUE
BURLINGTON, WI 53105

(262) 402-5040



I certify that I have surveyed the above-described property and in my professional opinion this map is a true representation thereof and is made in accordance with the records of the register of deeds as nearly as practical and that this survey complies with Wisconsin Administrative code AE-7 except for those items waived, if any, and is bound by Wisconsin State Statute 893.37 that defines statute of limitations in regard to surveys. This survey was prepared for the exclusive use of the client and present owners of the property.

No title policy has been provided to the surveyor regarding the property identified on this map. Therefore this plat of survey does not guarantee the existence, size and location of any easements, encumbrances, restrictions or other facts that could otherwise be disclosed in an ALTA/NSPS survey.



Ritchie P. Wenzel, Professional Land Surveyor, S-4027