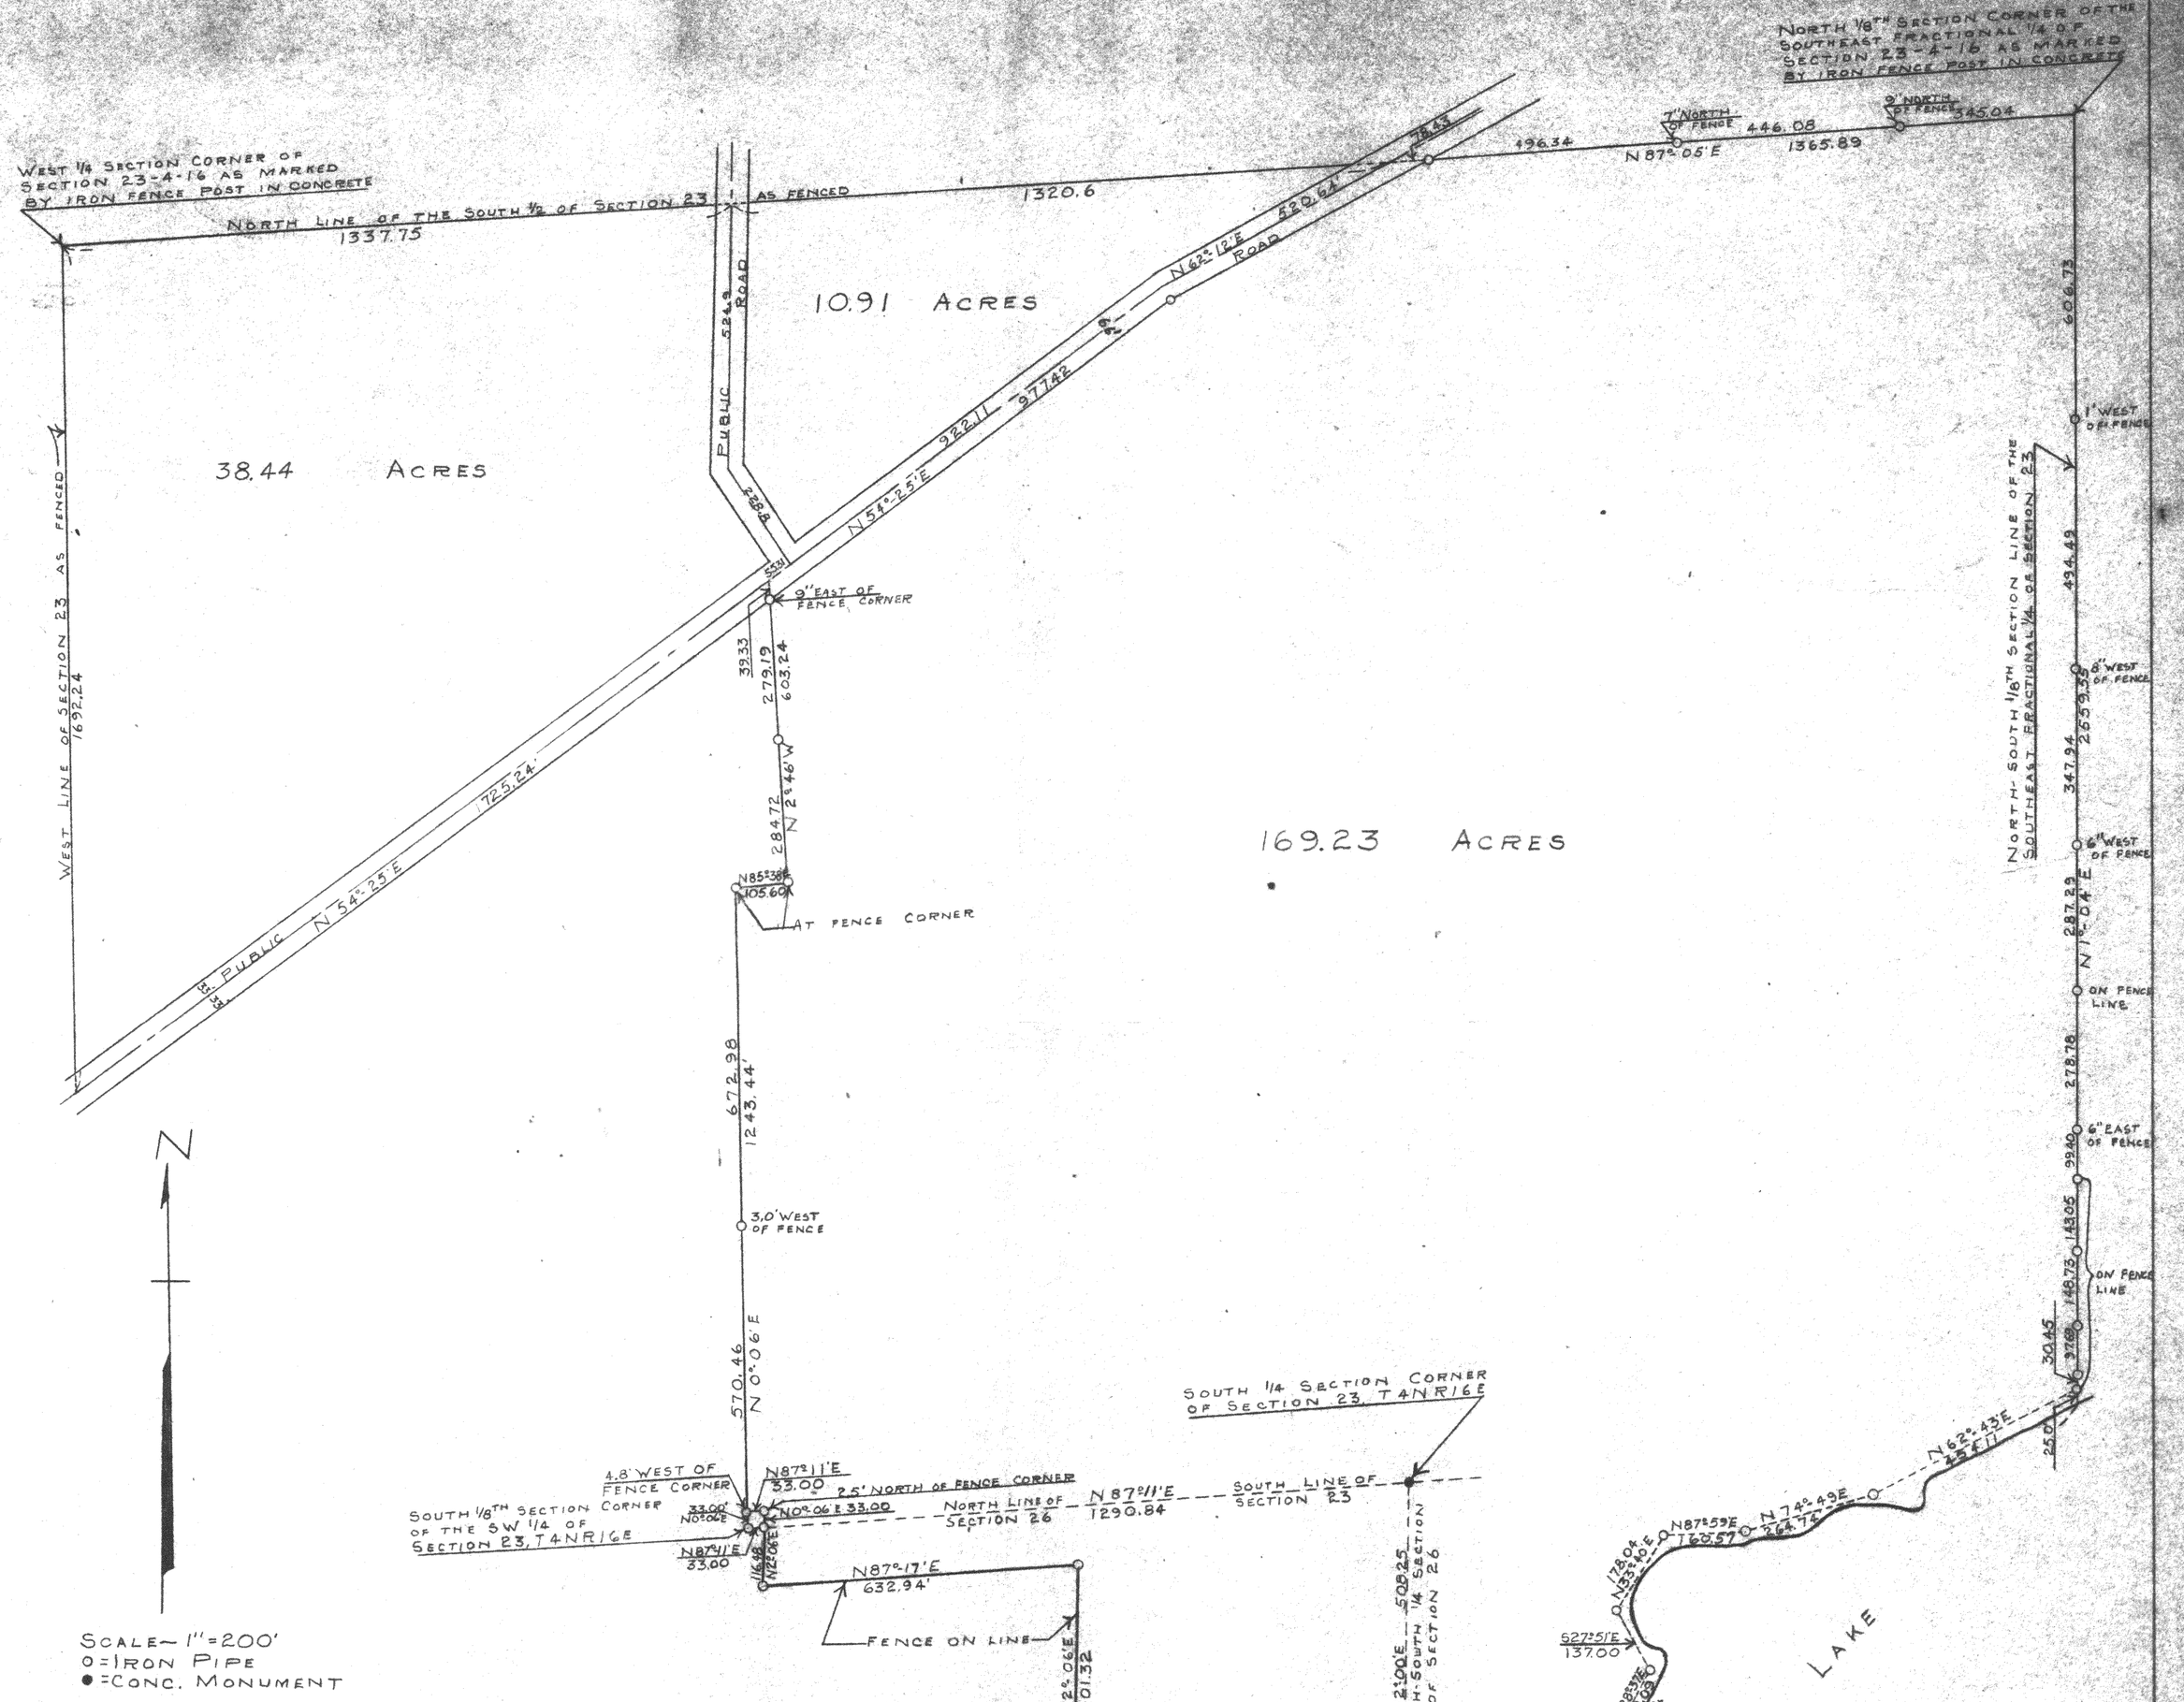

PLAT OF SURVEY OF LAND OWNED BY THE GIRL SCOUTS OF RACINE COUNTY, INC., LOCATED IN SECTIONS 23 AND 26, T4NR16E, WALWORTH COUNTY, WISCONSIN
OCTOBER 21, 1953

George T. Dunham
GEORGE T. DUNHAM, SURVEYOR
DELAVAN, WISCONSIN

LG-23-7
LG-23-7A, 7B
LG-26-3

416-10