ABERNATHY and ASSOCIATES
Kenneth B. Abernathy Jr.
Wisconsin Registered Land Surveyor S-1594

Rt. 3, Box 273
Elkhorn, Wisconsin 53121
Phone: (414) 723-4260 (office)
(414) 723-7209 (FAX)

PLAT OF SURVEY

Lot 84 of Mariner Hills Subdivision, located in Section 34, Town 4 North, Range 16 East, La Grange Township, Walworth County, Wisconsin.

Owner: Smith

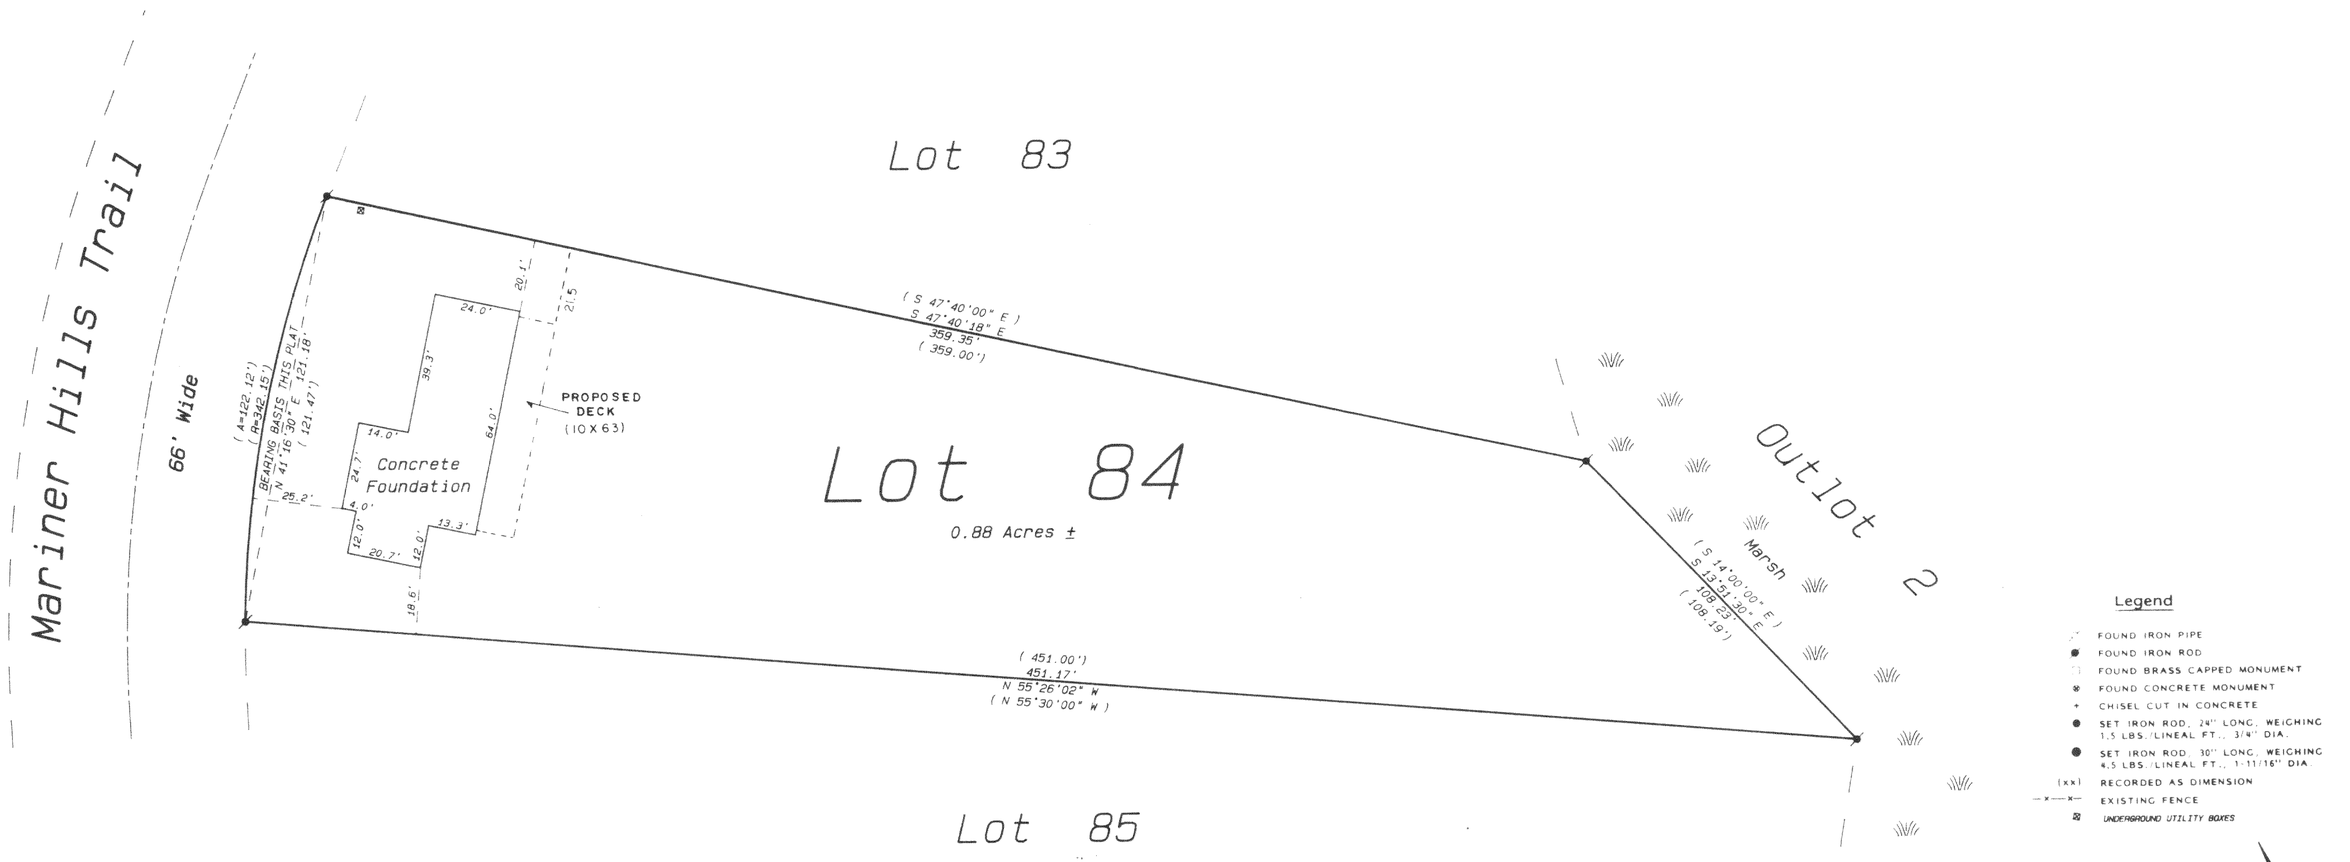

Legend

- FOUND IRON PIPE
- FOUND IRON ROD
- FOUND BRASS CAPPED MONUMENT
- FOUND CONCRETE MONUMENT
- + CHISEL CUT IN CONCRETE
- SET IRON ROD, 24" LONG, WEIGHING 1.5 LBS./LINEAL FT., 3/4" DIA.
- SET IRON ROD, 30" LONG, WEIGHING 4.5 LBS./LINEAL FT., 1-11/16" DIA.
- (xxx) RECORDED AS DIMENSION
- —x—x— EXISTING FENCE
- UNDERGROUND UTILITY BOXES

RECEIVED
OCT 22 1998

SCALE: 1" = 30 FEET

Ordered by: Amy Schwarz
Schauder Building, Inc.
4115 Highway 51 North
Janesville, Wisconsin
53545-9574

NOTE: DECK ADDED PER INFORMATION SUPPLIED BY OWNER 7/17/98

WISCONSIN
KENNETH B. ABERNATHY, JR.
S-1594
ELKHORN, WI
LAND SURVEYOR

"I hereby certify that the above described property has been surveyed by me or under my direction and that the above map is a true representation thereof and shows the size and location of the property, its exterior boundaries, the location of all visible structures and dimensions of all principal buildings thereon, boundary fences, apparent easements, roadways and visible encroachments, if any."

"This survey is made for the use of the present owners of the property, and also those who purchase, mortgage, or guarantee the title thereto within one year from date hereof."

Kenneth B. Abernathy

KENNETH B. ABERNATHY, JR.
WISCONSIN REGISTERED LAND SURVEYOR,
S-1594

REVISED: 7/17/98

Date: October 9, 1996 Job No. 1996.813FL

4116-1396
HMH-84

DESIGN PRODUCTS (262)781