ABERNATHY and ASSOCIATES
Kenneth B. Abernathy Jr.
Wisconsin Registered Land Surveyor S-1594

W4056 Bray Road
Elkhorn, Wisconsin 53121
Phone: (414) 723-4260 (office)
(414) 723-7209 (fax)

PLAT OF SURVEY

Lot 1 of Gladhurst Subdivision, located in the Southeast 1/4 of Section 23, the Southwest 1/4 of Section 24, the Northwest 1/4 of Section 25, and the Northeast 1/4 of Section 26, Town 4 North, Range 16 East, Town of LaGrange, Walworth County, Wisconsin

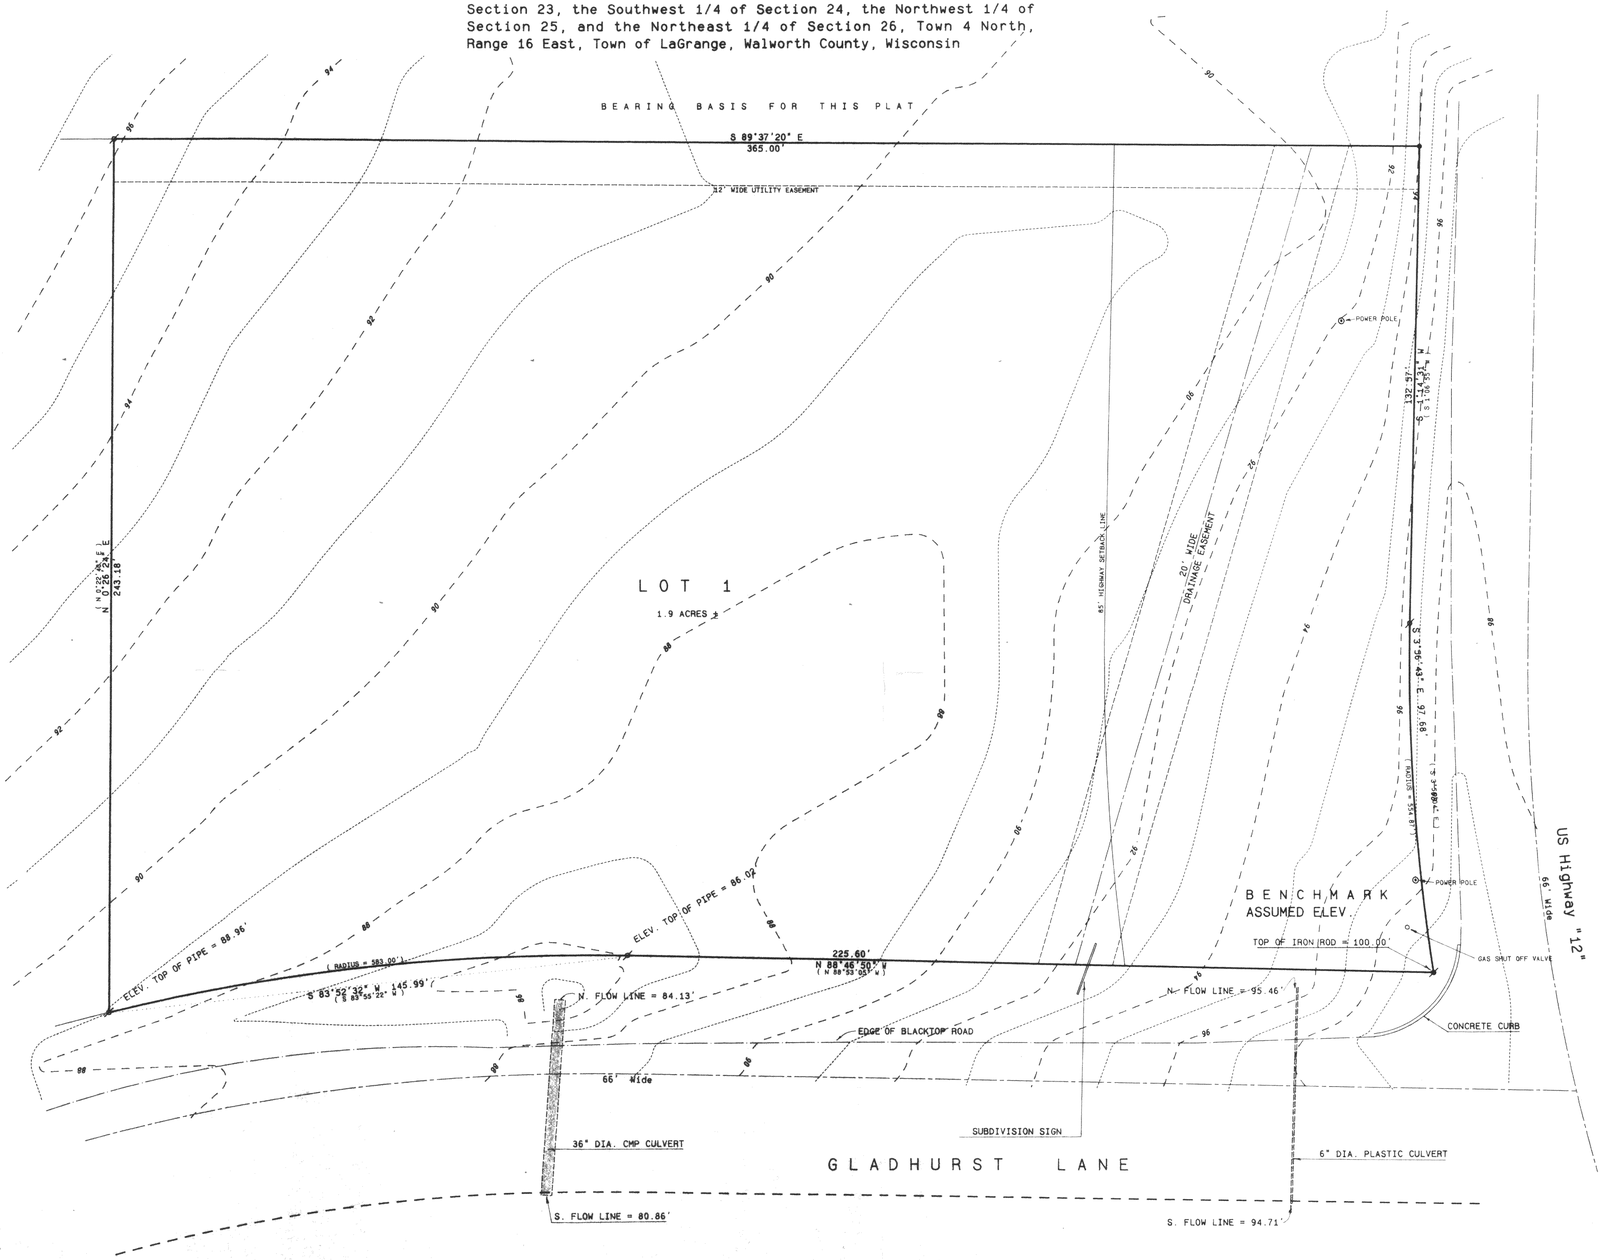

SCALE 1" = 20 FEET

ORDERED BY: LAUDERDALE LAKES MGT. DISTRICT
C/O SCOTT MASON
P.O. BOX 828
ELKHORN, WI. 53121

Legend

- FOUND IRON PIPE
- FOUND IRON ROD
- FOUND BRASS CAPPED MONUMENT
- FOUND CONCRETE MONUMENT
- CHISEL CUT IN CONCRETE
- SET IRON ROD, 24" LONG, WEIGHING 1.5 LBS./LINEAL FT., 3/4" DIA.
- SET IRON ROD, 30" LONG, WEIGHING 4.5 LBS./LINEAL FT., 1-11/16" DIA.
- [XX] RECORDED AS DIMENSION
- EXISTING FENCE

RECEIVED
AUG 30 2000

WISCONSIN
KENNETH B. ABERNATHY, JR.
S-1594
ELKHORN
WI
LAND SURVEYOR

SCALE: 1" = 20 FEET

I hereby certify that the above described property has been surveyed by me or under my direction and that the above map is a true representation thereof and shows the size and location of the property, its exterior boundaries, the location of all visible structures and dimensions of all principal buildings thereon, boundary fences, apparent easements, roadways and visible encroachments, if any.
This survey is made for the use of the present owners of the property, and also those who purchase, mortgage, or guarantee the title thereto within one year from date hereof.

Kenneth B. Abernathy Jr.

KENNETH B. ABERNATHY, JR.
WISCONSIN REGISTERED LAND SURVEYOR,
S-1594

Date: Aug. 25, 2000 **Job No.** 97.701

H6-1 416-1615