


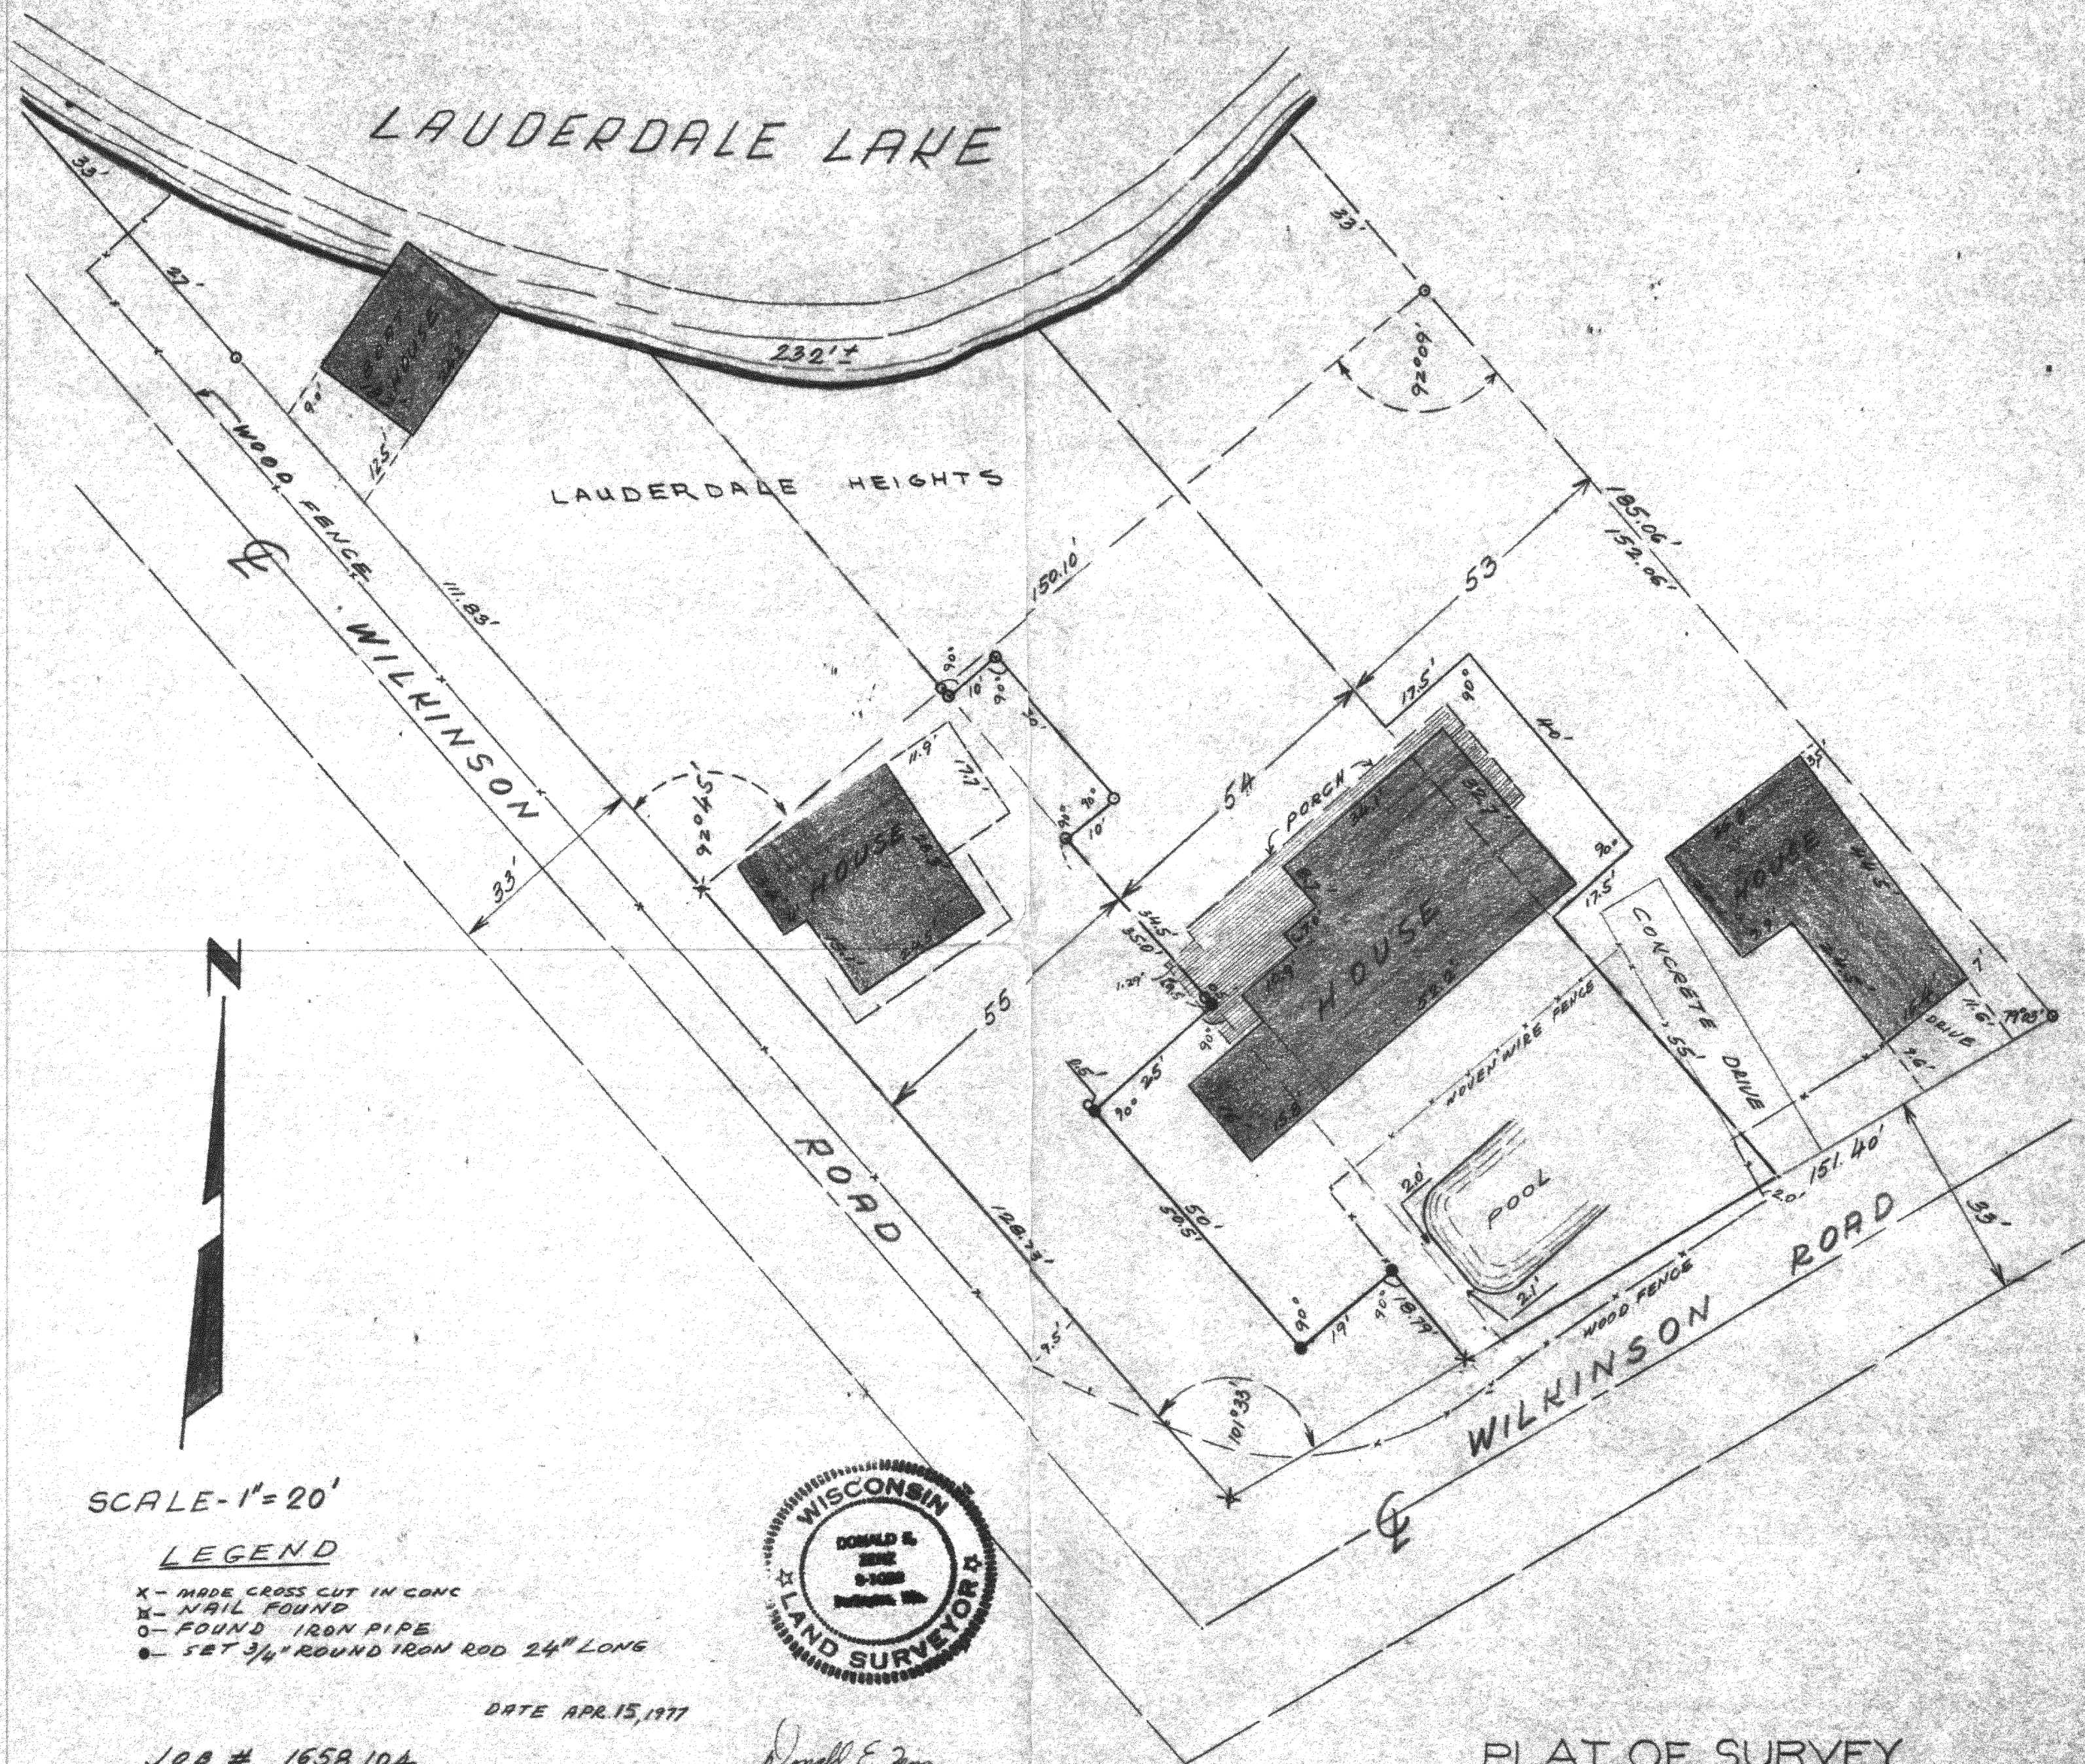

LAUDERDALE LAKE

LAUDERDALE HEIGHTS

WOOD FENCE
WILKINSON

ROAD

WILKINSON

ROAD

THE PROPERTY HEREON DESCRIBED
HAS BEEN SURVEYED UNDER MY DIRECTION
AND THE PLAT SHOWN HEREON IS A TRUE
REPRESENTATION THEREOF AND SHOWS THE
SIZE AND LOCATION OF THE PROPERTY TO
THE BEST OF MY KNOWLEDGE AND BELIEF

SCALE - 1" = 20'

LEGEND

- X - MADE CROSS CUT IN CONC
- ✕ - NAIL FOUND
- - FOUND IRON PIPE
- - SET 3/4" ROUND IRON ROD 24" LONG



DATE APR. 15, 1977
REVISED 5/27/77

JOB # 1658.104
SURVEY FOR LOUIS HILFER
707 YORK ROAD
GLENVIEW, IL. 60025

Donald E. Zenz
DONALD E. ZENZ 5-1088

PLAT OF SURVEY OF

LOT LINE ADJUSTMENT BETWEEN
LOT 54 & 55 LAUDERDALE HEIGHTS,
T4N - R16E WALWORTH COUNTY,
WISCONSIN

LOT LINE ADJUSTMENT AS RECORDED
IN DOCUMENT NOS 02345, 669307, 669002
AND 680798 AT WALWORTH COUNTY COURT HOUSE

Put on both lots

416-259

1658.104

