


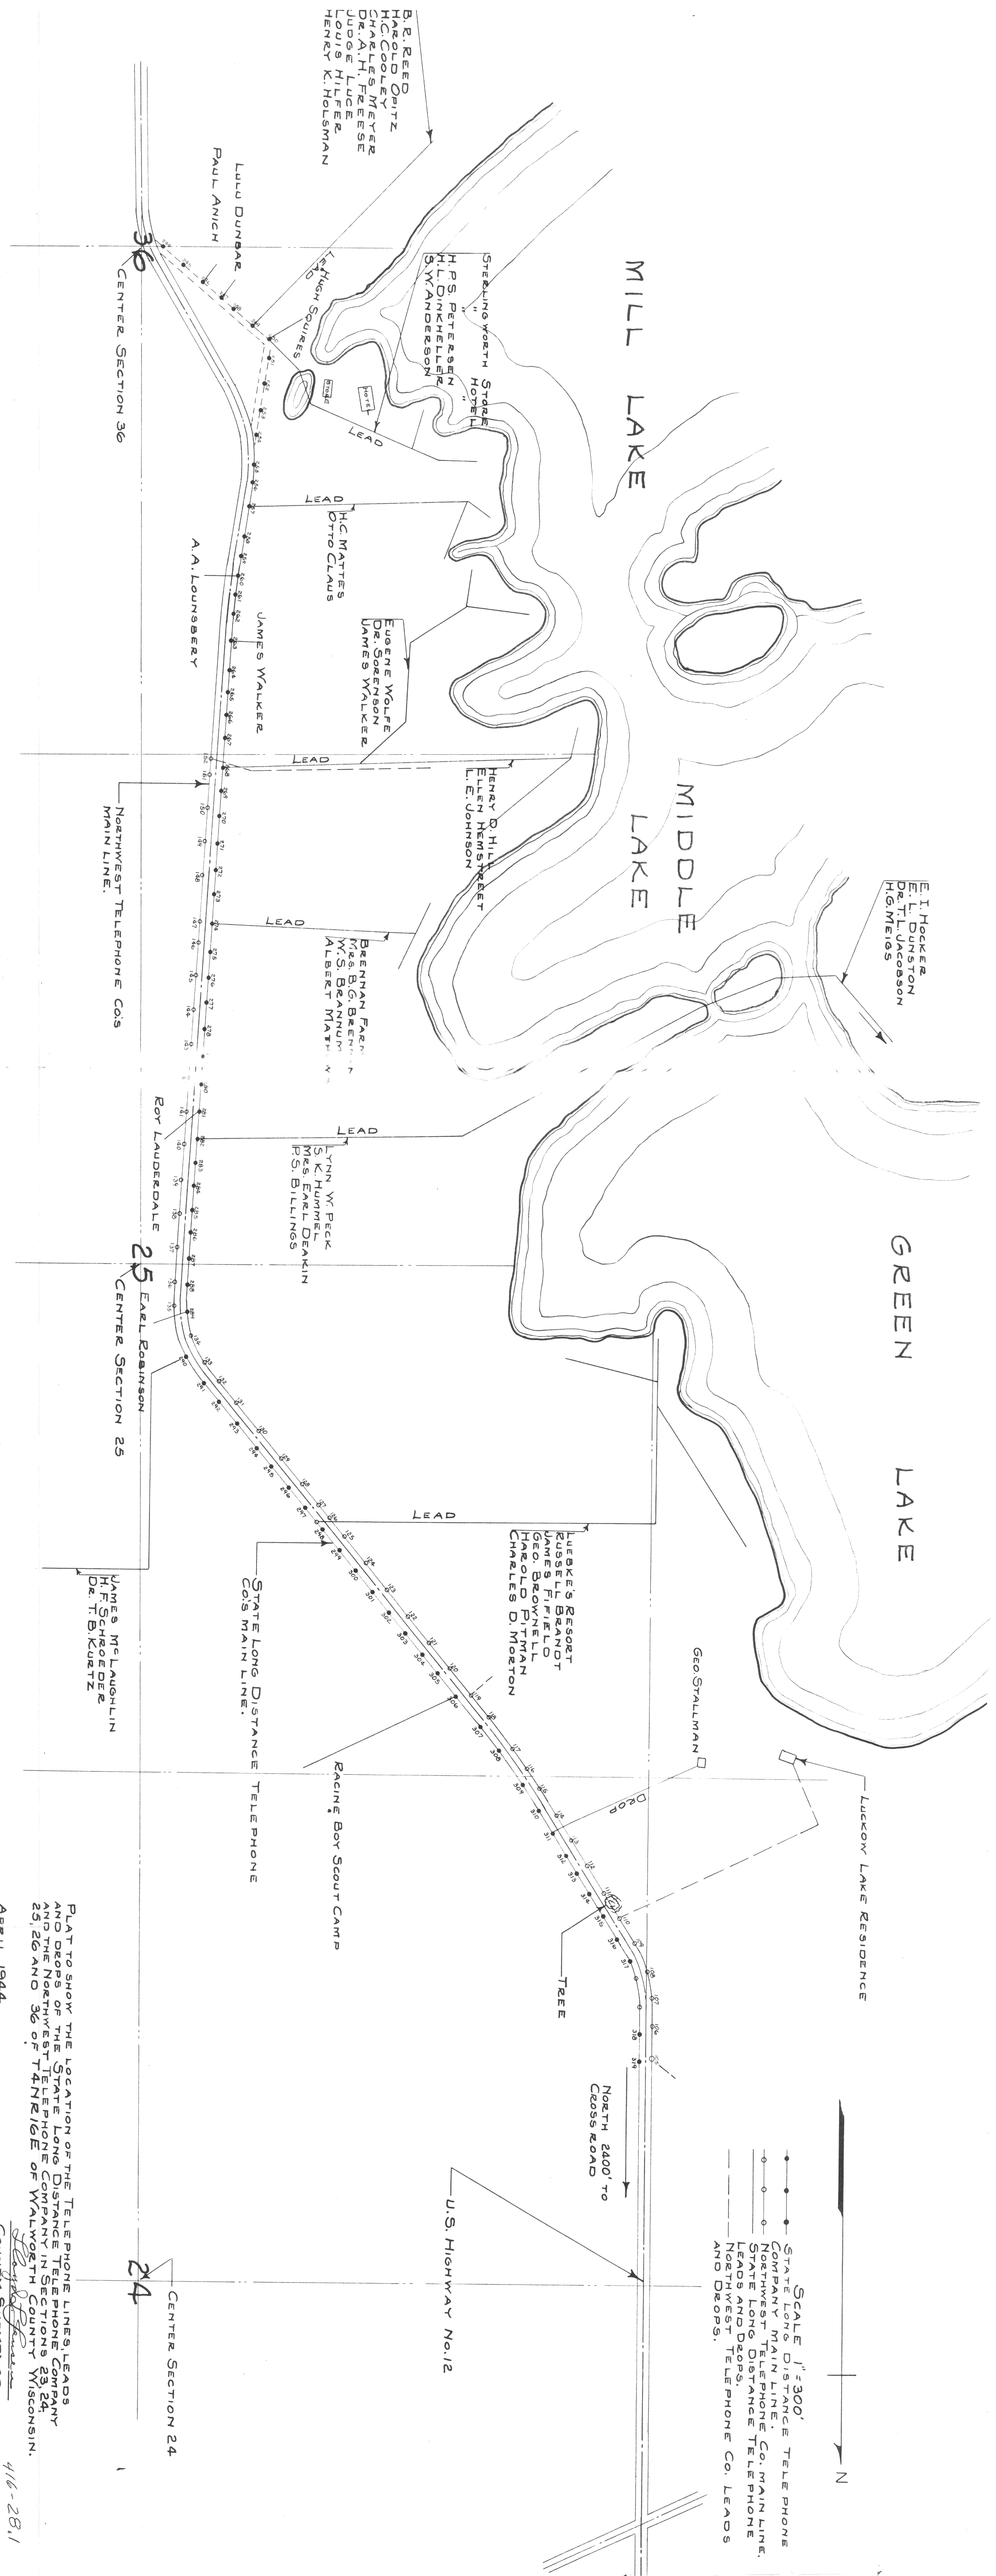

PLAT TO SHOW THE LOCATION OF THE TELEPHONE LINES, LEADS AND DROPS OF THE STATE LONG DISTANCE TELEPHONE COMPANY AND THE NORTHWEST TELEPHONE COMPANY IN SECTIONS 23, 24, 25, 26 AND 36 OF TANGIEN OF WALWORTH COUNTY WISCONSIN.

Lloyd J. Fawcett
County Surveyor

APRIL 1944

416-28.1