

Volume 562 Page 671 of the Walworth County Deeds

Lots 15, 16, 17, 18, and the West 1/2 of Lot 19 of Green Island (Deakin Isle) in the Town of LaGrange, Walworth County, Wisconsin, excepting a parcel of uniform width of 10 feet on the Northerly and Westerly side of Lot 15, extending from the lake to the line of the property formerly designated West Park, excepting therefrom those portions of the aforescribed real estate contained in the two following conveyances from Ella N. Billings to Lester O. Marholz and Elsie Marholz, husband and wife, one dated October 1, 1951 and recorded October 5, 1951 in Volume 434 of Deeds, Page 87, as Document No. 438335, Walworth County Records, and the other dated November 18, 1952, recorded November 19, 1952 in Volume 449 of Deeds, Page 413, as Document No. 448126, Walworth County Records. Also A parcel of land located in Lot 19, Green Island Subdivision in the Southeast 1/4 of Section 26, T 4 N., R. 16 E., Walworth County, Wisconsin and described as follows, to-wit: Commencing at the Northeast corner of said Lot 19; thence Westerly 7.5 feet along the North line of said Lot 19; thence Southerly 94.85 feet along a line through the center of said Lot 19 to the place of beginning; thence continue Southerly 93.85 feet on said line to the shore of Middle Lake; thence Easterly 6.4 feet along said shore; thence Northerly 93.39 feet to the place of beginning.

Volume 449 Page 413 of the Walworth County Deeds

Commencing at an iron stake that is 59.0 feet S. 12° 10' W. of the northeast corner of Lot 17 of the plat of Green Island (Deakin Isle) in Section 26, Town 4 north, Range 16 east of the 4th Principal Meridian, thence 36.45 feet S. 81° 35' W., to an iron stake, thence 78.5 feet S. 60° 02' W., to the shore of the channel between Green Lake and Middle Lake, thence southeasterly along the shore of said channel to a point that is 115.0 feet S. 56° W., of the place of beginning, thence 115.0 feet N. 56° E. to the place of beginning.

Volume 434 Page 87 of the Walworth County Deeds

Commencing at an iron stake at the northeast corner of Lot 14, of the plat of Green Island, (Deakin Isle) in section 26, Town 4 North, Range 16 east of the 4th Principal Meridian, thence South 33° 50' East 40.0 feet along the easterly lines of Lots 14 and 15 of said plat of Green Island, to an iron stake, thence North 86° 15' East 30.0 feet along the easterly lines of Lots 16 and 17 of said plat of Green Island to an iron stake the northeasterly corner of Lot 18 of said plat of Green Island, thence South 12° 10' West 59.0 feet to an iron stake, thence South 81° 35' West 36.45 feet to an iron stake, thence South 60° 02' West, 78.5 feet along a line which divides the boat house now located on Lot 15 of said plat of Green Island, into two equal halves, to a point on the shore of the channel which lies between Green Lake and Middle Lake, thence northwesterly along the shore of said channel 82.5 feet to an intersection with the northerly line of the aforesaid Lot 14, thence North 56° 48' East, along the northerly line of said Lot 14, to the place of beginning, 138.00 feet.

WORK ORDERED BY: NORMAN JOHNSON


Legend for Metal Monuments

- = Iron Pipe Survey Monument -- Found
- = Iron Pipe Survey Monument -- Set
- ⊙ = Iron Rod Survey Monument -- Found
- (xxx) = Record Dimension -- either from deeds or surveys of record

I HEREBY CERTIFY that this Plat of Survey is a true and accurate representation of the lot lines to the best of my professional knowledge and belief.

Dated this 11th day of June 1979

Robert A. Farris
Robert A. Farris RLS # 1293

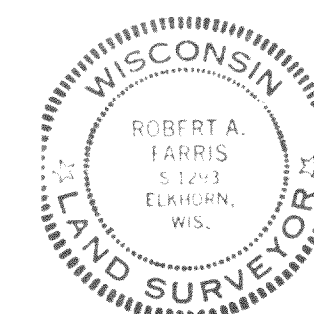

PROJECT NO. 1538

416-288-F