

LAND-MARK SURVEYING


Mark L. Miritz
Wisconsin Professional Land Surveyor S-2582

N9330 Knuteson Drive
Whitewater, WI 53190
Phone: (262) 495-3284
MARKMIRITZ@
LAND-MARKSURVEYING.COM

PLAT OF SURVEY

LOT 46 OF FROEDTERT'S GREEN LAKE PARK,
A SUBDIVISION LOCATED IN SECTION 26,
TOWN 4 NORTH, RANGE 16 EAST, LAGRANGE
TOWNSHIP, WALWORTH COUNTY, WISCONSIN.

ORDERED BY:
JERRY KROUPA
KEEFE REAL ESTATE
204 E. COMMERCE CT.
ELKHORN, WI 53121

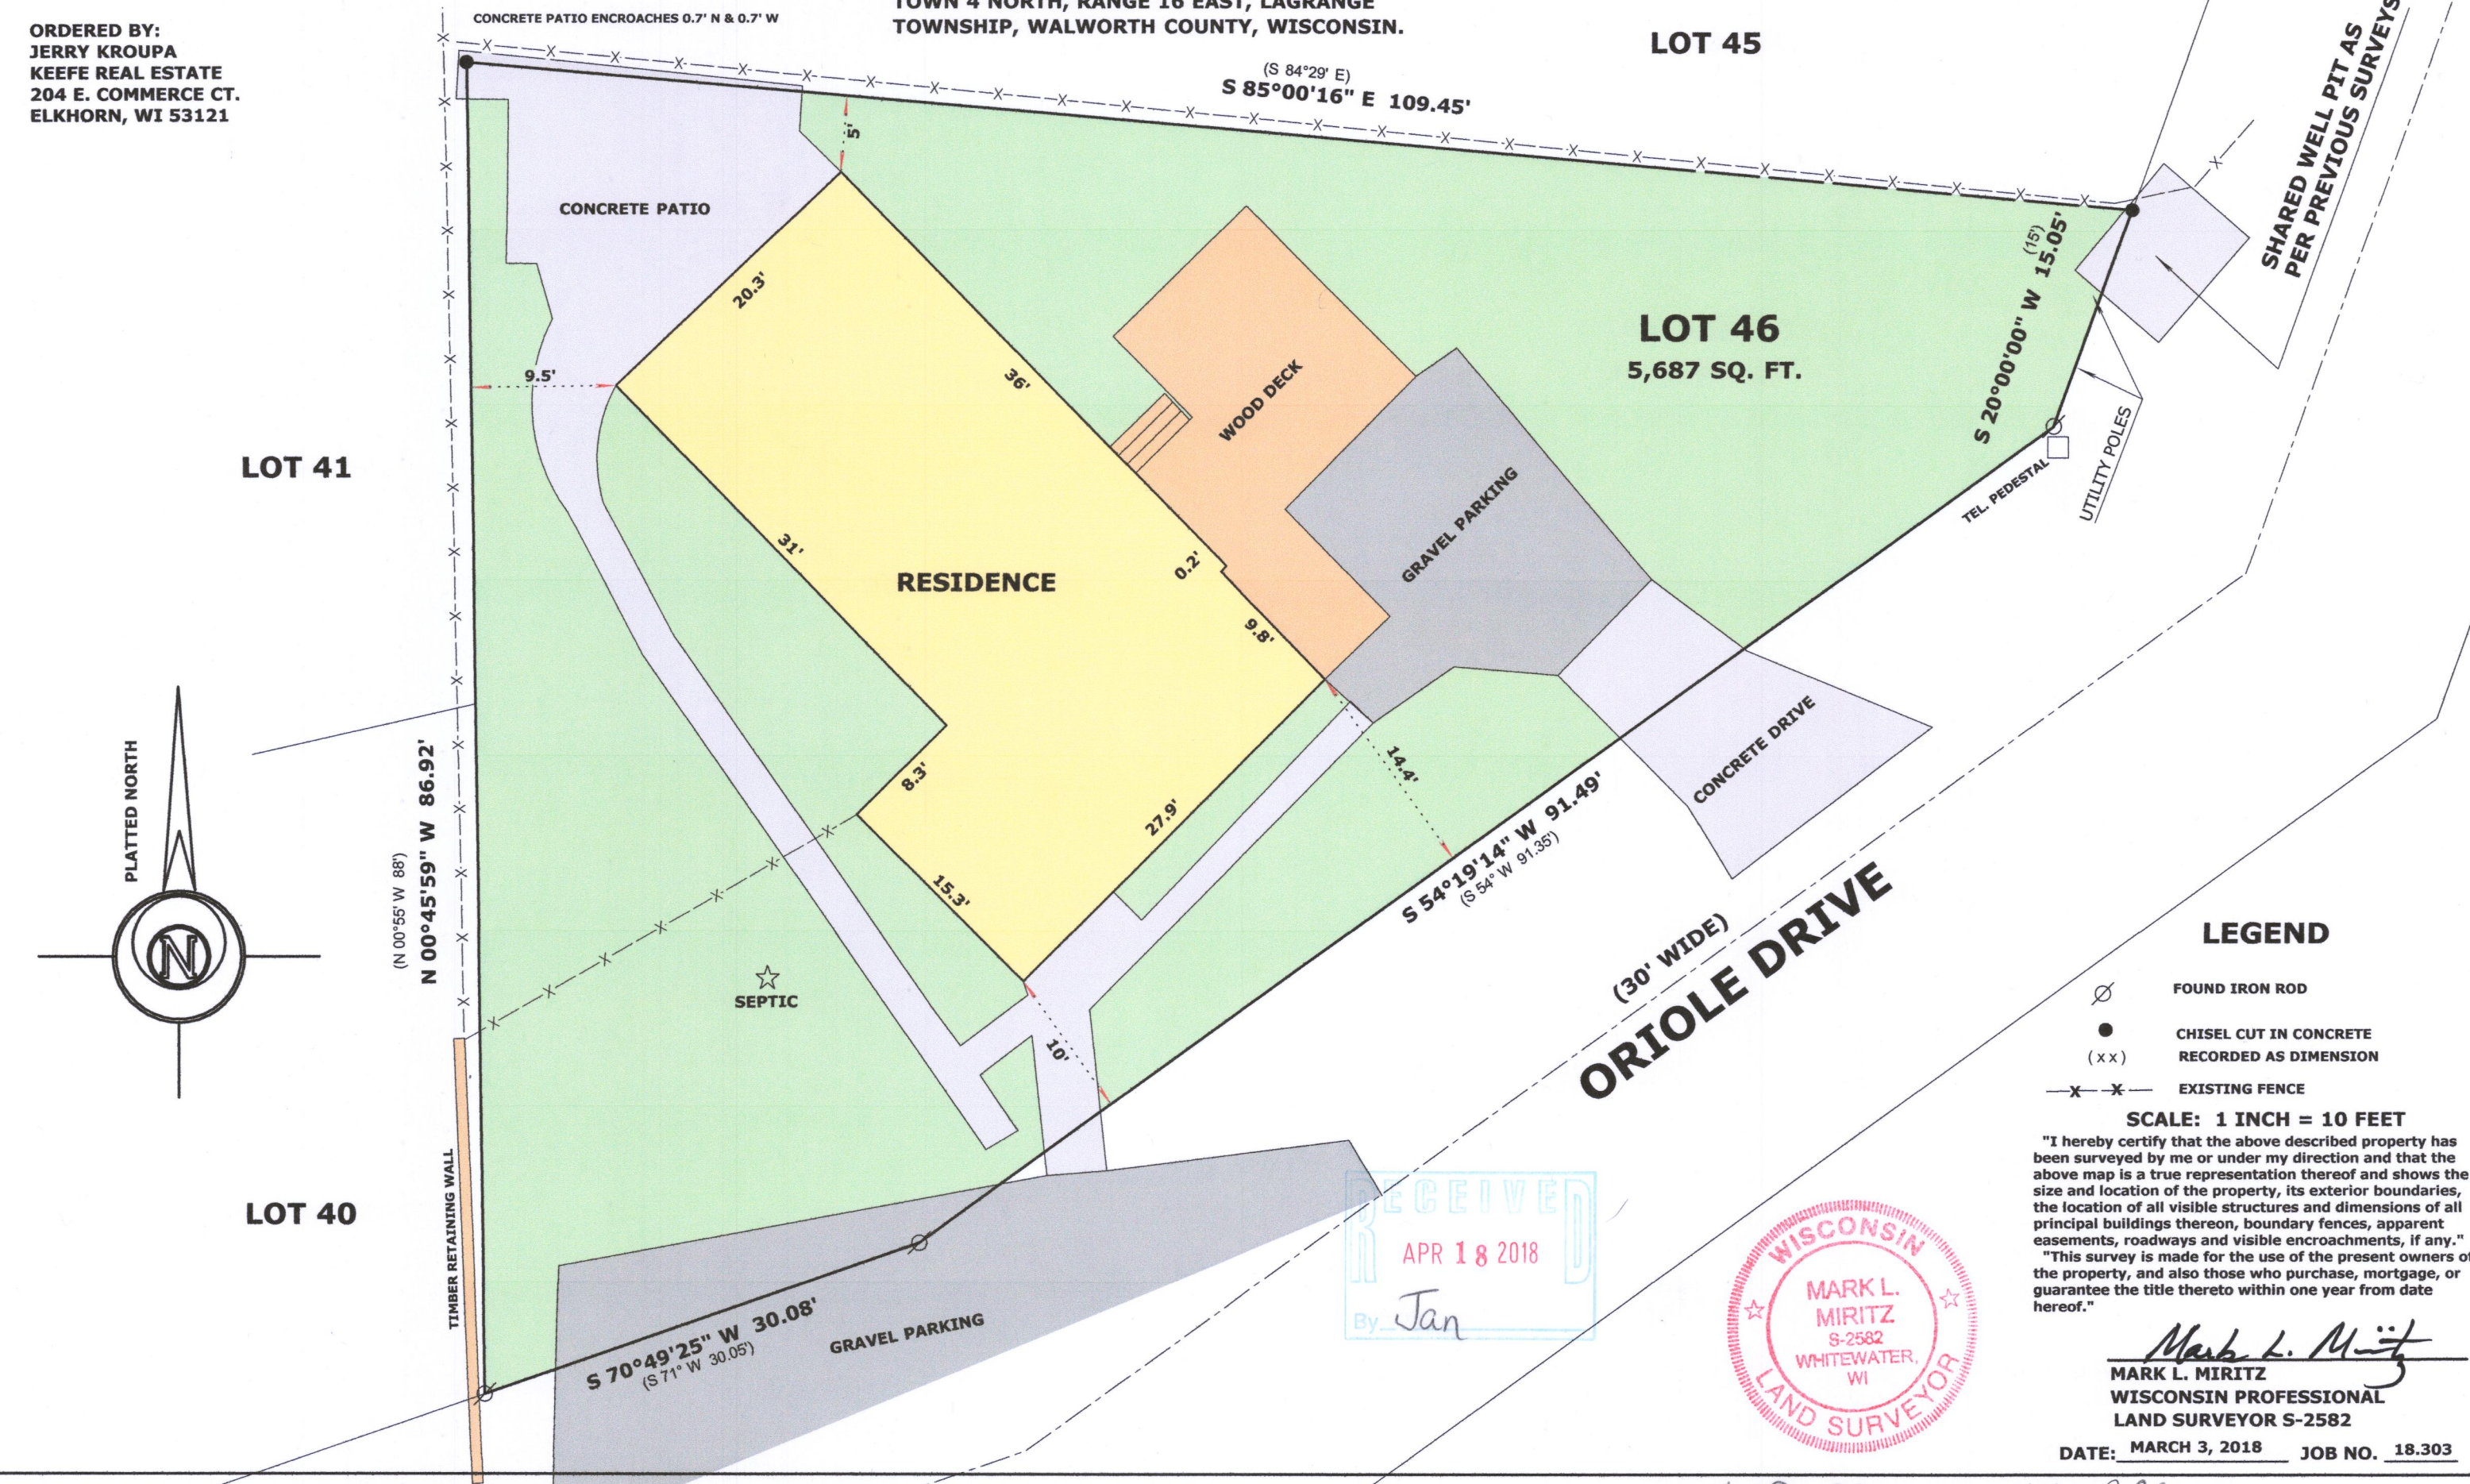

HFP-33 416-2992