

PLAT OF SURVEY & TOPOGRAPHIC MAPPING WEST HALF OF LOT 1, LOT 2 & PART OF LOT 3 OF OAK PARK, A SUBDIVISION

LOCATED IN PART OF THE SW 1/4 OF THE SE 1/4
OF SECTION 26, TOWN 4 NORTH, RANGE 16 EAST,
TOWN OF LAGRANGE, WALWORTH COUNTY, WISCONSIN

ASSIGNED N. LINE OF LANDS SURVEYED
N 74°45'00" E




PLAT OF SURVEY &
TOPOGRAPHIC MAPPING
WS495 OAK PARK ROAD
ELKHORN, WI 53121

WORK ORDERED BY -
R. LYNAM & CO. INC.
P.O. BOX 257
FONTANA, WI 53125

FARRIS, HANSEN & ASSOCIATES, INC.
ENGINEERING - ARCHITECTURE - SURVEYING
7 RIDGWAY COURT P.O. BOX 437
ELKHORN, WISCONSIN 53121
OFFICE: (262) 723-2098 FAX: (262) 723-5886

REVISIONS

PROJECT NO.
10029
DATE:
09/26/2018
SHEET NO.
1 OF 1

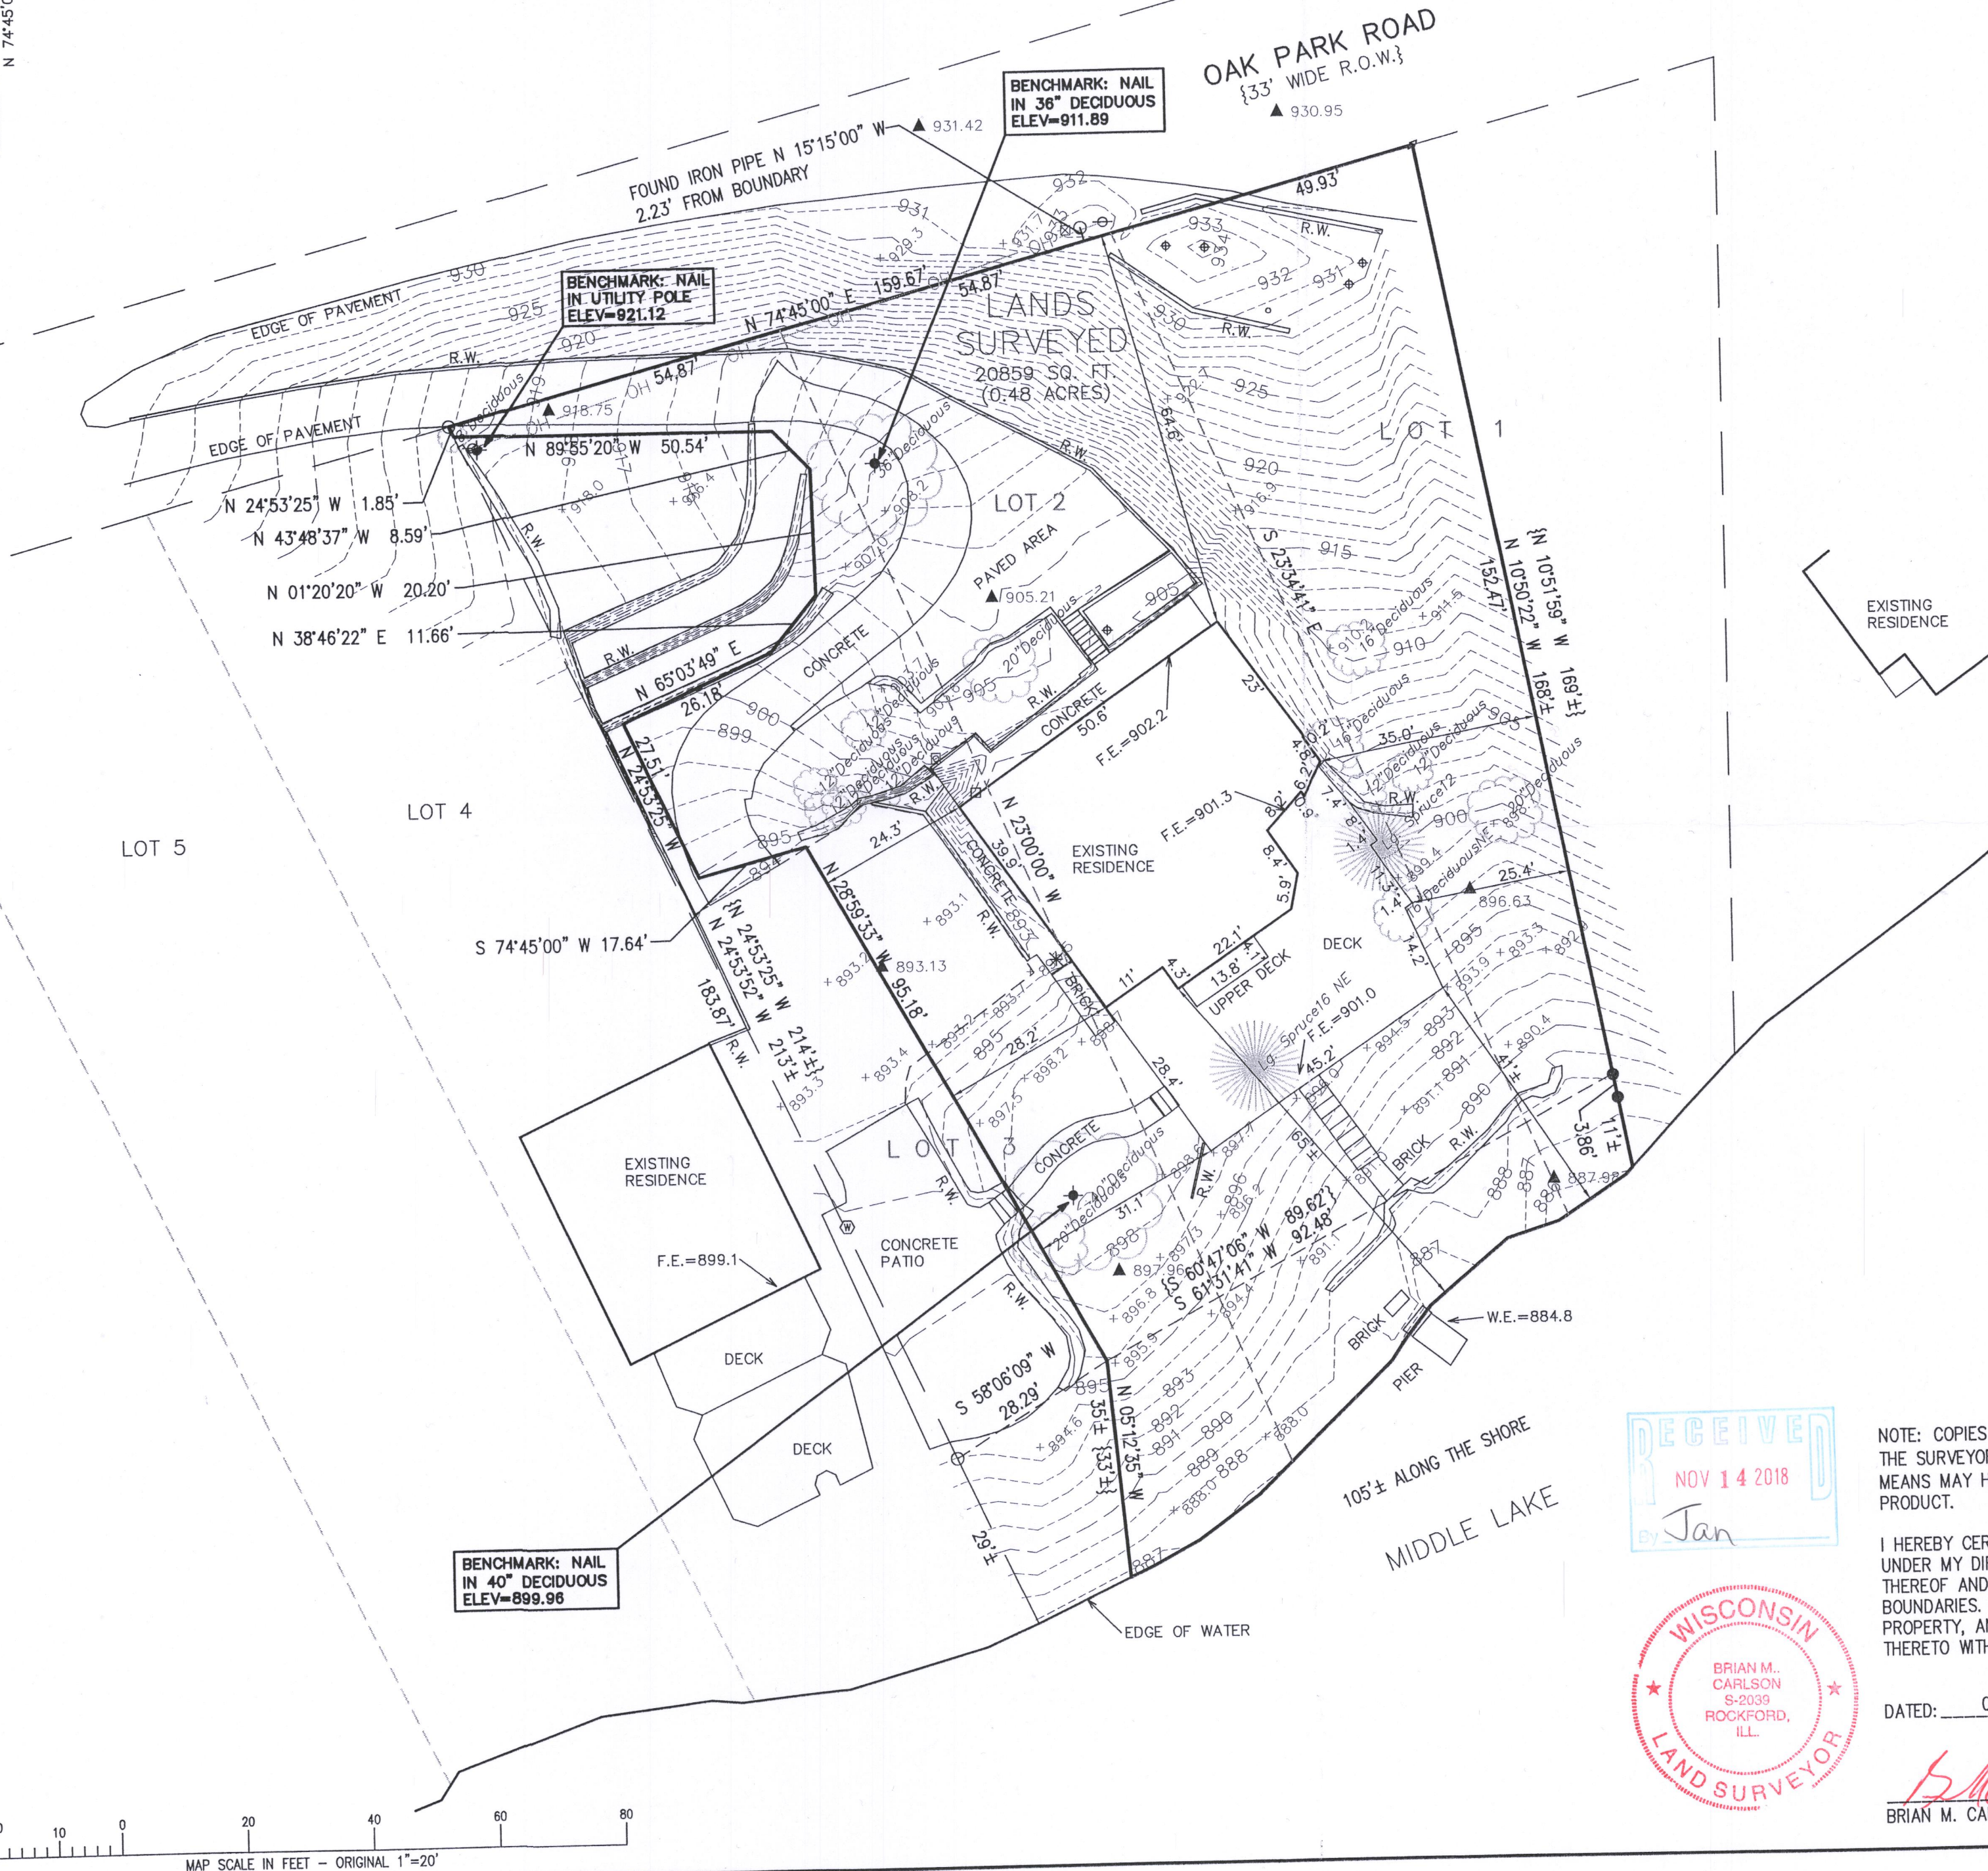

HOP-2 416-3045