


Plat of Survey

of


Lot 1 in Block 14 of Cool Hill Park Addition No. 2,

a subdivision located in the Southeast 1/4 of the Southeast 1/4 of Section 34, Town 4 North, Range 16 East, Town of LaGrange, Walworth County, Wisconsin.

Surveyed for: Kirk VanderMeiden
N7337 Nine Indians Trail
Elkhorn, Wisconsin. 53121

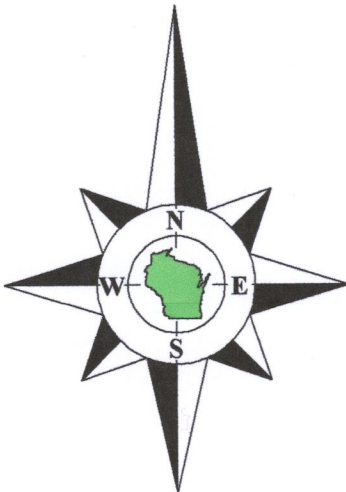

Bearings referenced to the plat of Cool Hill Park Addition No. 2 as shown on prior surveys.

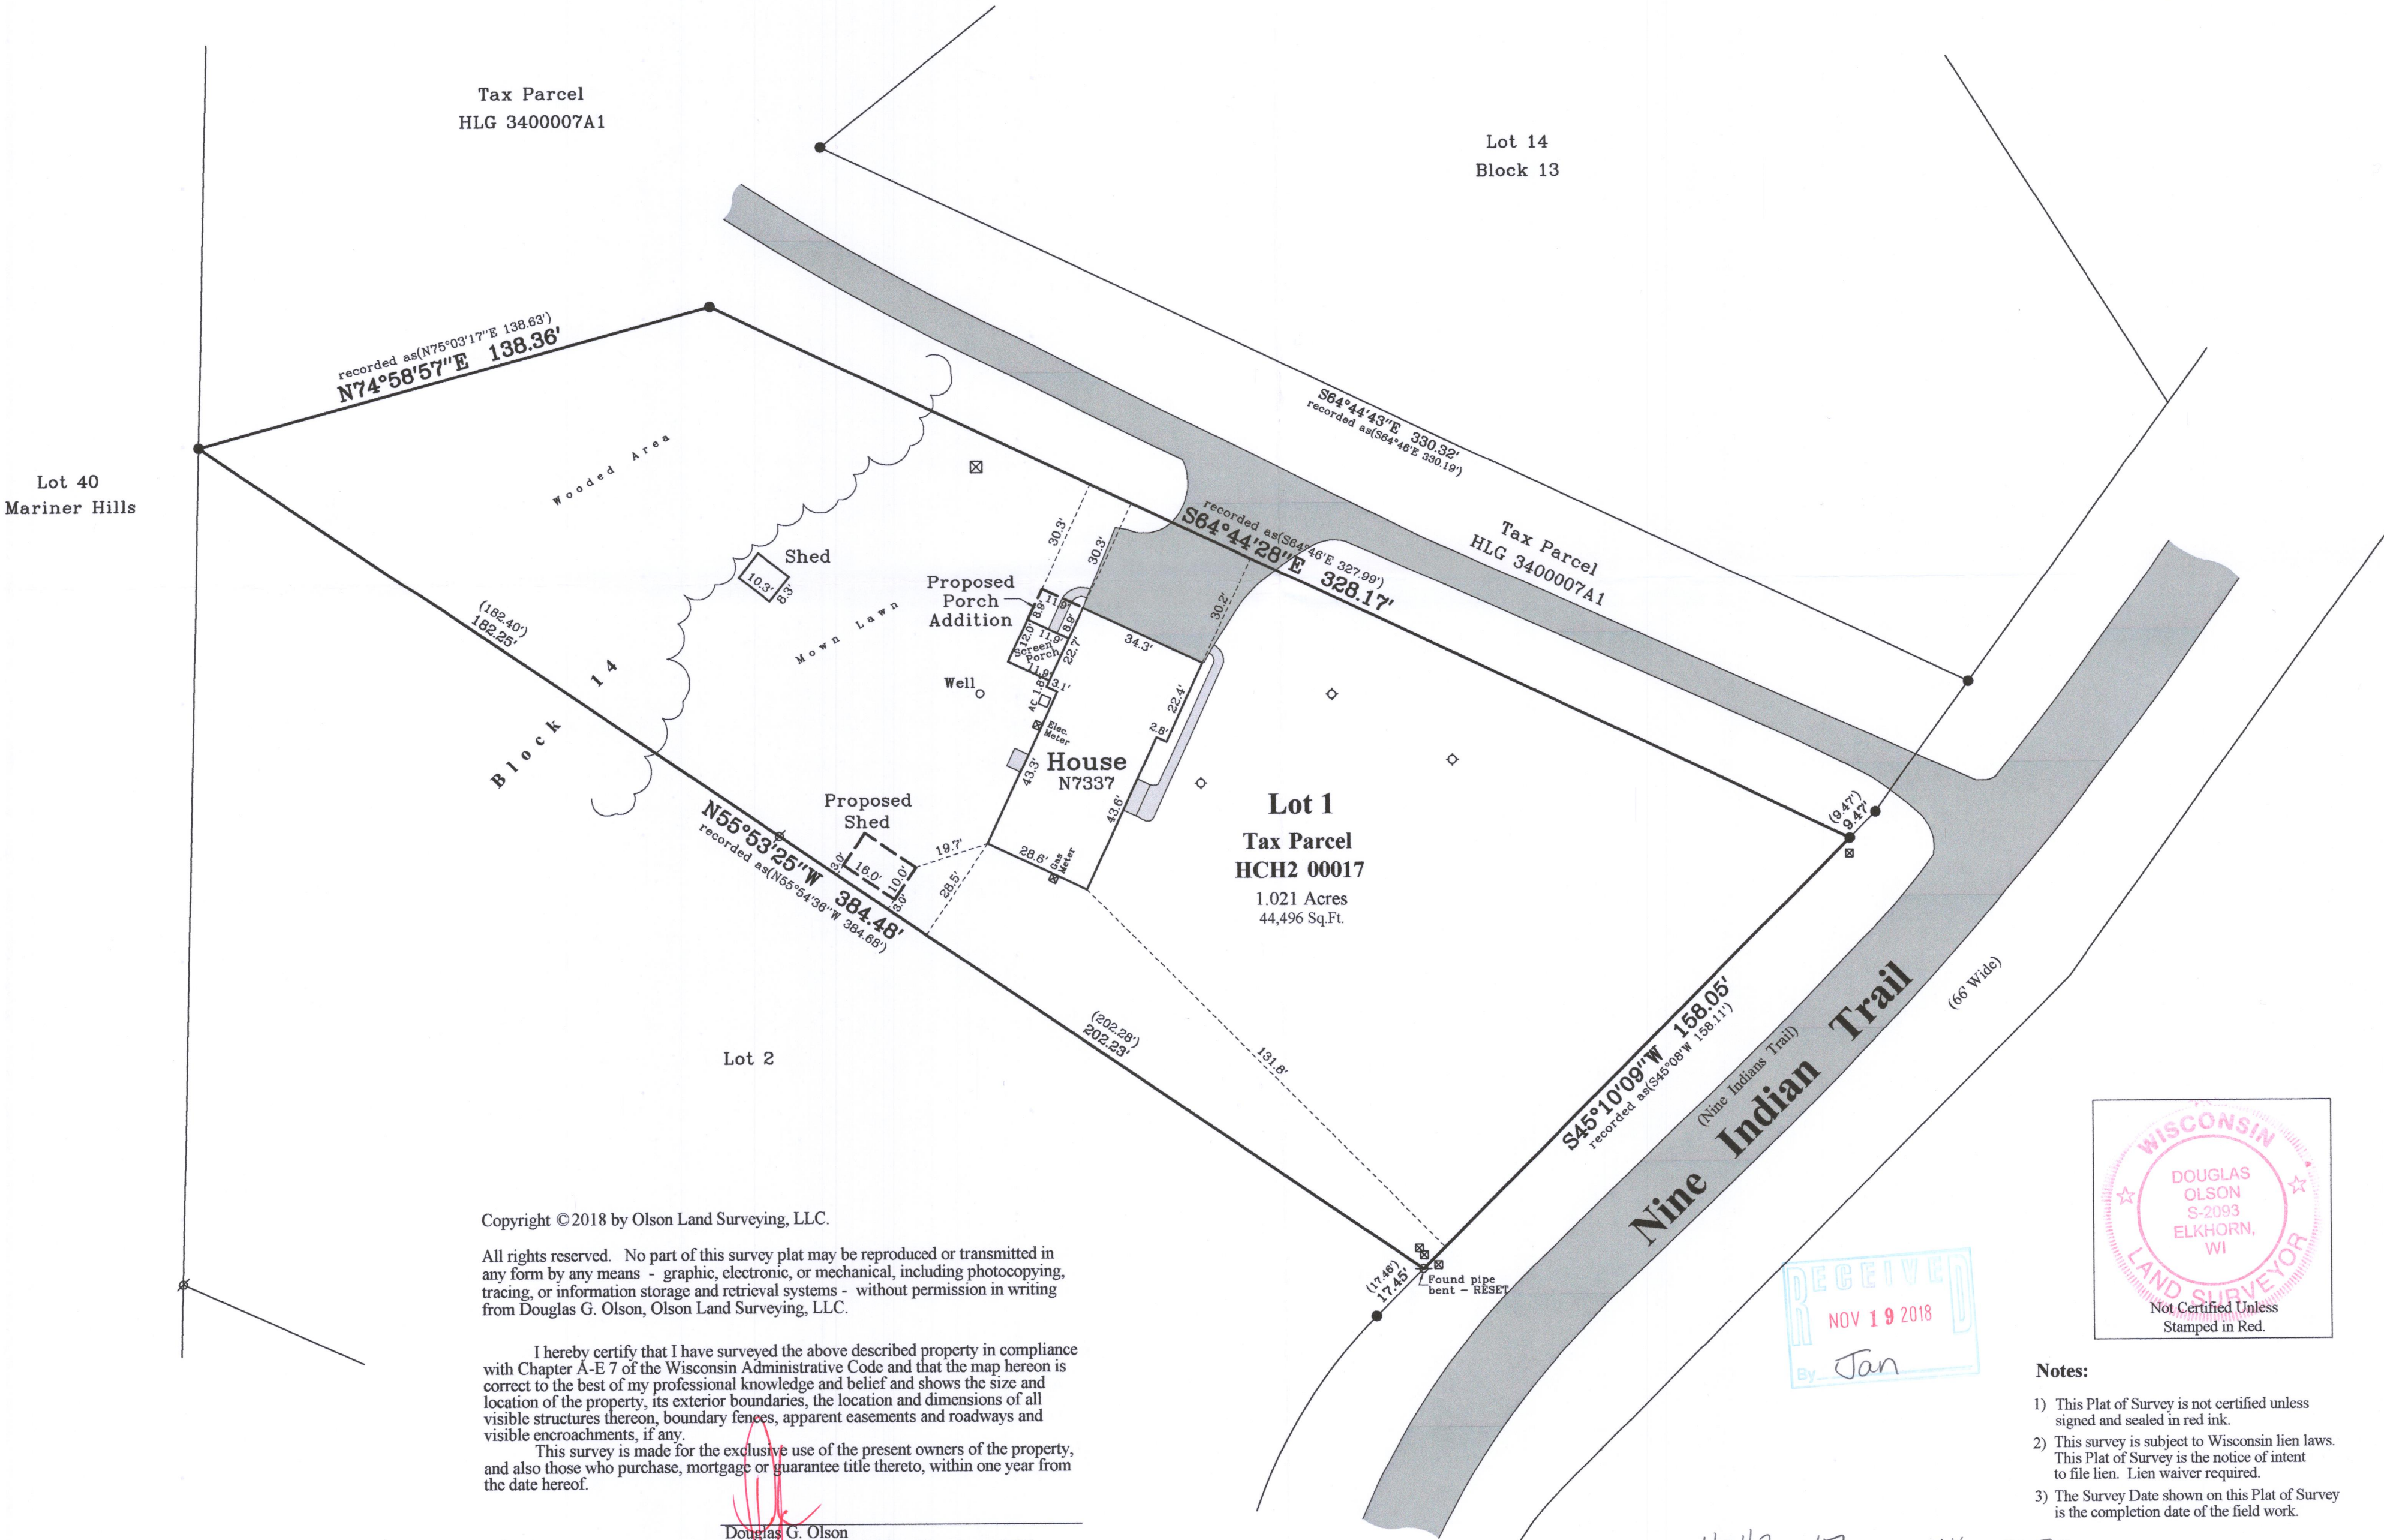

Copyright ©2018 by Olson Land Surveying, LLC.

All rights reserved. No part of this survey plat may be reproduced or transmitted in any form by any means - graphic, electronic, or mechanical, including photocopying, tracing, or information storage and retrieval systems - without permission in writing from Douglas G. Olson, Olson Land Surveying, LLC.

I hereby certify that I have surveyed the above described property in compliance with Chapter A-E 7 of the Wisconsin Administrative Code and that the map hereon is correct to the best of my professional knowledge and belief and shows the size and location of the property, its exterior boundaries, the location and dimensions of all visible structures thereon, boundary fences, apparent easements and roadways and visible encroachments, if any.

This survey is made for the exclusive use of the present owners of the property, and also those who purchase, mortgage or guarantee title thereto, within one year from the date hereof.

Douglas G. Olson
Wisconsin Professional Land Surveyor - 2093

Notes:

- 1) This Plat of Survey is not certified unless signed and sealed in red ink.
- 2) This survey is subject to Wisconsin lien laws. This Plat of Survey is the notice of intent to file lien. Lien waiver required.
- 3) The Survey Date shown on this Plat of Survey is the completion date of the field work.

Survey Date: July 2, 2018.

Revisions: No. 1 - Proposed Porch Addition
No. 2 - Proposed Shed
No. 3 - Moved

Scale in Feet

1" = 30'

0' 15' 30' 60' 90'

45 South Wisconsin Street | P.O. Box 322
Elkhorn, Wisconsin. 53121
Telephone: (262) 723-3434
Facsimile: (262) 723-8044
Email: doug@olsonsurveying.com
Website: www.olsonsurveying.com

OLSON

LAND SURVEYING, LLC

Rural | Residential | Commercial

Legend of Symbols & Abbreviations

N North
S South
E East
W West
Inches
Feet
Distances
Minutes
Degrees
Recorded Information
Found Iron Pipe 1-3/16" dia.
Found Iron Rod 1/2" dia.
Found Pipe bent - RESET

Sheet 1 of 1 Sheets

Drawing Name:

Job Reference Number

2018.084

2018.084