


DUNHAM SURVEYING, S.C.
SURVEYING & SUBDIVIDING
DELAVER, WISCONSIN 53115

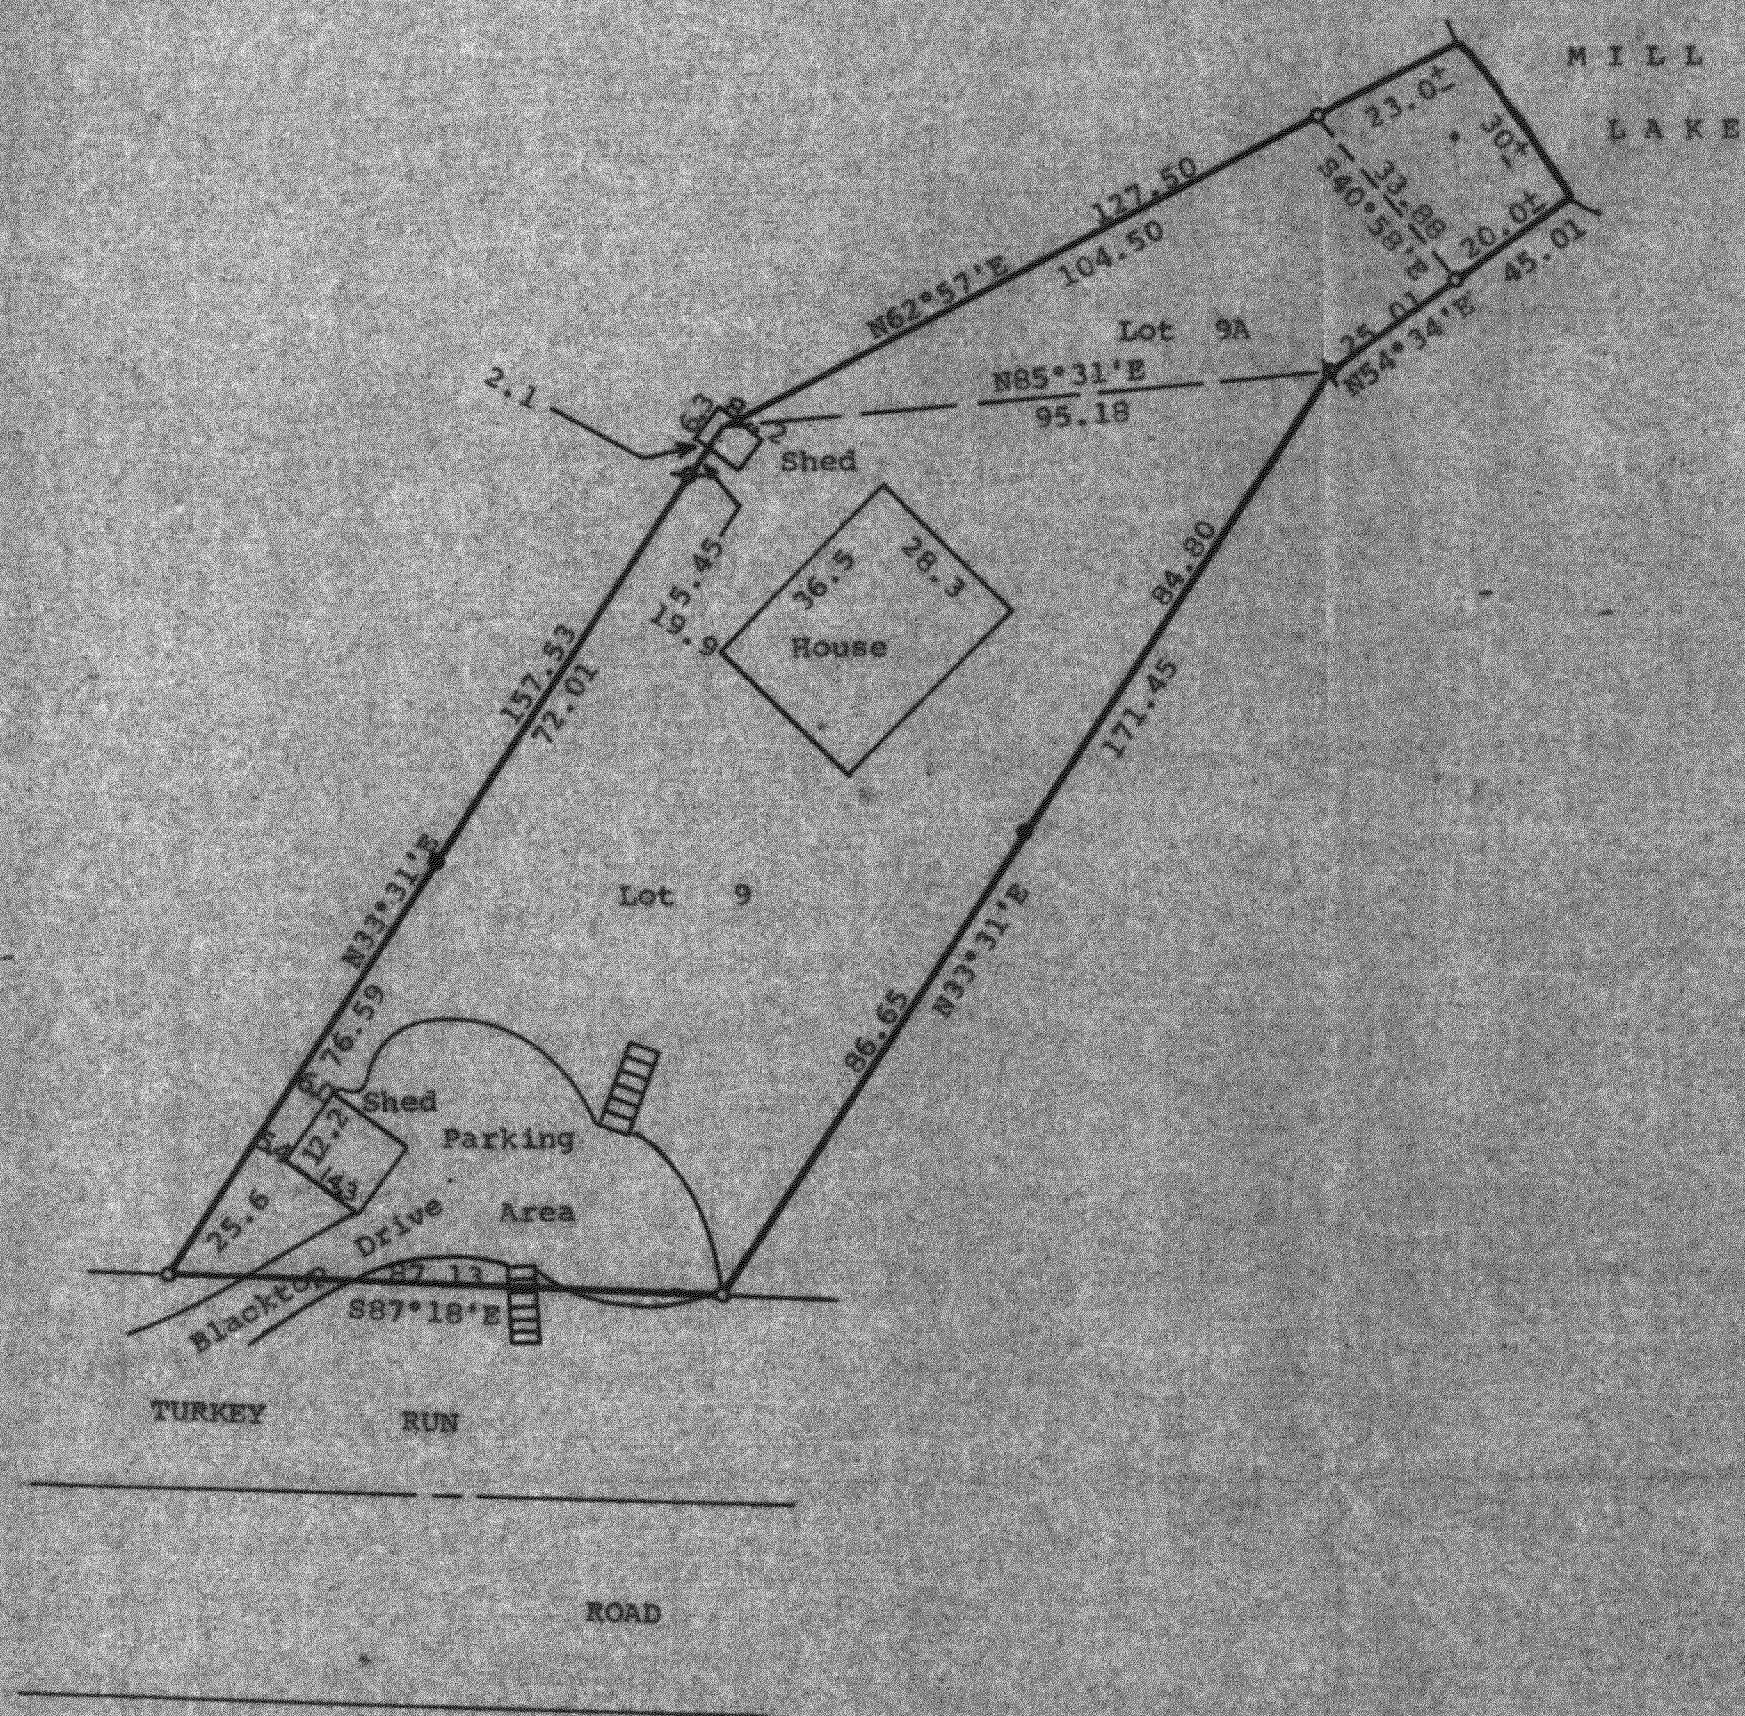

Scale - 1" = 30'
 ● = 1 1/2" Dia. Iron Pipe Found
 ○ = 1" Dia. Iron Pipe Found
 ⊕ = 3/4" Dia. Iron Pipe Found
 ⊗ = 3/4"x24" Iron Pipe Set

Bearings used are those of record.


Survey Ordered By:
 Kenosha Savings and Loan Association
 410 Broad Street
 Lake Geneva, Wisconsin 53147

STATE OF WISCONSIN)
 COUNTY OF WALWORTH) SS

I, George T. Dunham, Surveyor, certify that I have surveyed the property described as follows:

Lots 9 and 9A of Arrowhead Park, a subdivision located in Government Lot 3 in the Northwest 1/4 of the Southeast 1/4 of Section 35, T4N, R16E, Walworth County, Wisconsin, and that the map shown hereon is a correct representation thereof and shows the size and location of the property, its exterior boundaries, the location of all visible structures and dimensions of all principal buildings thereon, boundary fences, apparent easements, roadways and visible encroachments, if any, and that I have surveyed the property hereon described according to the official records, to the best of my knowledge and belief.

March 17, 1988.

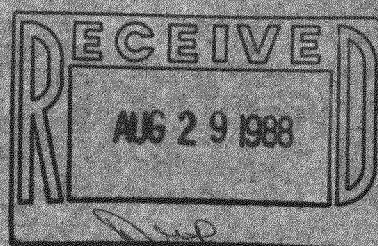

George T. Dunham
 George T. Dunham, Surveyor

