


LOCATION OF PROPERTY

DESCRIPTION OF PROPERTY

LOTS 17 & 18, BIRK, THAN'S LAND,
WALWORTH COUNTY, WISCONSIN.

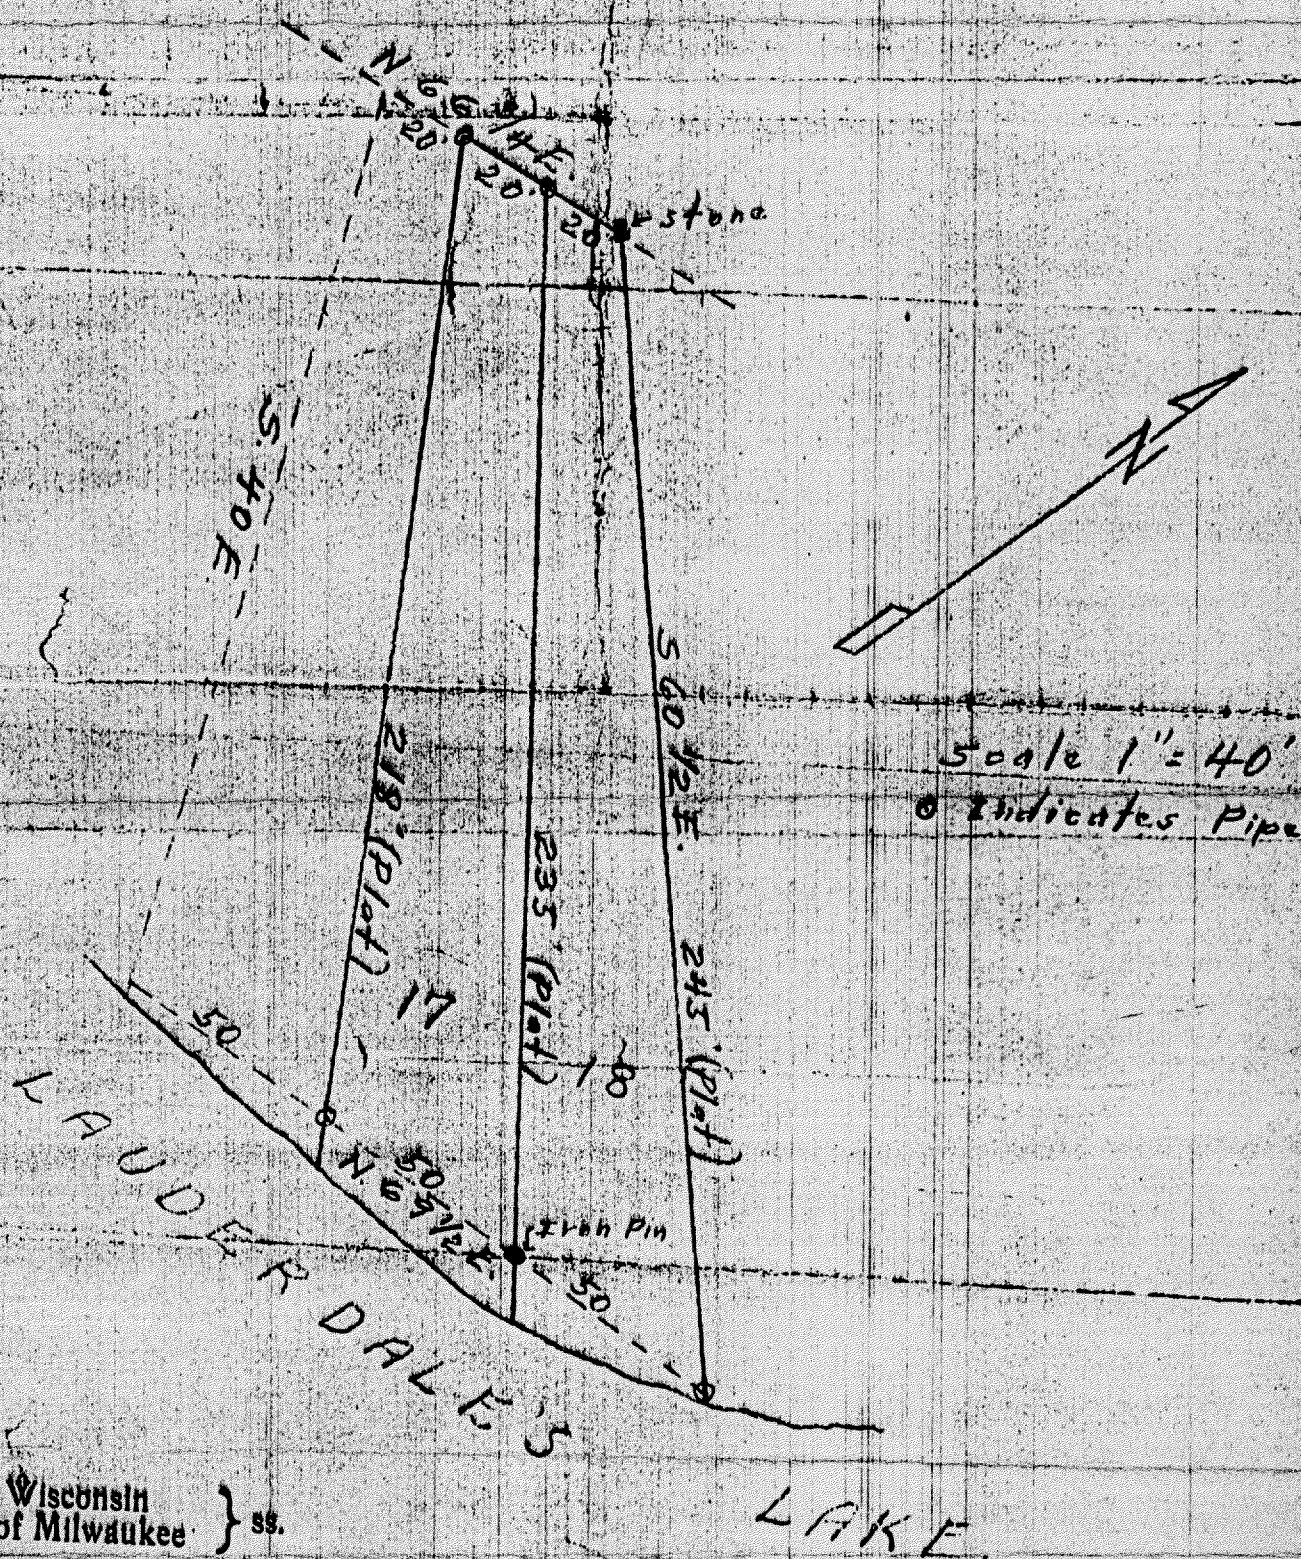


State of Wisconsin } ss.
County of Milwaukee }

I hereby certify that the above survey is a true representation of the lot lines thereof.

I further certify that I have procured the official description from official records.

Date of Survey, Nov. 5, 1950.

Surveyor

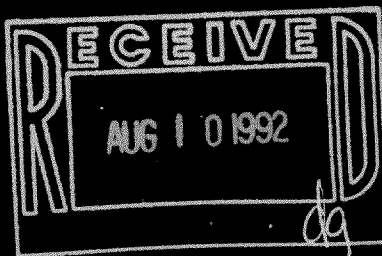

414-835

HTL-7