PLAT OF SURVEY

OF PART OF LOTS 19,20,21,22 GREEN ISLAND LOCATED IN SECTION 26, T4N, R16E, WALWORTH COUNTY, WISCONSIN. AS DESCRIBED IN VOLUME 572, PAGE 399 OF DEEDS, DOCUMENT NO. 534607

JENSEN SURVEYING & MAPPING S.C.

PO BOX 322
ELKHORN WI. 53121
(414) 723-3434

SURVEYED BY: THOMAS P.A. JENSEN
R.L.S. #1084

SURVEYED FOR: COLONY REALITY
16 E. WALWORTH
ELKHORN, WI. 53121

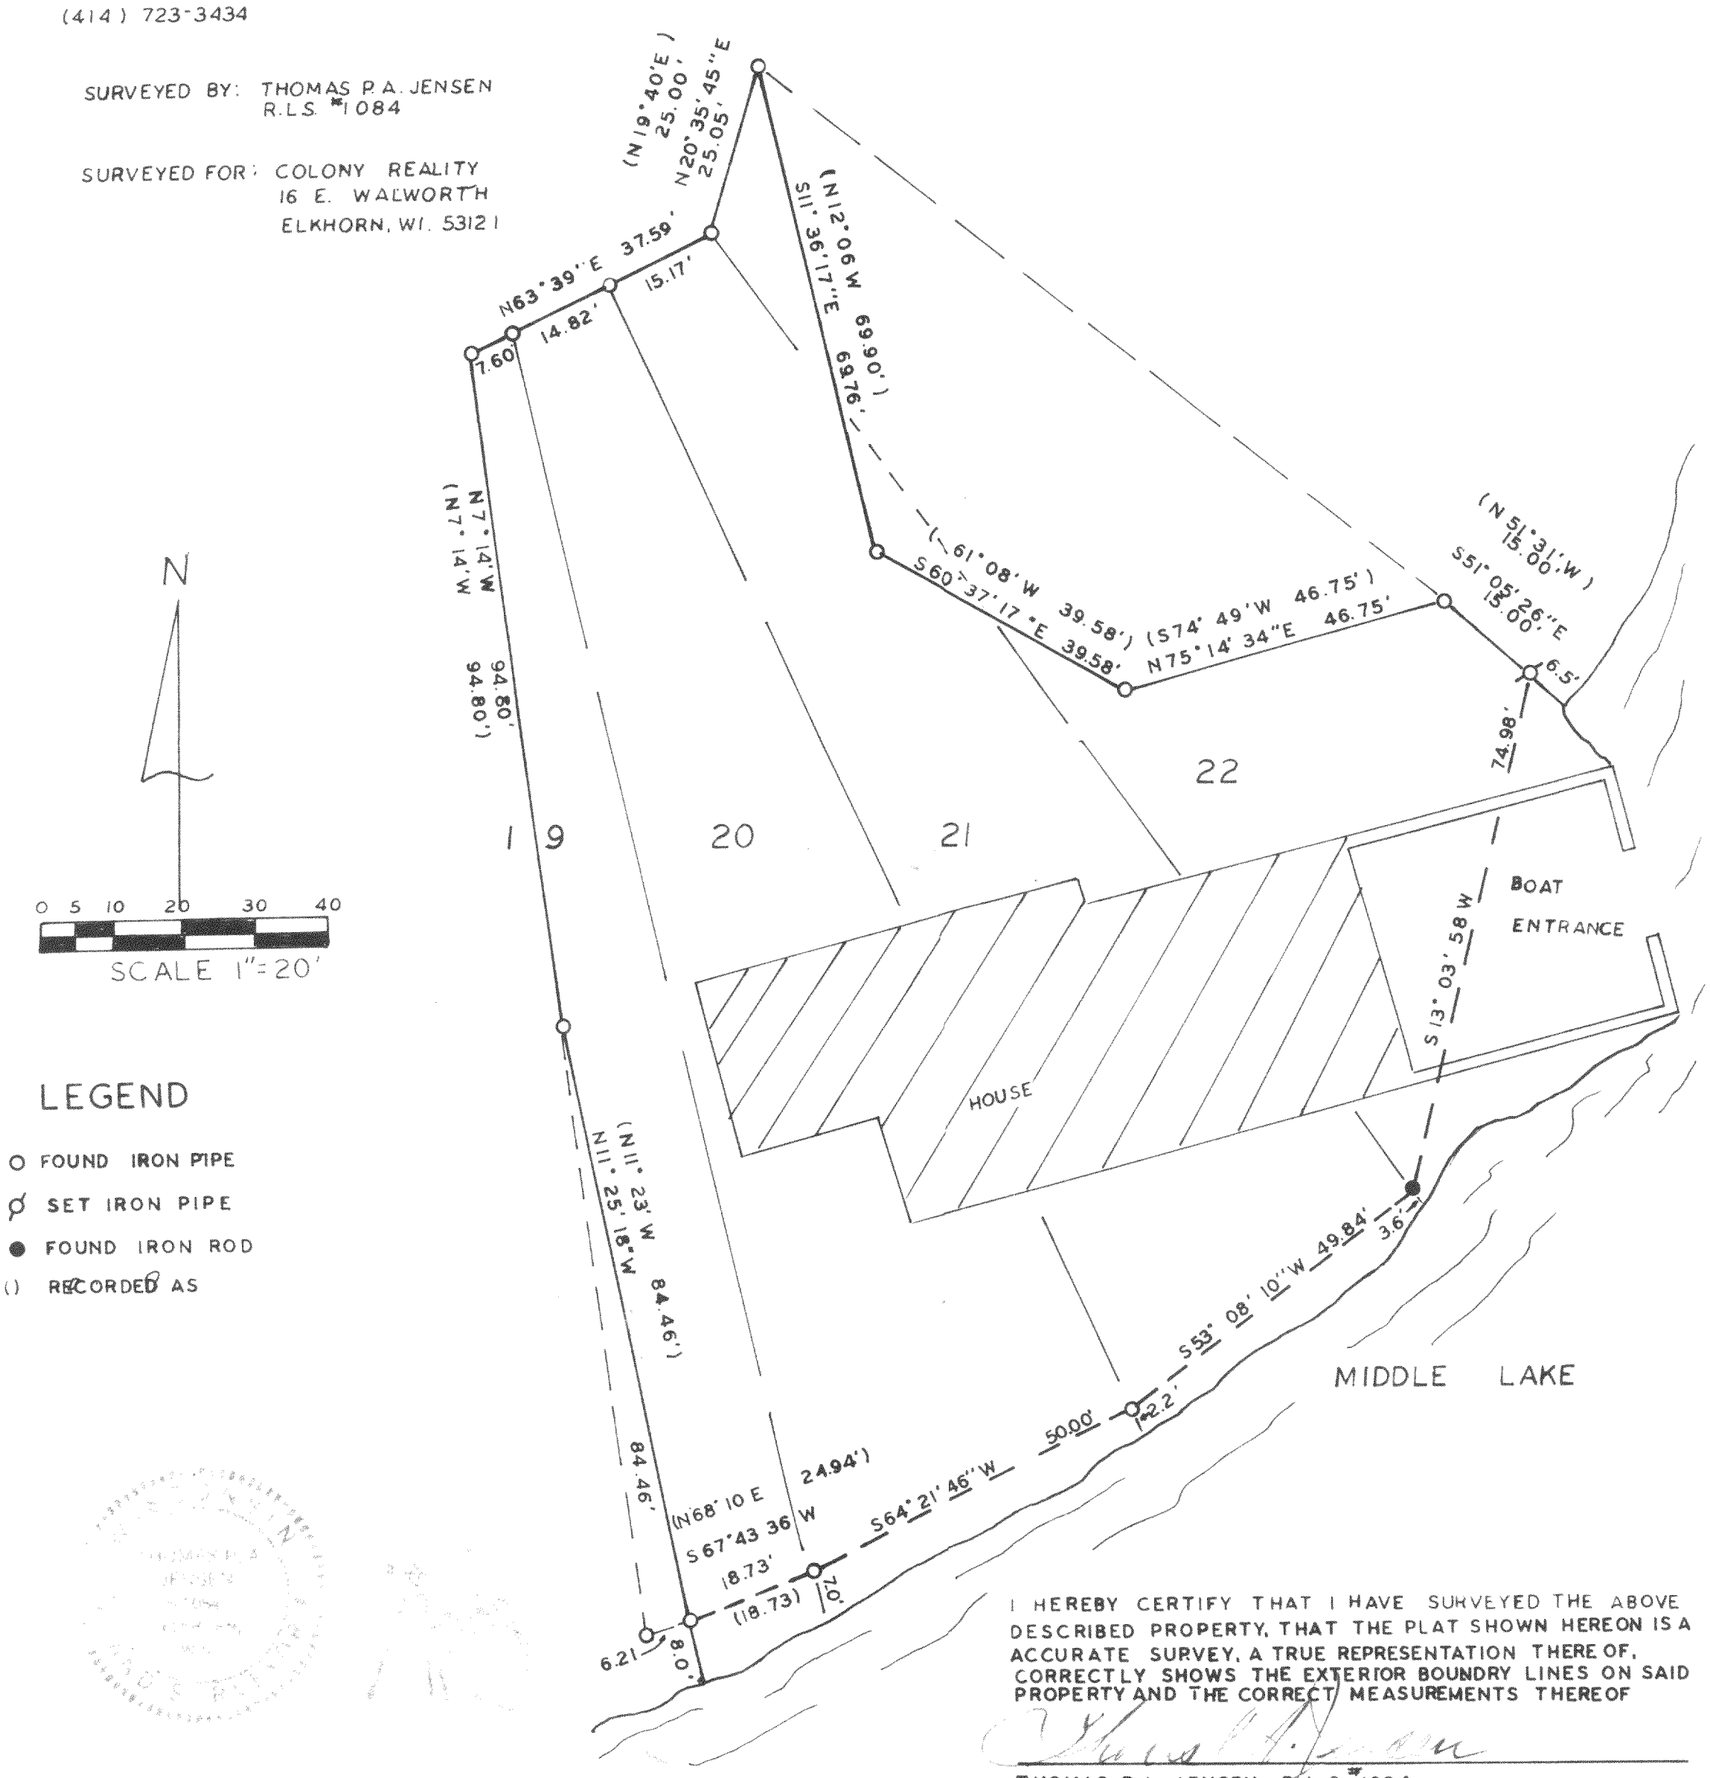

I HEREBY CERTIFY THAT I HAVE SURVEYED THE ABOVE DESCRIBED PROPERTY, THAT THE PLAT SHOWN HEREON IS A ACCURATE SURVEY, A TRUE REPRESENTATION THEREOF, CORRECTLY SHOWS THE EXTERIOR BOUNDRY LINES ON SAID PROPERTY AND THE CORRECT MEASUREMENTS THEREOF

Thomas P.A. Jensen

THOMAS P.A. JENSEN R.L.S. #1084

1983.025

HGI-4B

416-320