PLAT OF SURVEY – AS BUILT
PART OF LOT 1 THRU LOT 3 OF GREEN ISLAND SUBDIVISION

LOATED IN PART OF THE NE 1/4 OF THE SE 1/4 OF SECTION 26, TOWN 4 NORTH, RANGE 16 EAST,
TOWN OF LAGRANGE, WALWORTH COUNTY, WISCONSIN

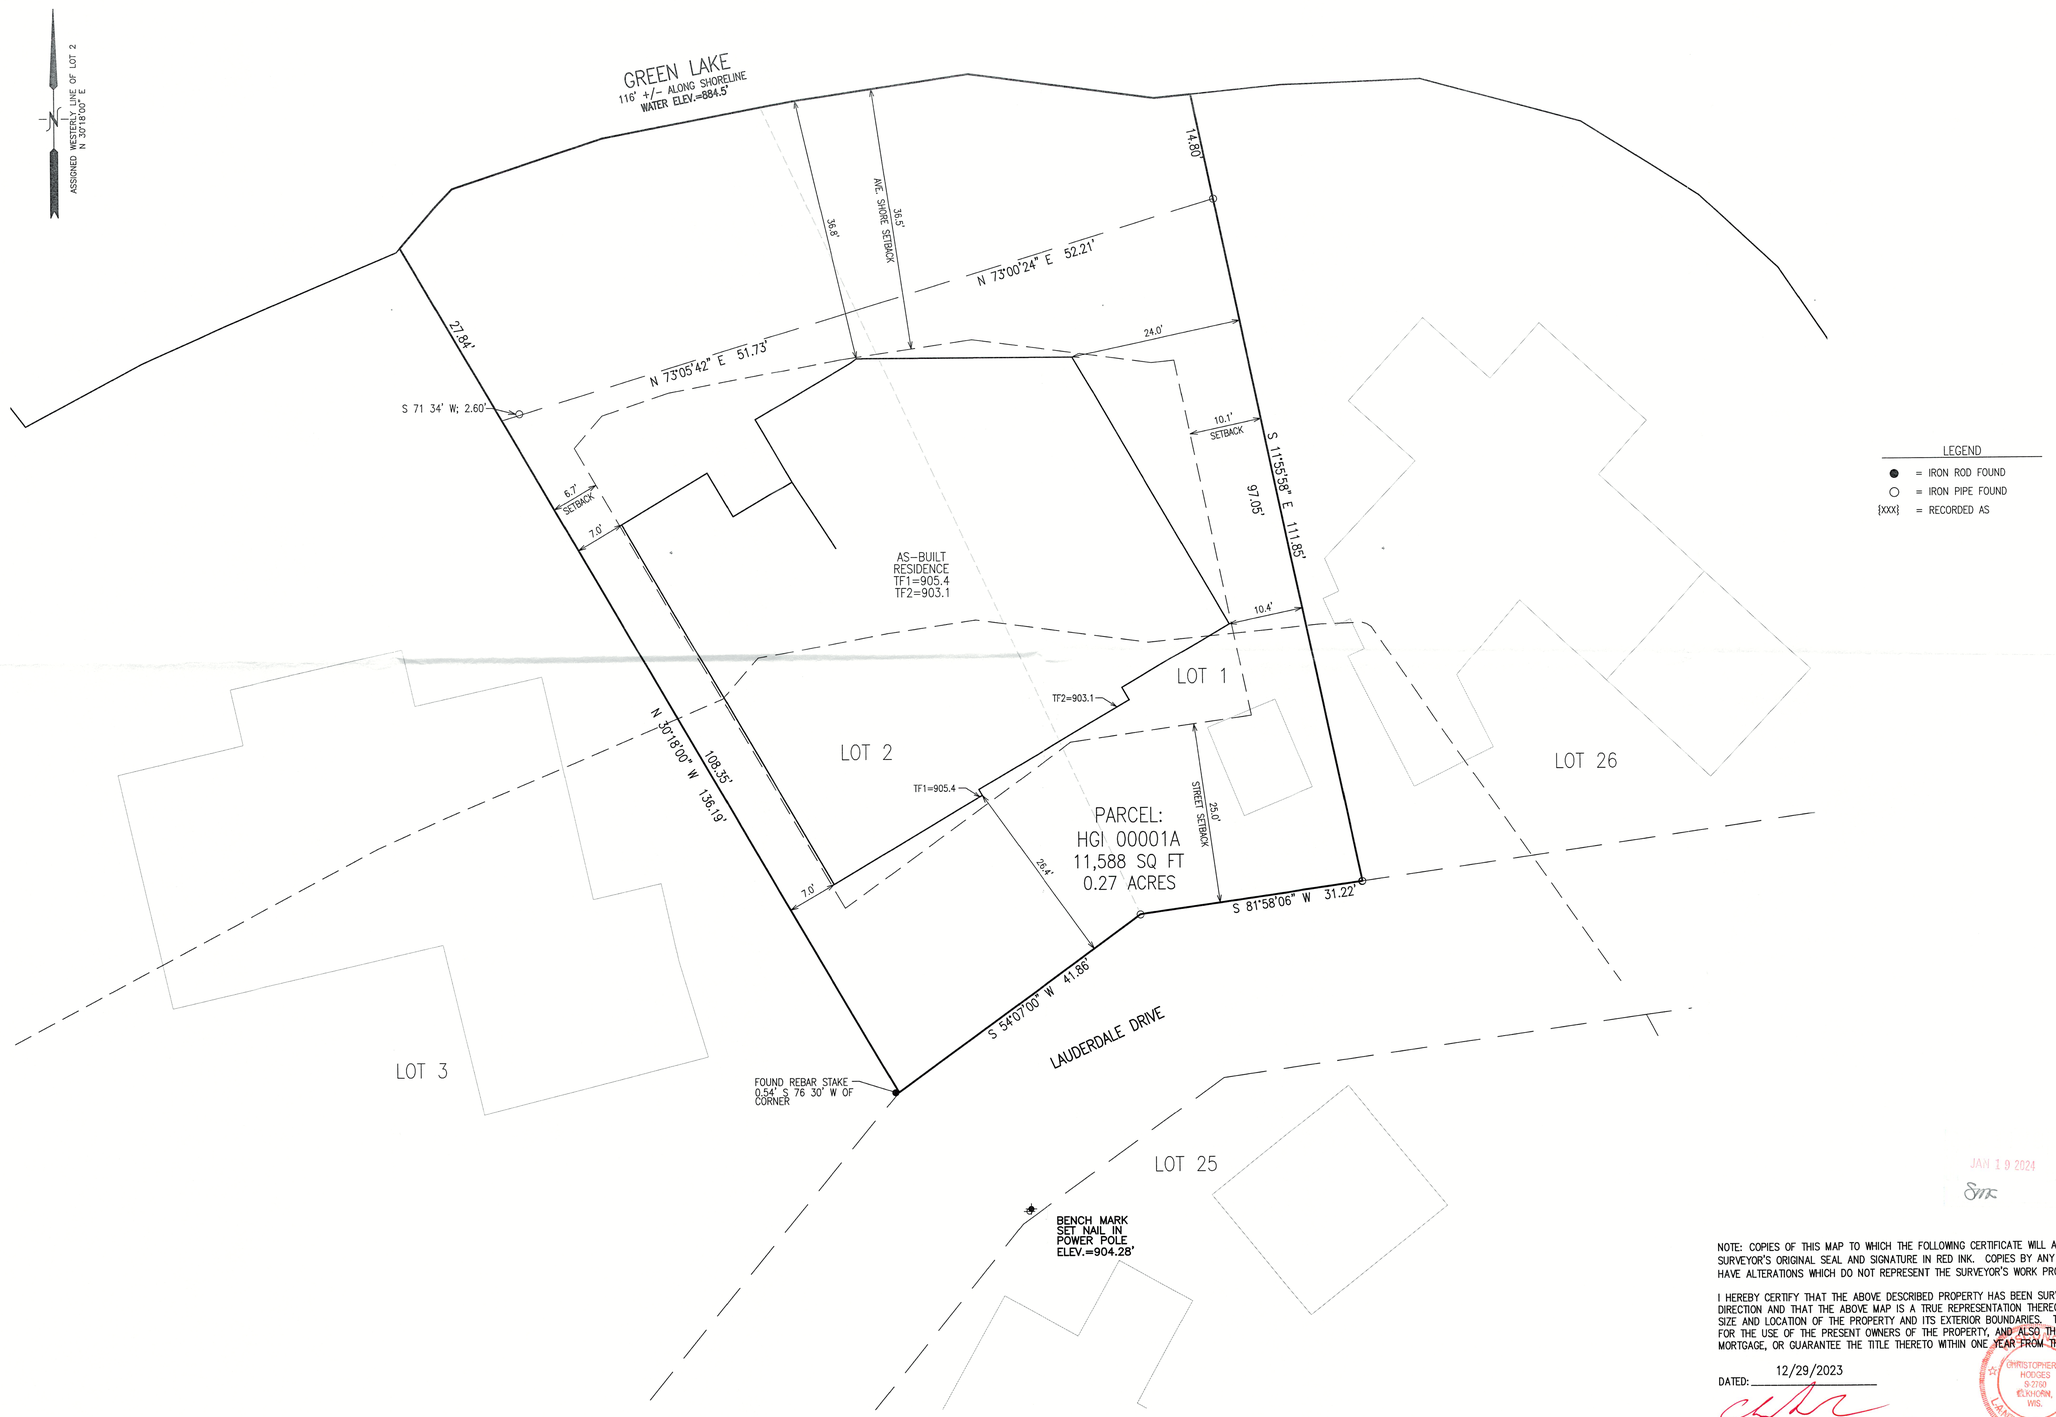

NOTE: COPIES OF THIS MAP TO WHICH THE FOLLOWING CERTIFICATE WILL APPLY SHOW THE SURVEYOR'S ORIGINAL SEAL AND SIGNATURE IN RED INK. COPIES BY ANY OTHER MEANS MAY HAVE ALTERATIONS WHICH DO NOT REPRESENT THE SURVEYOR'S WORK PRODUCT.

I HEREBY CERTIFY THAT THE ABOVE DESCRIBED PROPERTY HAS BEEN SURVEYED UNDER MY DIRECTION AND THAT THE ABOVE MAP IS A TRUE REPRESENTATION THEREOF AND SHOWS THE SIZE AND LOCATION OF THE PROPERTY AND ITS EXTERIOR BOUNDARIES. THIS SURVEY IS MADE FOR THE USE OF THE PRESENT OWNERS OF THE PROPERTY, AND ALSO THOSE WHO PURCHASE, MORTGAGE, OR GUARANTEE THE TITLE THERETO WITHIN ONE YEAR FROM THE DATE HEREOF.

DATED: 12/29/2023

CHRISTOPHER A. HODGES P.L.S. 2760

CHRISTOPHER A. HODGES S-2760 ELKHORN, WIS. LAND SURVEYOR

JAN 19 2024

PLAT OF SURVEY
AS–BUILT
W5330 LAUDERDALE DRIVE
ELKHORN, WI 53121

– WORK ORDERED BY –
JIM BINDON
16 WINDSOR DRIVE
OAK BROOK, IL 60523

FARRIS, HANSEN & ASSOCIATES, INC.
ENGINEERING – ARCHITECTURE – SURVEYING
7 RIDGWAY COURT P.O. BOX 437
ELKHORN, WISCONSIN 53121
OFFICE: (262) 723–2098 FAX: (262) 723–5886

REVISIONS
8/26/2022 – DHC
ADDED UTILITIES

5/18/2023 – DHC
ADDED NEW RESIDENCE

5/24/2023 – DHC
UPDATE IMPERVIOUS

8/02/2023 – DHC
UPDATE HOUSE & IMPERVIOUS CLACS

12/28/2023 – DHC
AS–BUILT

PROJECT NO.
4824.11

DATE
8/22/2002

SHEET NO.
1 OF 1

X:\PROJECTS\4824\4824-11\ACAD\4824-11r3.dwg

HGI-1A HGI-2

416-3566