



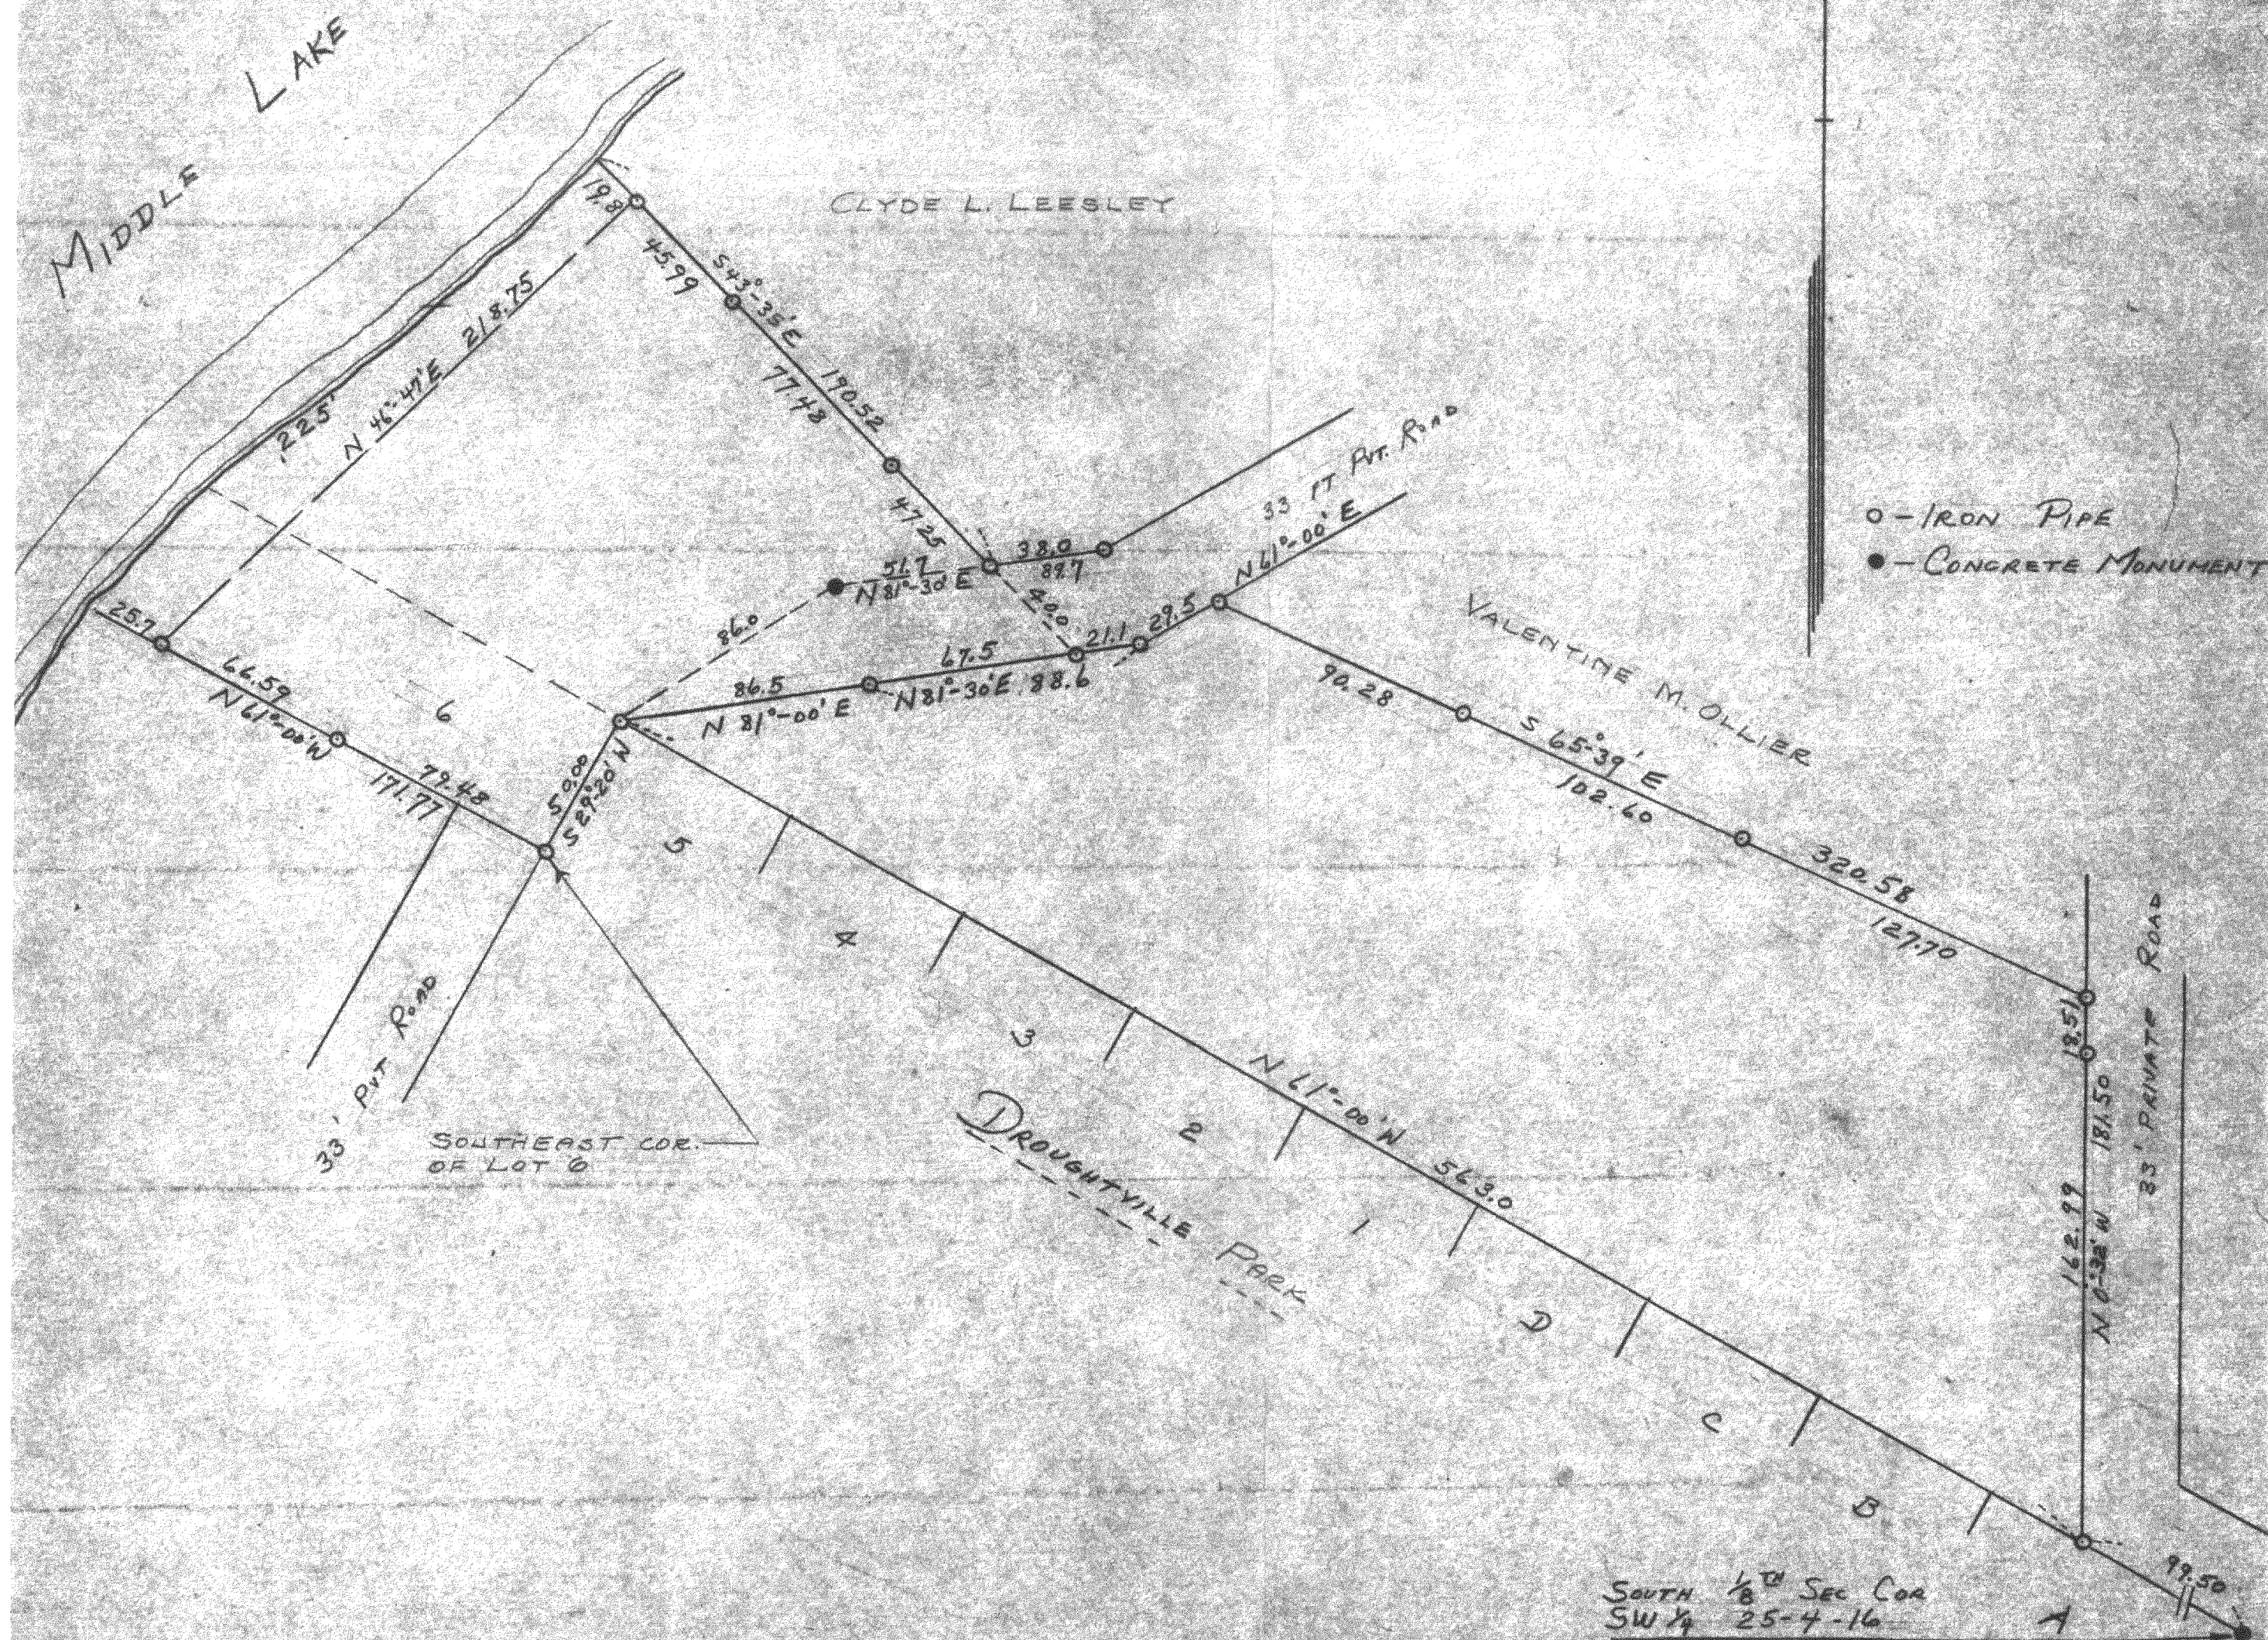

Lot 6 of Subd
 + LG-25-34

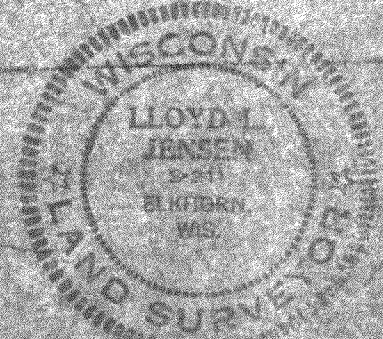

416-90.1

PLAT OF SURVEY
 OF
 LOT 6 OF DROUGHTVILLE PARK
 AND
 LAND IN SW 1/4 SECTION 25-4-16
 WALWORTH COUNTY, WISCONSIN

Lloyd L. Jensen
 SURVEYOR

SCALE 1" = 50'

DATE SEPT 1956