


# PLAT OF SURVEY TOPOGRAPHICAL MAPPING


LOTS 9 AND 9A OF ARROWHEAD PARK  
TOWN 1 NORTH, RANGE 16 EAST, WALWORTH COUNTY, WISCONSIN

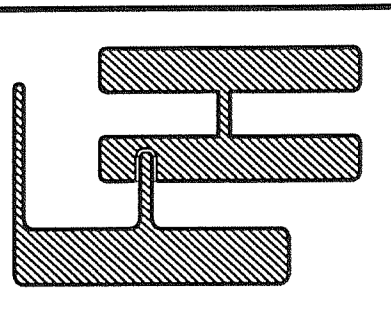

- WORK ORDERED BY -  
FRANK HOWARD  
700 BUSSER HIGHWAY  
PARK RIDGE, IL 60068

FARRIS, HANSEN & ASSOCIATES, INC.  
ENGINEERING - ARCHITECTURE - SURVEYING  
7 RIDGWAY COURT P.O. BOX 437  
ELKHORN, WISCONSIN 53121  
OFFICE: (262) 723-2098 FAX: (262) 723-5886

PROJECT NO.  
7214  
DATE  
01/30/2007  
SHEET NO.  
1 OF 1

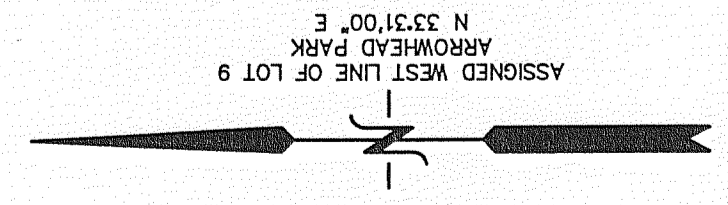

ASSIGNED WEST LINE OF LOT 9  
ARROWHEAD PARK  

TOTAL AREA  
15,266 S.F.  
0.35 AC.

LEGEND  
○ = FOUND IRON PIPE STAKE  
(XXX) = RECORDED AS




LEGEND  
○ = FOUND IRON PIPE STAKE  
● = FOUND IRON REBAR STAKE  
(XXX) = RECORDED AS  
ALL RETAINING WALLS ARE WOOD

NOTE: COPIES OF THIS MAP TO WHICH THE FOLLOWING CERTIFICATE  
WILL APPLY SHOW THE SURVEYOR'S ORIGINAL SEAL AND SIGNATURE  
WHICH DO NOT REPRESENT THE SURVEYOR'S WORK PRODUCT.  
I HEREBY CERTIFY THAT THE ABOVE DESCRIBED PROPERTY HAS BEEN  
SURVEYED UNDER MY DIRECTION AND THAT THE ABOVE MAP IS A TRUE  
AND CORRECT REPRESENTATION OF THE PROPERTY AND ITS EXTERIOR BOUNDARIES. THIS SURVEY IS  
ALSO MADE IN ACCORDANCE WITH THE SURVEYING STATUTES AND RULES OF  
THE STATE OF WISCONSIN AND I HEREBY CERTIFY THAT I AM A LICENSED SURVEYOR  
HEREIN UNDER THE TITLE OF SURVEYOR.  
DATED: JANUARY 30, 2007

PETER S. GORDON  
LAND SURVEYOR  
STATE OF WISCONSIN  
No. 10000  
PETER S. GORDON R.L.S. 2101

HAP-13 HAP-14

416-2858

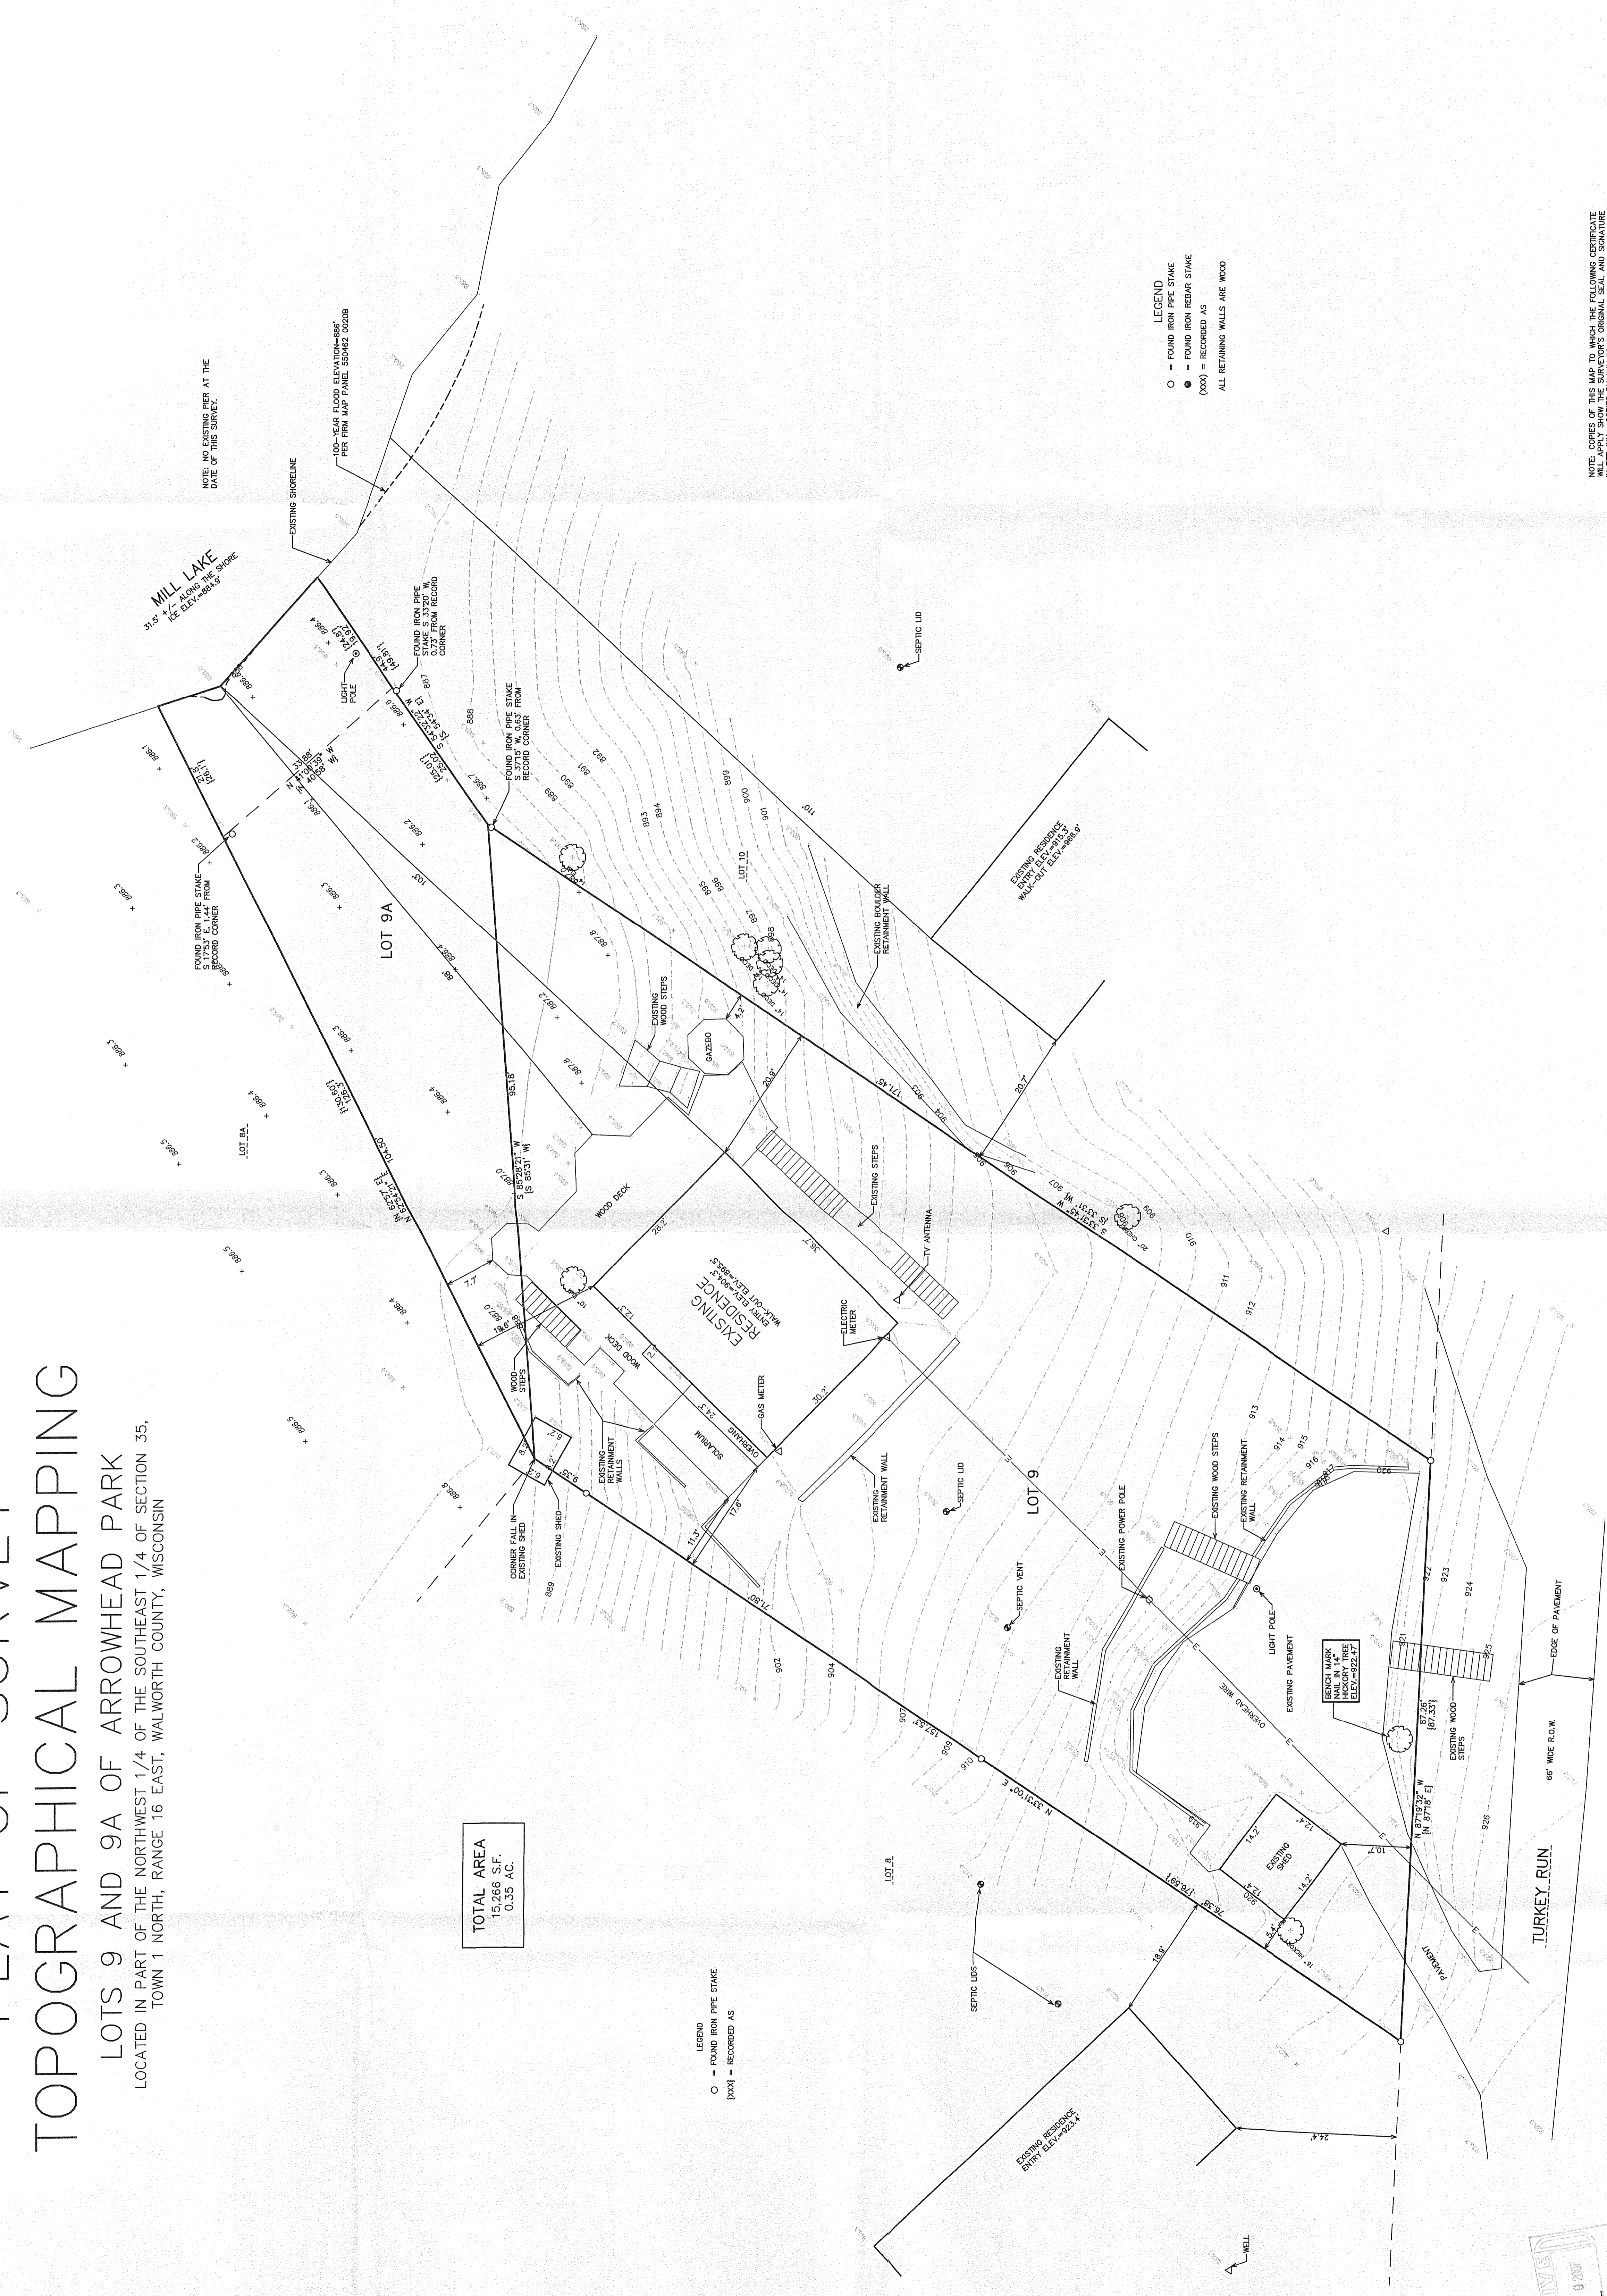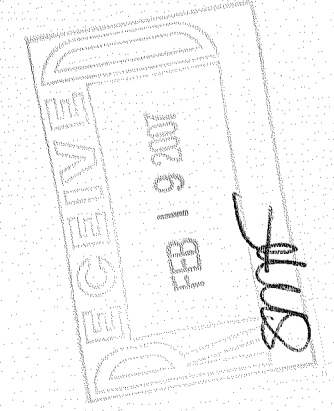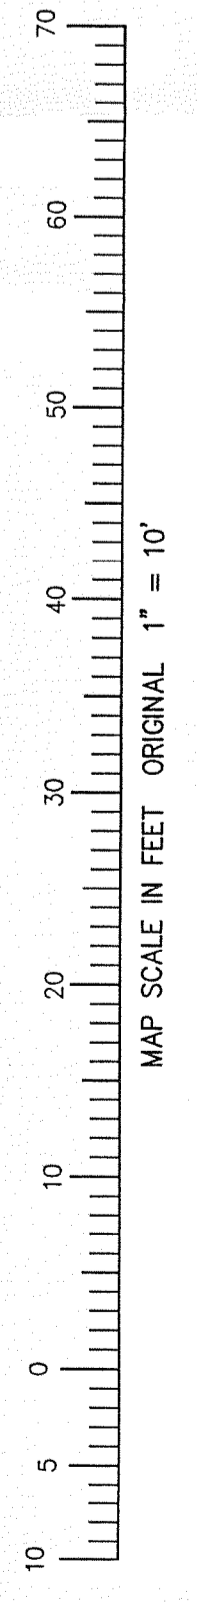

NOTE: NO EXISTING BERS AT THE  
DATE OF THIS SURVEY.

MILL LAKE  
31.5' ALONG THE SHORE  


EXISTING SHORELINE

FOUND IRON PIPE STAKE  
RECORDED CORNER  
STAKE S 33°20' W  
CORNER


