

1746-014

Middle

Lake


Plat of Survey

of



Lot 42 of the 1st Addition to Bubbling Springs Subdivision,

located in the Southeast 1/4 of Section 34, Town 4 North, Range 16 East, Town of LaGrange, Walworth County, Wisconsin.

Surveyed for: **Karen Kohout**
2632 Midland Drive
Naperville, Illinois. 60564

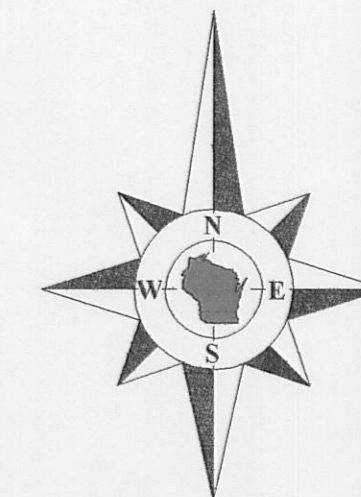

Bearings reference to the plat of the 1st Addition to Bubbling Springs Subdivision.

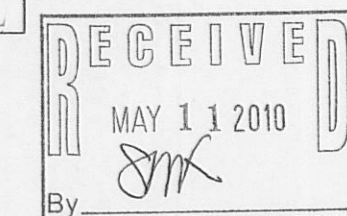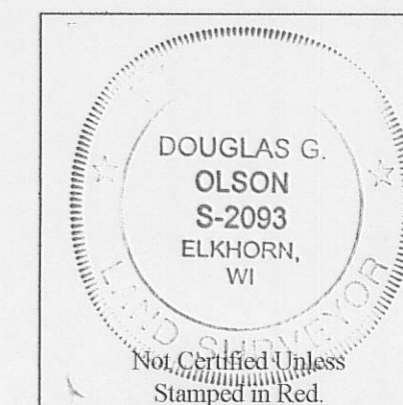

Notes:


- 1) This survey plat is not certified unless signed and sealed in red ink.
- 2) This survey is subject to Wisconsin lien laws. This Plat of Survey is the notice of intent to file lien. Lien waiver required.

Copyright 2009 by Jensen & Olson Land Surveying, LLC.


All rights reserved. No part of this survey plat may be reproduced or transmitted in any form by any means - graphic, electronic, or mechanical, including photocopying, tracing, or information storage and retrieval systems - without permission in writing from Douglas G. Olson, Jensen & Olson Land Surveying, LLC.

I, Douglas G. Olson, Wisconsin Registered Land Surveyor, do hereby certify that this survey was performed by me, or under my direction in full compliance with the owner's/agent's instructions and Chapter A-E 7 of the Wisconsin Administrative Code "Minimum Standards for Property Surveys"; and that this map is an accurate representation thereof to the best of my knowledge and belief.

Douglas G. Olson
Wisconsin Registered Land Surveyor - 2093

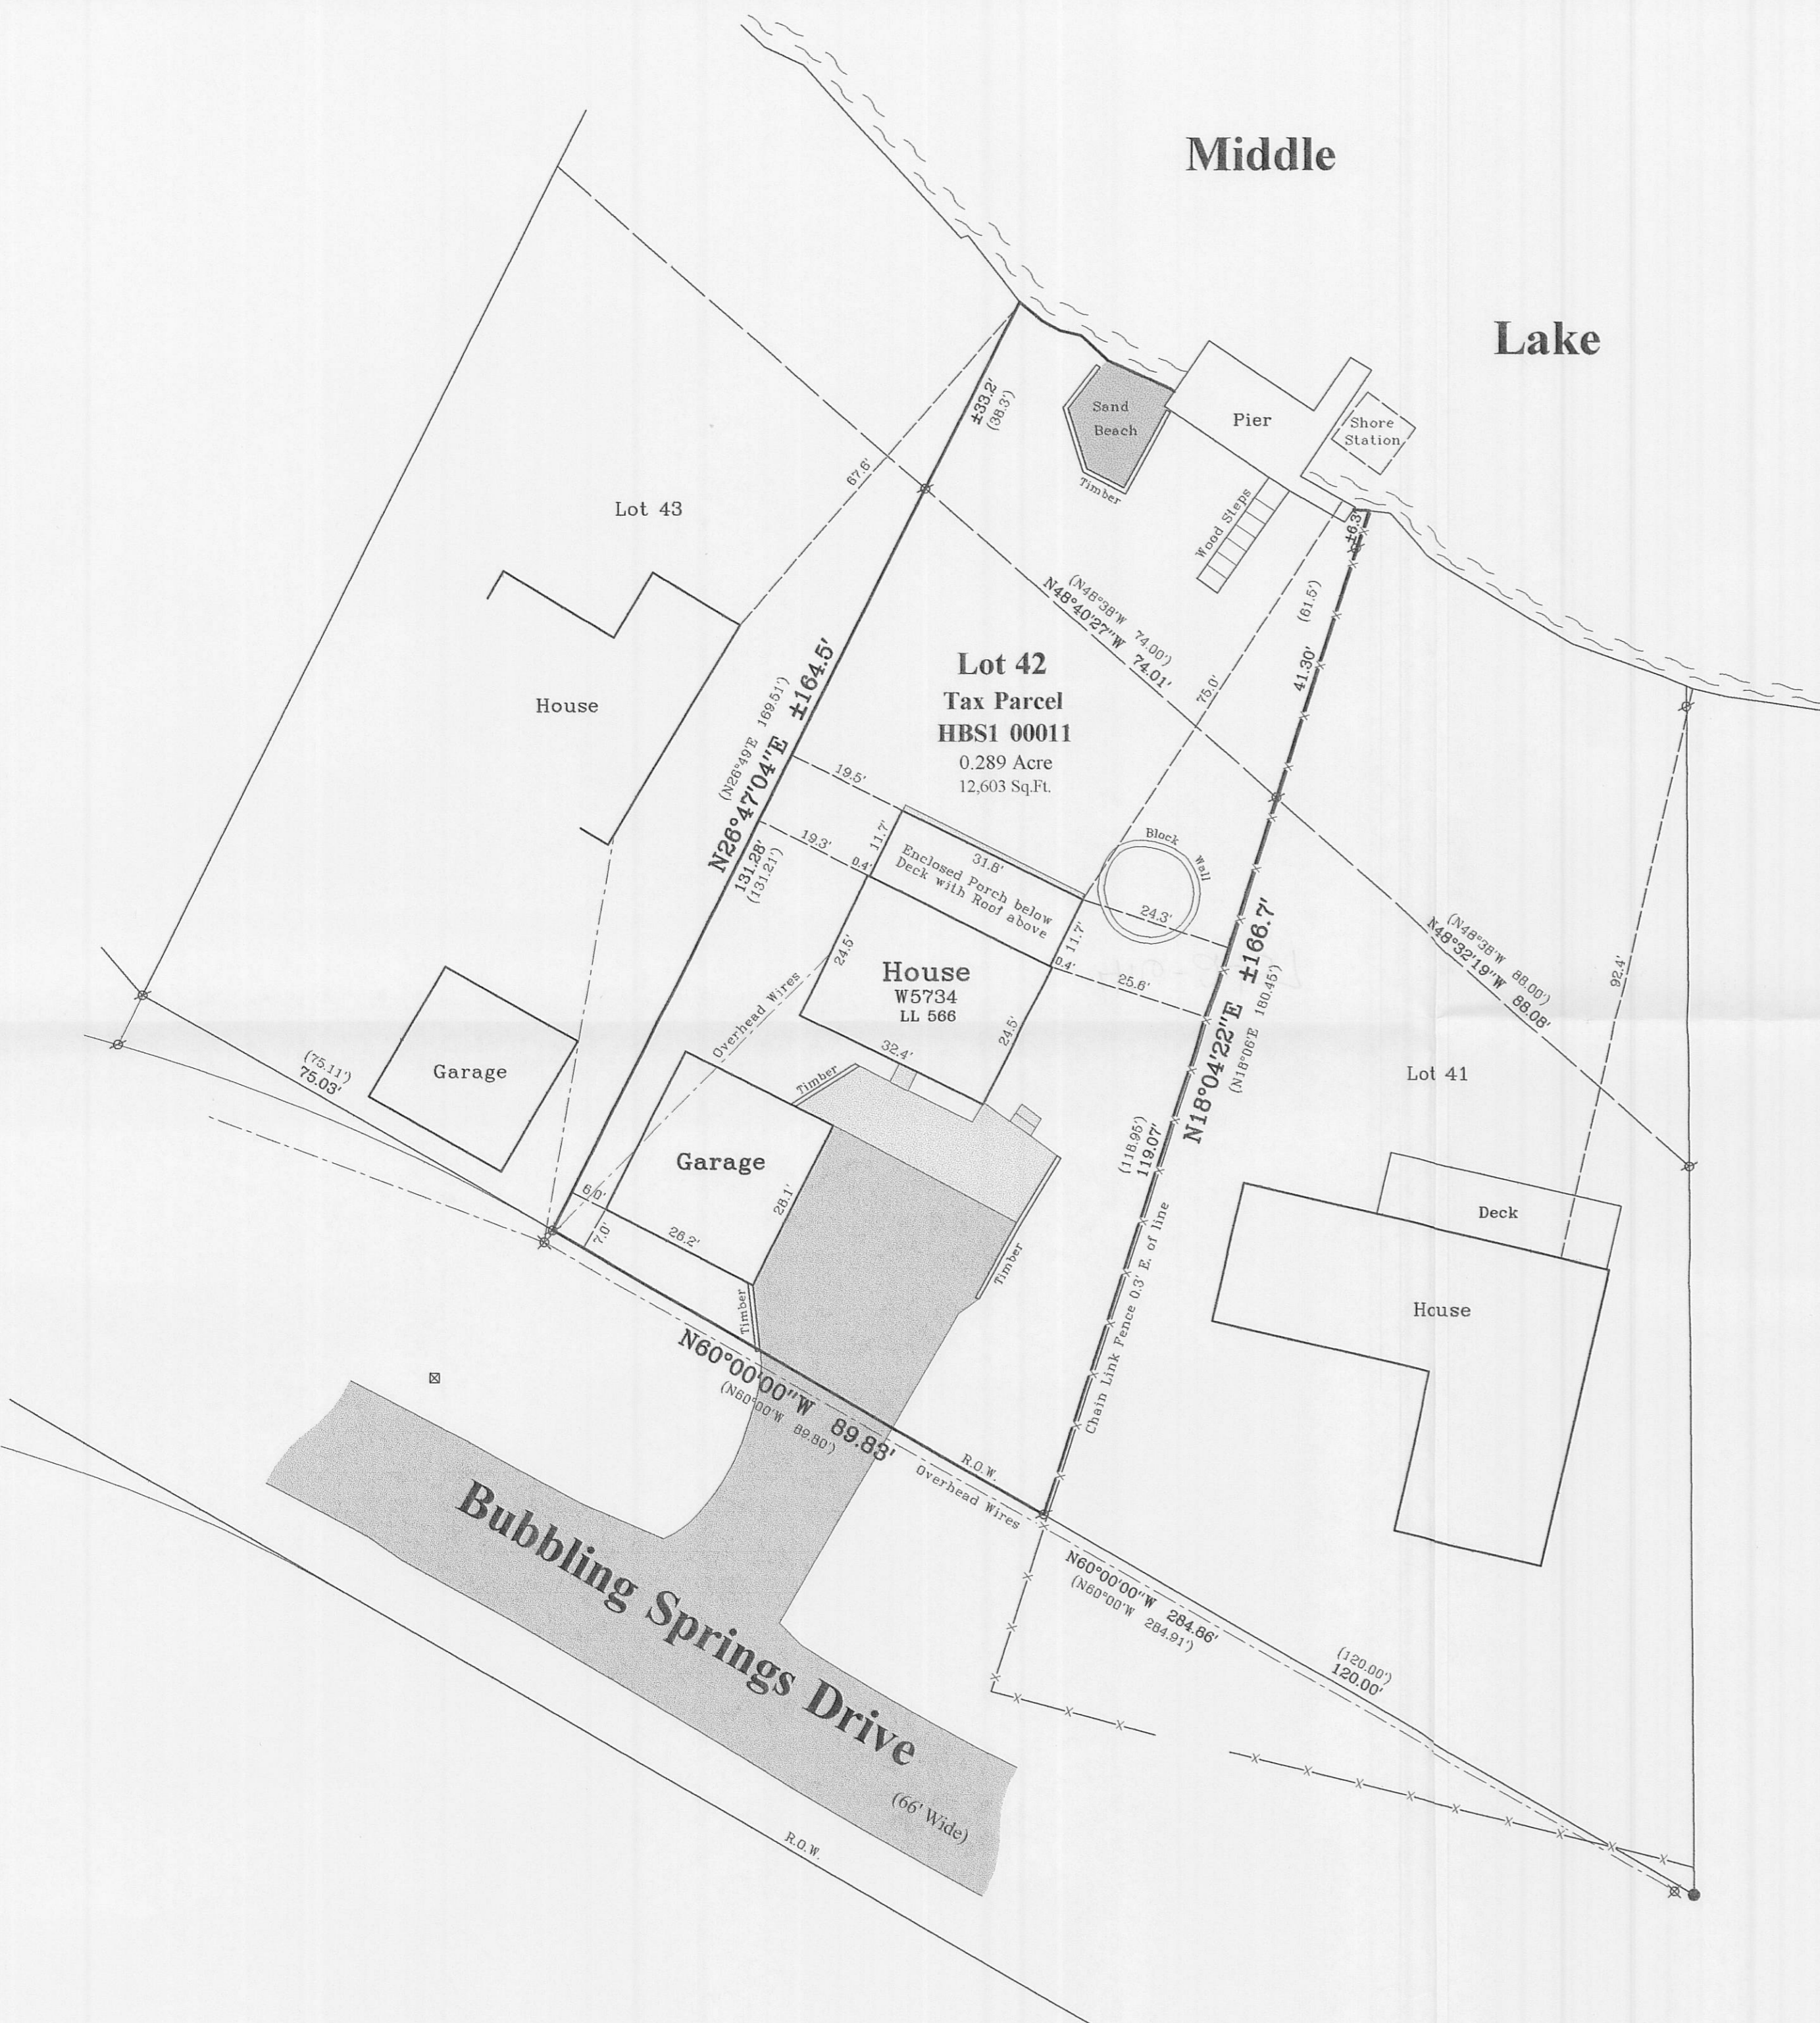

Survey Date: November 20, 2009.
Revisions:

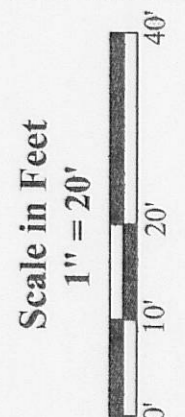

Jensen & Olson Land Surveying, LLC
 45 South Wisconsin Street * P.O. Box 322 * Elkhorn, Wisconsin. 53121
 Telephone: (262) 723-3434 * Facsimile: (262) 723-8044
 Email: jensen.olson@elknet.net

Legend
 Found Iron Pipe
 Found Iron Rod
 Recorded Information
 Utility Pole
 Utility Pedestal
 Asphalt Surface
 Concrete Surface

Sheet 1 of 1 Sheets
 Drawing Name: 444166-2009080-2009080Plat.sj
 Job Reference Number
2009.080

2009.080

HBS1-11

416-2457