


Plat of Survey

of

Unit 74 of Lauderdale Shores
A Recreational Vehicle Condominium,

located in the Northwest 1/4 of Section 25, Town 4 North, Range
16 East, Town of LaGrange, Walworth County, Wisconsin.

Surveyed for: **Dennis Most**
326 Cimarron Road
Lombard, Illinois. 60148

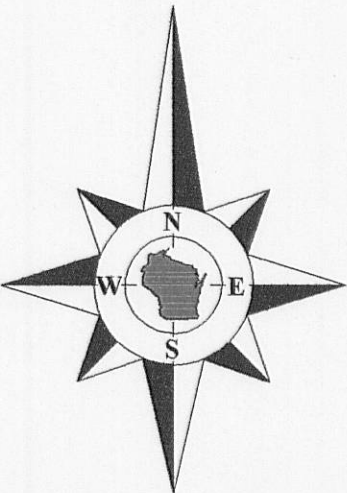

Bearings reference to the plat of
Lauderdale Shores A Recreational
Vehicle Condominium.



Notes:



- 1) This survey plat is not certified unless signed and sealed in red ink.
- 2) This survey is subject to Wisconsin lien laws. This Plat of Survey is the notice of intent to file lien. Lien waiver required.

Copyright 2009 by Jensen & Olson Land Surveying, LLC.


All rights reserved. No part of this survey plat may be reproduced or transmitted in any form by any means - graphic, electronic, or mechanical, including photocopying, tracing, or information storage and retrieval systems - without permission in writing from Douglas G. Olson, Jensen & Olson Land Surveying, LLC.

I, Douglas G. Olson, Wisconsin Registered Land Surveyor, do hereby certify that this survey was performed by me, or under my direction in full compliance with the owner's/agent's instructions and Chapter A-E 7 of the Wisconsin Administrative Code "Minimum Standards for Property Surveys"; and that this map is an accurate representation thereof to the best of my knowledge and belief.

Douglas G. Olson
Wisconsin Registered Land Surveyor - 2093

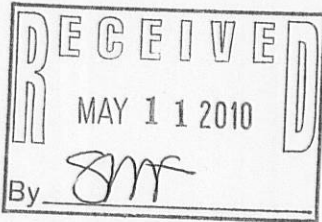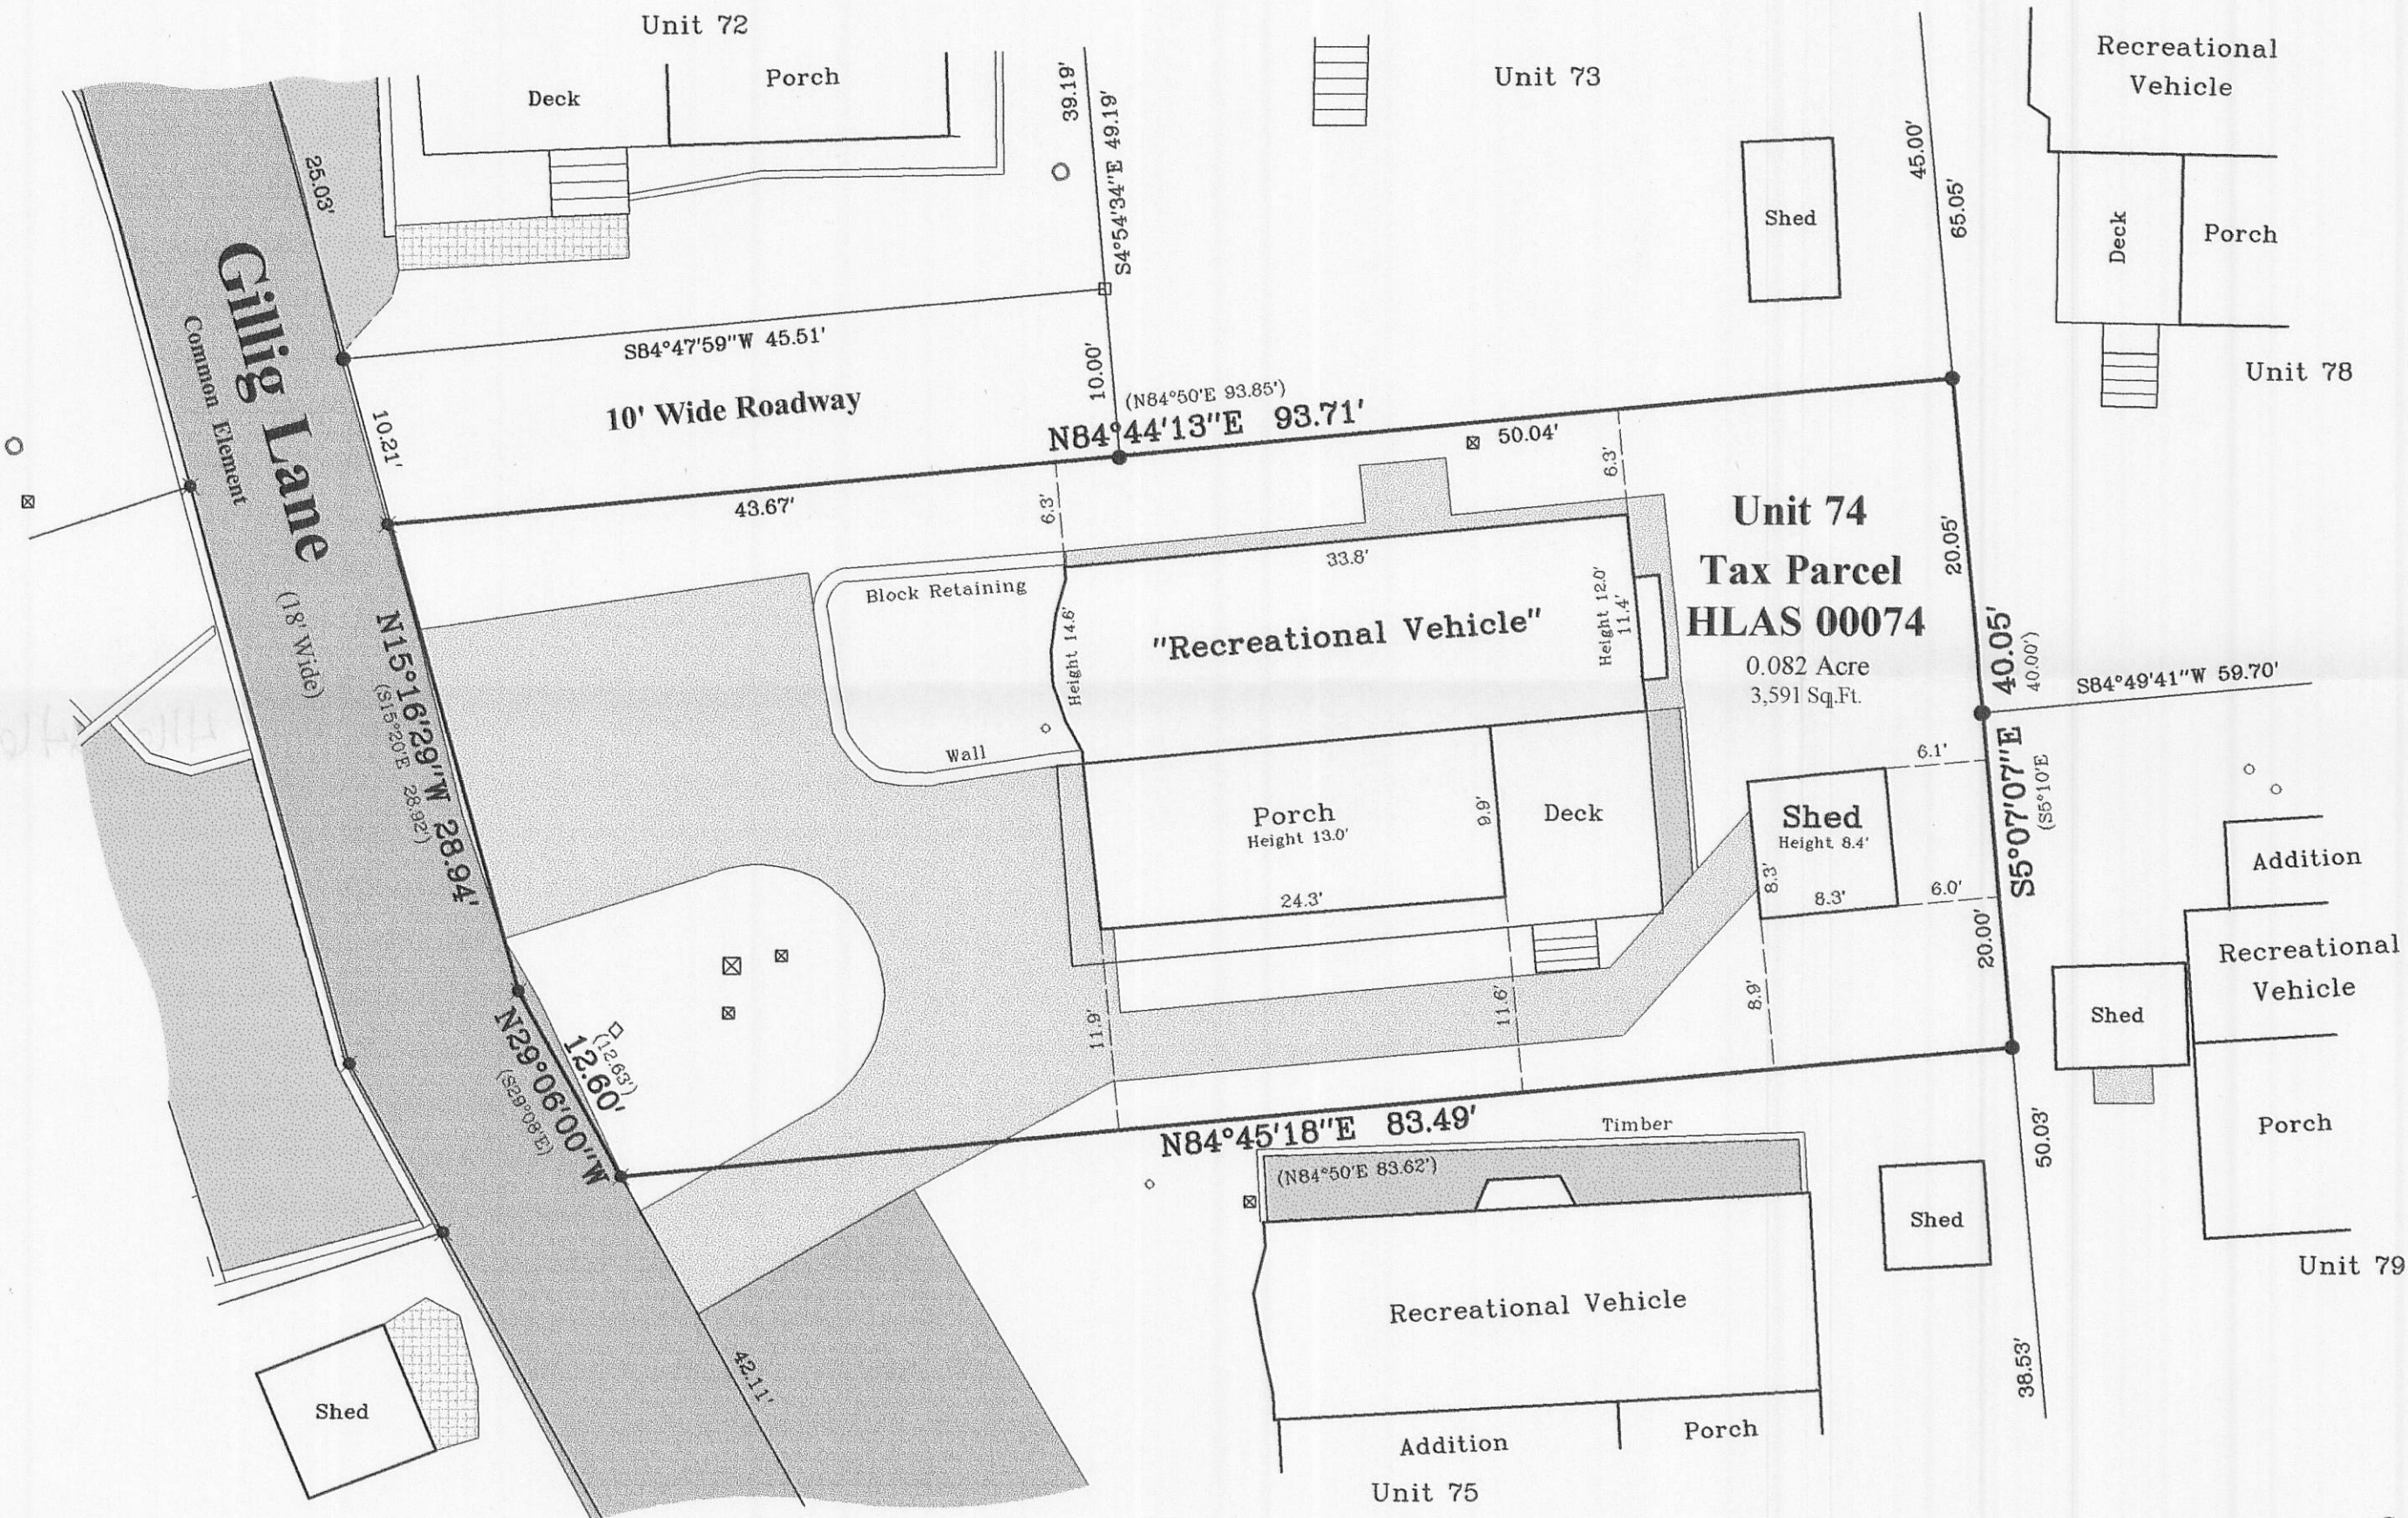

Survey Date: November 19, 2009.
Revisions:

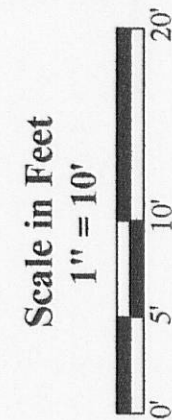

Jensen & Olson Land Surveying, LLC

45 South Wisconsin Street * P.O. Box 322 * Elkhorn, Wisconsin. 53121
Telephone: (262) 723-3434 * Facsimile: (262) 723-8044
Email: jensen.olson@elknet.net

Legend
Found Iron Rod
Found Railroad Spike
Found Railroad
Utility Box or Pedestal
Manhole
Asphalt Surface
Concrete Surface
Gravel Surface
Pavers or Stone
Water Sprigot
Hydrant
PVC Pipe

Sheet 1 of 1 Sheets
Drawing Name: dlar16s-2010009-201009Plat.dwg
Job Reference Number
2010.009

2010.009

HLAS-74

416-2460