


0

located in the Northwest 1/4 of Section 25, Town 4 North, Range 16 East, Town of LaGrange, Walworth County, Wisconsin.

122 Stonegate Road
La Grange Park, Illinois. 60526

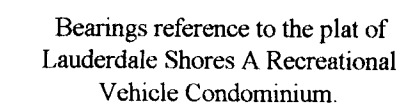

- 1) This survey plat is not certified unless signed and sealed in red ink.
- 2) This survey is subject to Wisconsin lien laws. This Plat of Survey is the notice of intent to file lien. Lien waiver required.



Legend

<input checked="" type="checkbox"/> Found Iron Pipe	<input checked="" type="checkbox"/> Set Railroad Spike	<input checked="" type="checkbox"/> Utility Pole
<input checked="" type="checkbox"/> Found Iron Rod	<input checked="" type="checkbox"/> Set Railroad Spike $\frac{3}{4}$ " dia.	<input checked="" type="checkbox"/> Manhole
<input checked="" type="checkbox"/> Found Railroad Spike	<input checked="" type="checkbox"/> Recorded Information	<input checked="" type="checkbox"/> PVC Pipe
<input checked="" type="checkbox"/> Set Iron Rod 3/4" dia.	<input checked="" type="checkbox"/> Utility Box or Pedestal	<input checked="" type="checkbox"/> Water Spigot
<input checked="" type="checkbox"/> Found Iron Rod	<input checked="" type="checkbox"/> Asphalt Surface	<input checked="" type="checkbox"/> Water Valve
<input checked="" type="checkbox"/> Found Railroad Spike	<input checked="" type="checkbox"/> Concrete Surface	<input checked="" type="checkbox"/> Water Valve

Sheet 1 of 1 Sheets

Job Reference Number

2009.112

Survey Date: November 15, 2009.
Revisions: No. 1 - Dimensional type

Scale in Feet
1" = 10'