PLAT OF SURVEY

LOT 7 OF OAK PARK SUBDIVISION, T4N R16E, SEC. 26 WALWORTH COUNTY, TOWN OF LA GRANGE, WISCONSIN.

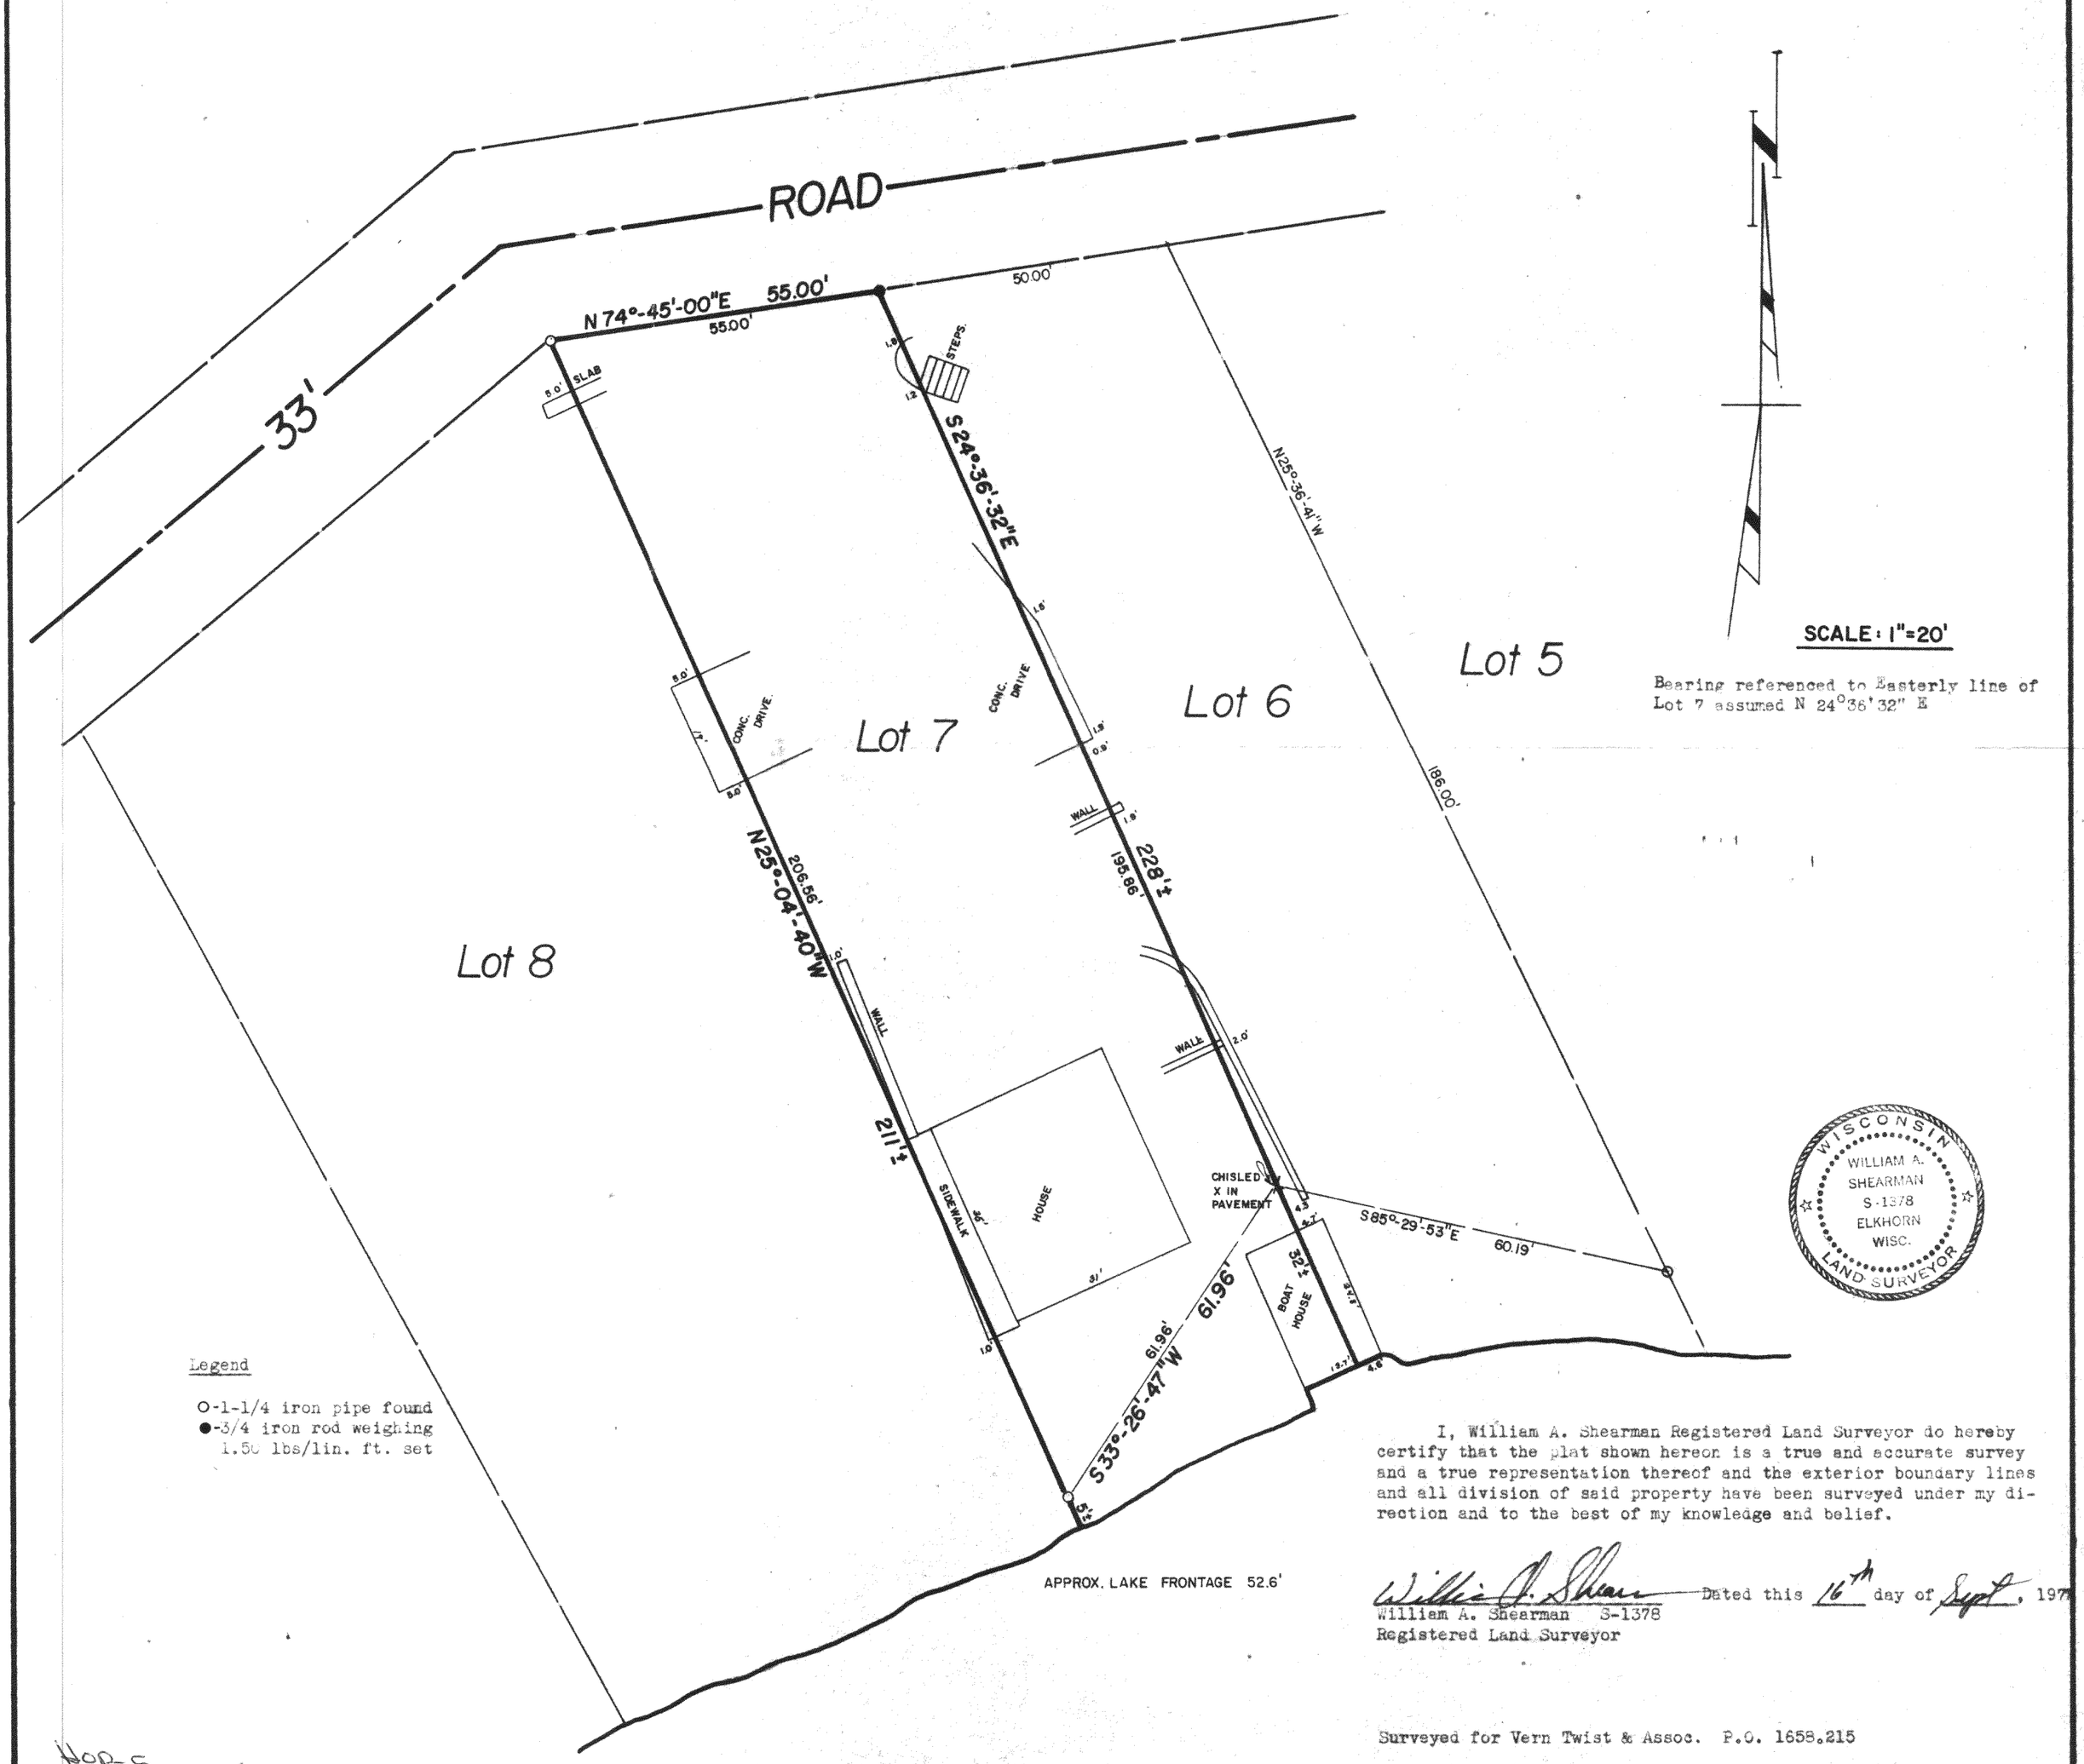

SCALE: 1"=20'

Bearing referenced to Easterly line of Lot 7 assumed N 24°36'32" E

Legend

O-1-1/4 iron pipe found
●-3/4 iron rod weighing 1.50 lbs/lin. ft. set

I, William A. Shearman Registered Land Surveyor do hereby certify that the plat shown hereon is a true and accurate survey and a true representation thereof and the exterior boundary lines and all division of said property have been surveyed under my direction and to the best of my knowledge and belief.

William A. Shearman Dated this 16th day of Sept. 197

William A. Shearman S-1378
Registered Land Surveyor

Surveyed for Vern Twist & Assoc. P.O. 1658,215

WISCONSIN WILLIAM A. SHEARMAN S-1378 ELKHORN WISC. LAND SURVEYOR

WOP-5

416-268