




**Plat of Survey**  
 of  
**Lauderdale Shores**  
 A Recreational Vehicle Condominium,  
 and  
 Lots 15, 16 and 17 of Green Lake Subdivision,  
 located in the Northwest 1/4 of Section 25, Town 4 North, Range  
 16 East, Town of Ladangrange, Walworth County, Wisconsin.

Survey Date: November 10, 2009.  
 Revisions: No. 1 - Building Heights, Curve  
 No. 2 - Addition height notations  
 No. 3 - Points Restaked in road  
 near Unit 100

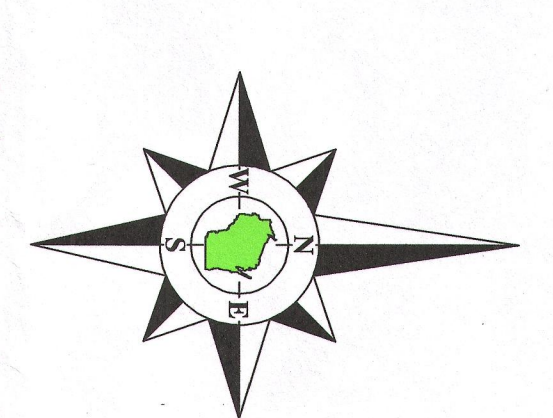

Bearing reference to the plat of  
 Lauderdale Shores A Recreational  
 Vehicle Condominium

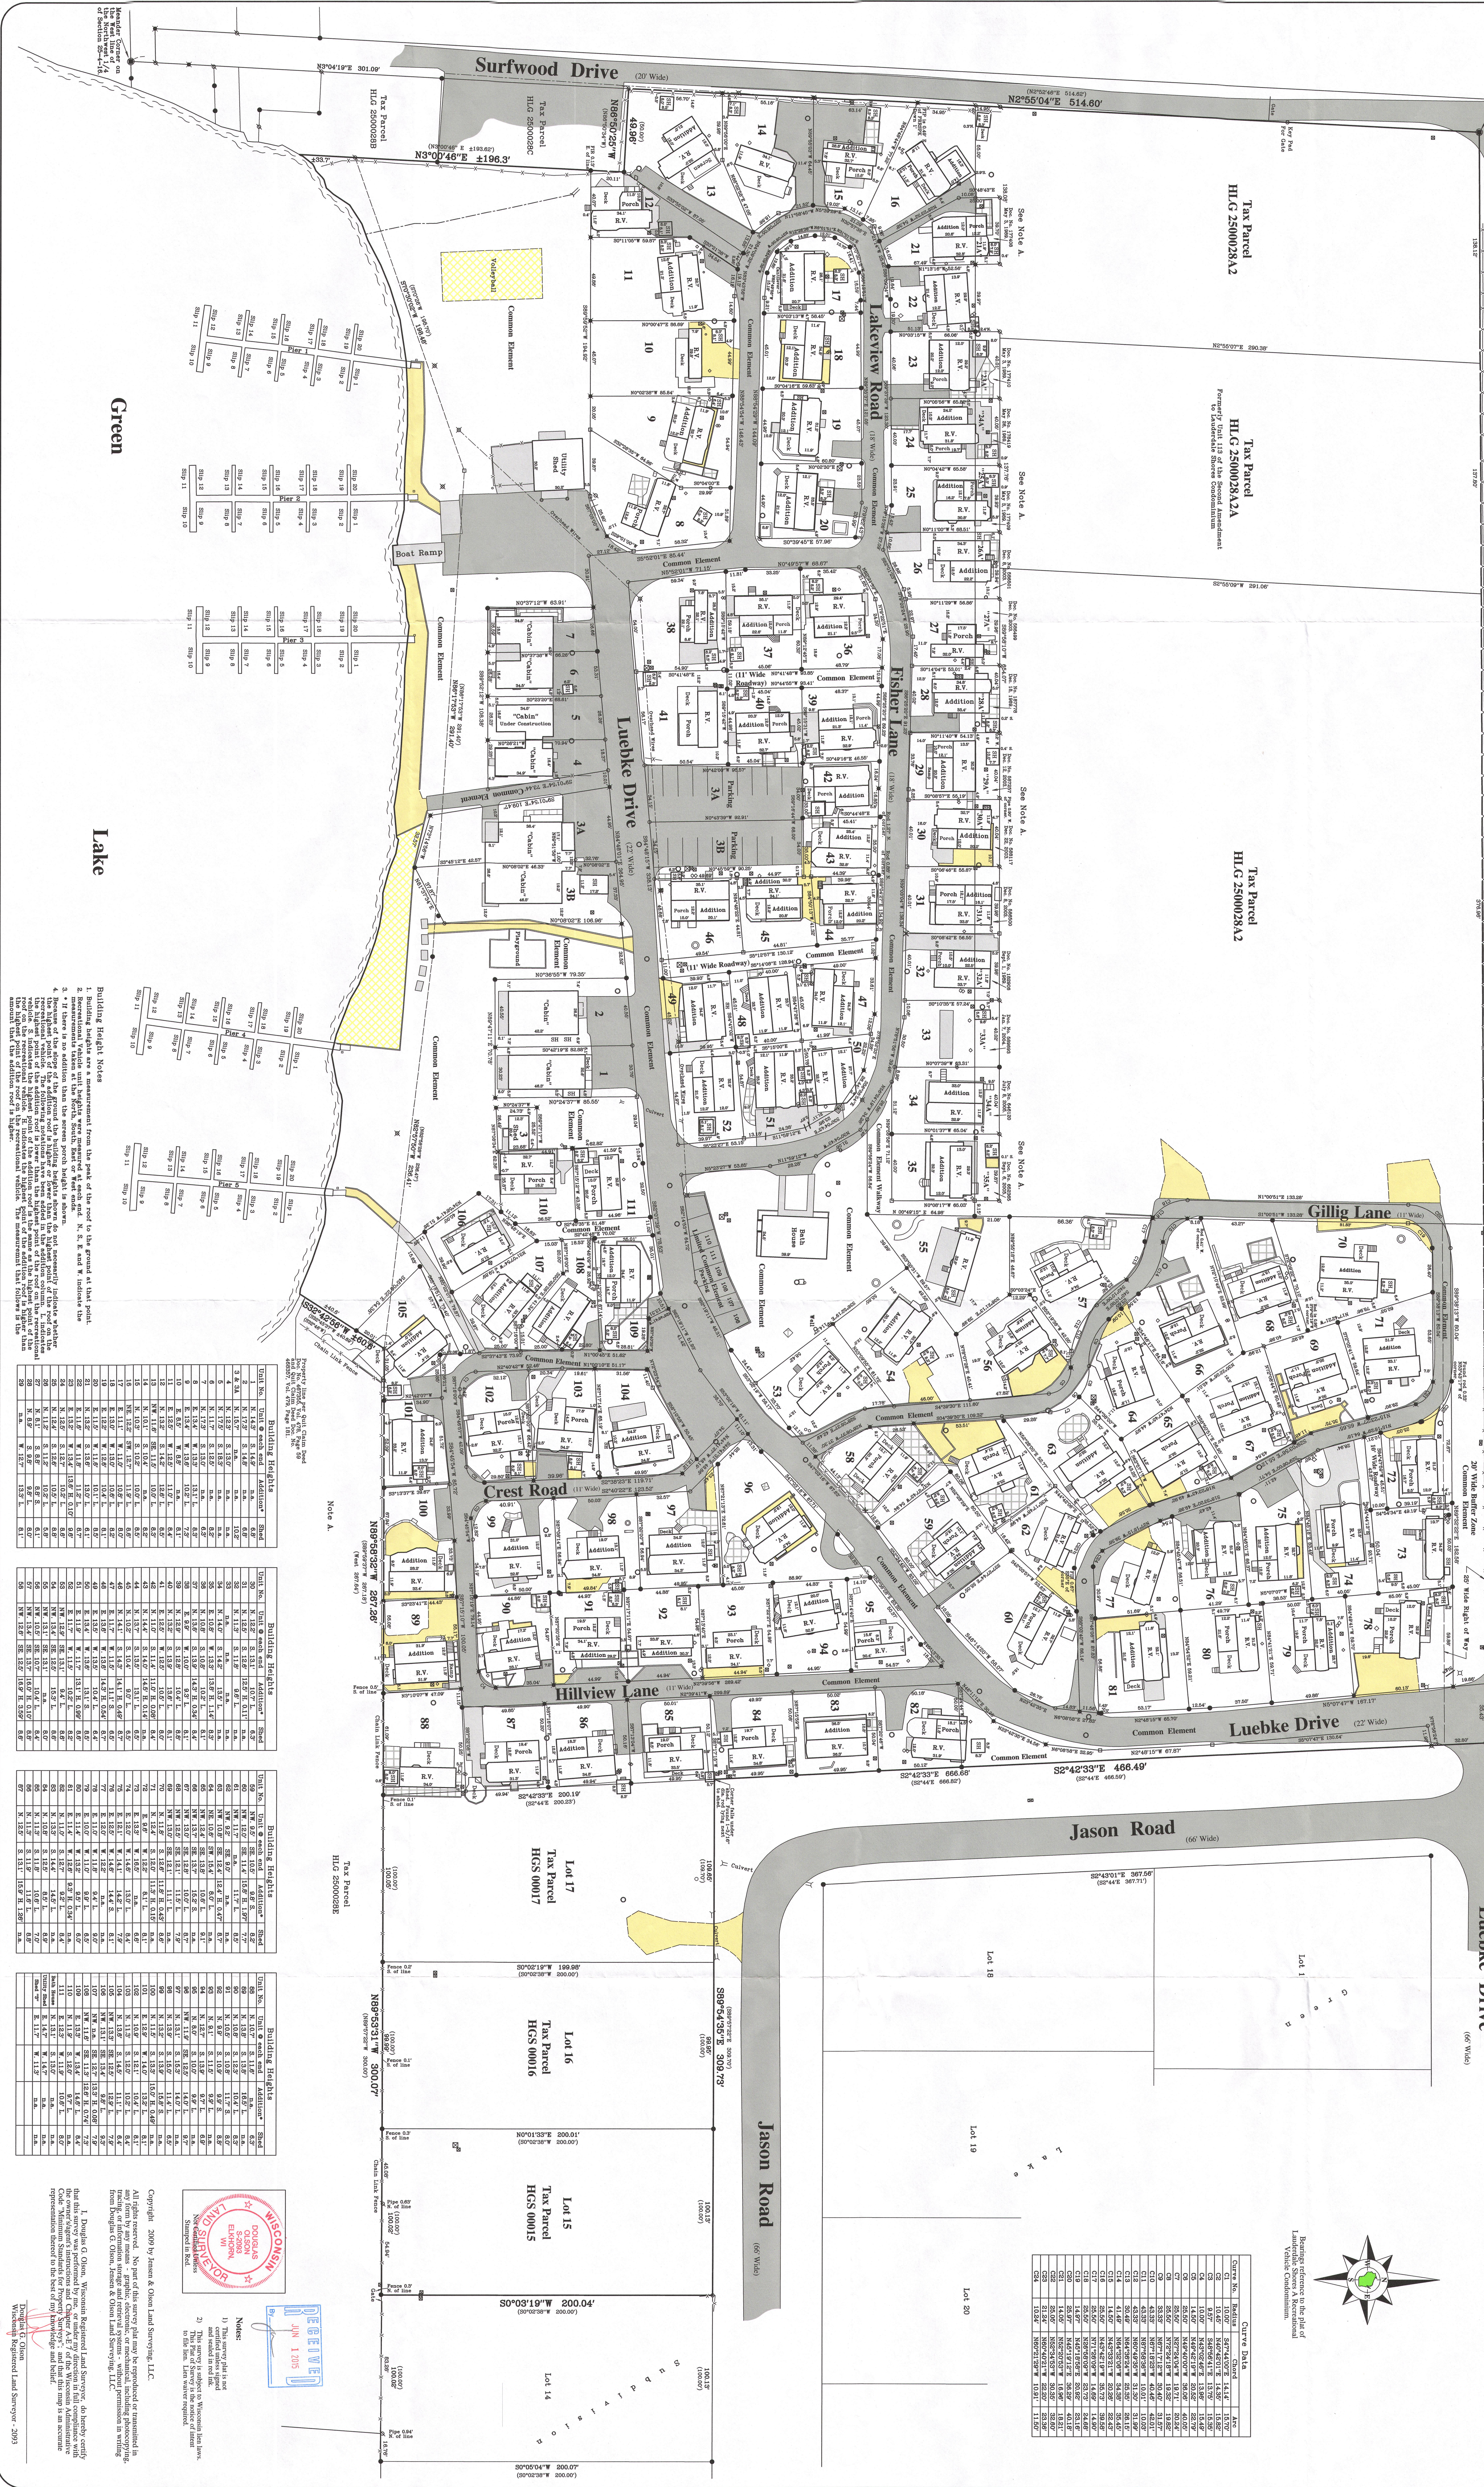

**Green**

**Lake**

**Building Height Notes**

- Building heights are measured from the peak of the roof to the ground at that point.

