

# Plat of Survey


of

## Lot 2 of Block 14 of Cool Hill Park Addition No. 2,


a subdivision located in the Southeast 1/4 of Section 34, Town 4 North, Range 16 East, Town of LaGrange, Walworth County, Wisconsin.

Surveyed for: **Keefe Real Estate, Inc.**

751 Geneva Parkway  
P.O. Box 460  
Lake Geneva, Wisconsin. 53147

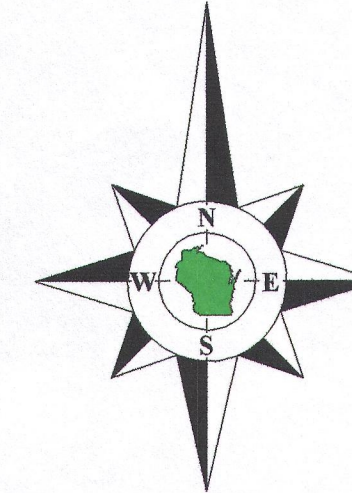


Bearings reference to the plat of Cool Hill Park Addition No. 2.

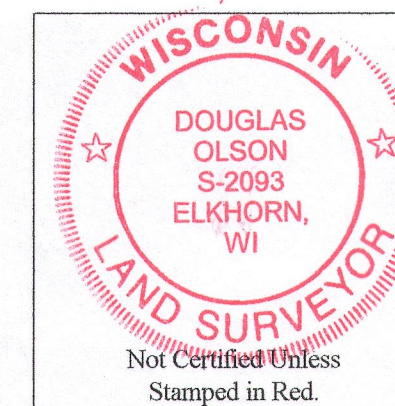

**Notes:**

- 1) This survey plat is not certified unless signed and sealed in red ink.
- 2) This survey is subject to Wisconsin lien laws. This Plat of Survey is the notice of intent to file lien. Lien waiver required.

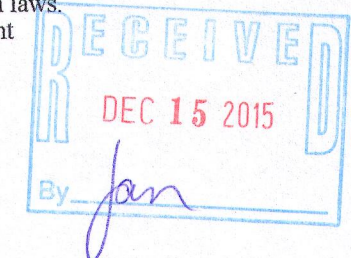

Copyright © 2015 by Olson Land Surveying, LLC.


All rights reserved. No part of this survey plat may be reproduced or transmitted in any form by any means - graphic, electronic, or mechanical, including photocopying, tracing, or information storage and retrieval systems - without permission in writing from Douglas G. Olson, Olson Land Surveying, LLC.

I hereby certify that I have surveyed the above described property and the map hereon is correct to the best of my professional knowledge and belief and shows the size and location of the property, its exterior boundaries, the location and dimensions of all visible structures thereon, boundary fences, apparent easements and roadways and visible encroachments, if any.


This survey is made for the exclusive use of the present owners of the property, and also those who purchase, mortgage or guarantee title thereto, within one year from the date hereof.

Douglas G. Olson  
Wisconsin Professional Land Surveyor - 2093

Tax Parcel  
HLG 340007A1

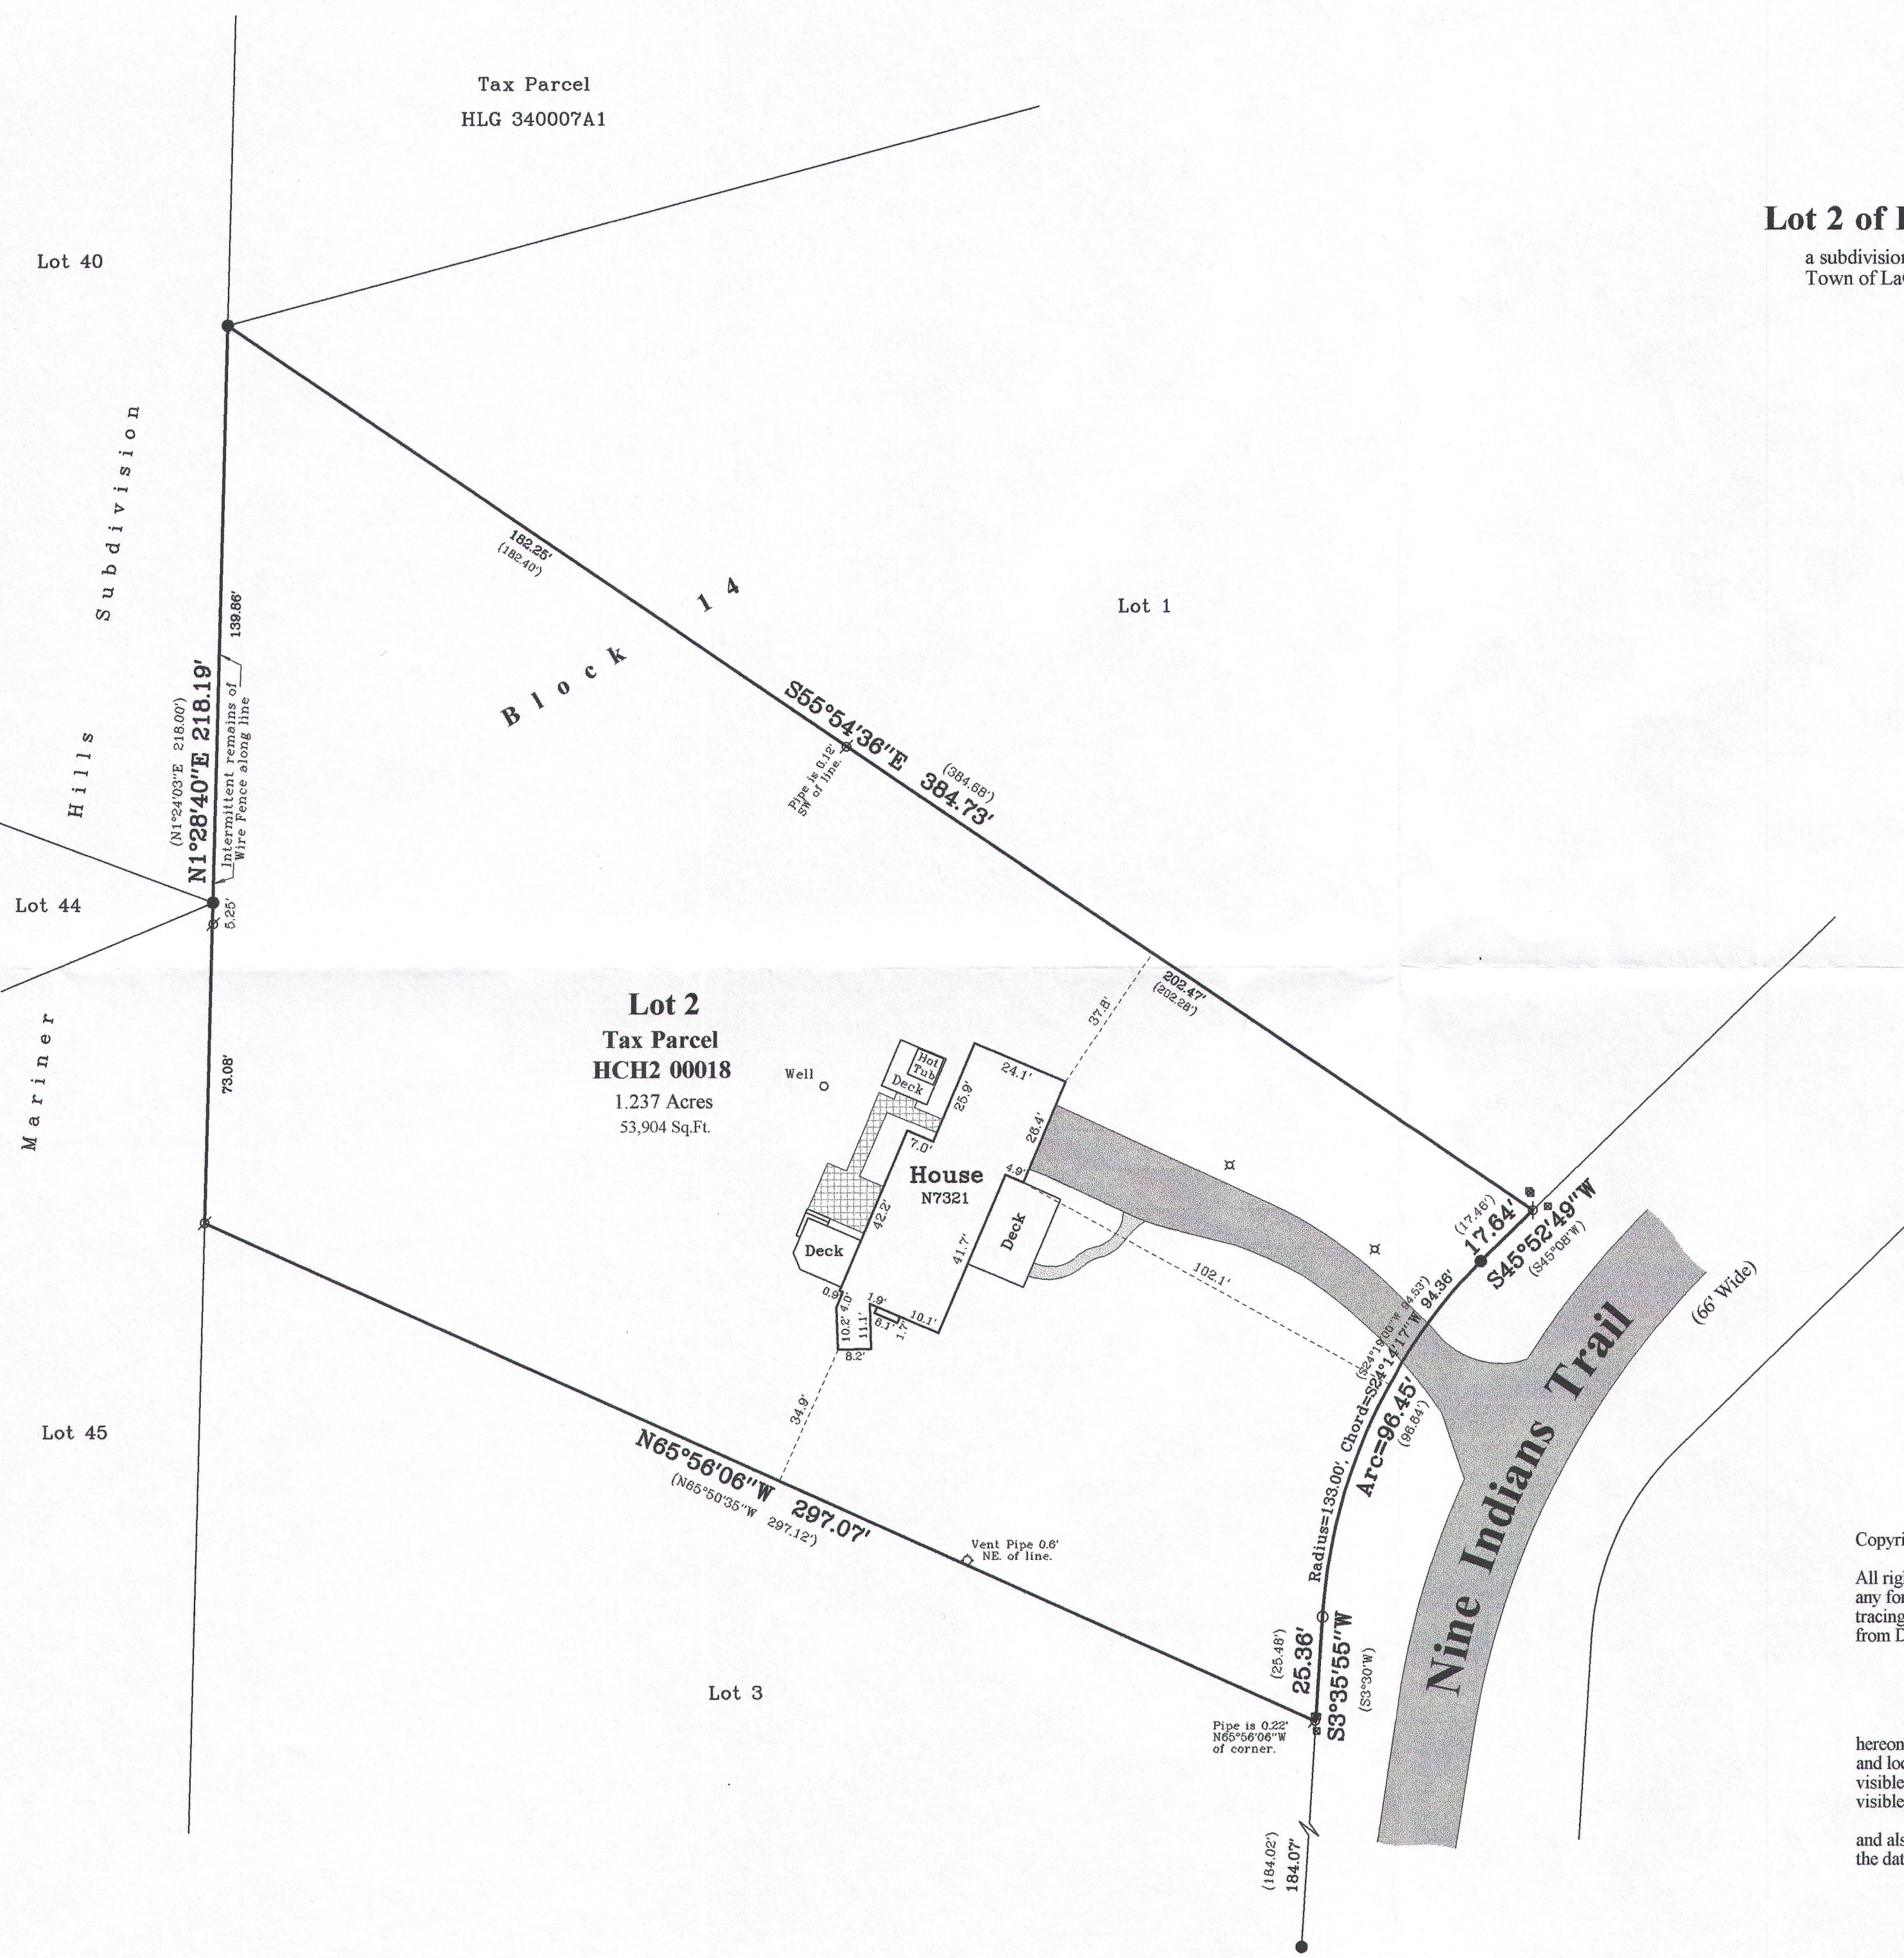

Survey Date: June 23, 2015.  
Revisions:

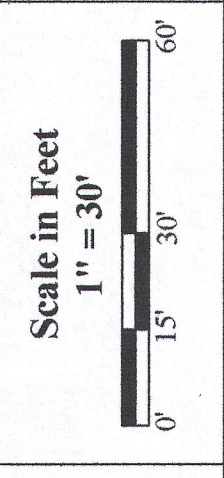

**Olson Land Surveying, LLC**  
45 South Wisconsin Street \* P.O. Box 322 \* Elkhorn, Wisconsin. 53121  
Telephone: (262) 723-3434 \* Facsimile: (262) 723-8044  
Email: doug@olsonsurveying.com

**Legend**  
 ○ Found Iron Pipe  
 ● Found Iron Pipe  
 ○ Set Iron Pipe, 1" dia.  
 ( ) Recorded Information  
 □ Utility Pedestal  
 ◇ Septic Vent  
 ▨ Asphalt Surface  
 ▩ Concrete Surface  
 ▧ Brick Pavers

Sheet 1 of 1 Sheets  
Drawing Name:  
Job Reference Number  
**2015.043**

**2015.043**

HCH2-18 416-2815