



BOUNDARY SURVEY
LOT 1 CSM 4357
RECORDED AS DOC. 815978
LOCATED IN THE NW 1/4 OF THE SE 1/4 SECTION 26
TOWN 4 NORTH, RANGE 16 EAST
WALWORTH COUNTY, WISCONSIN

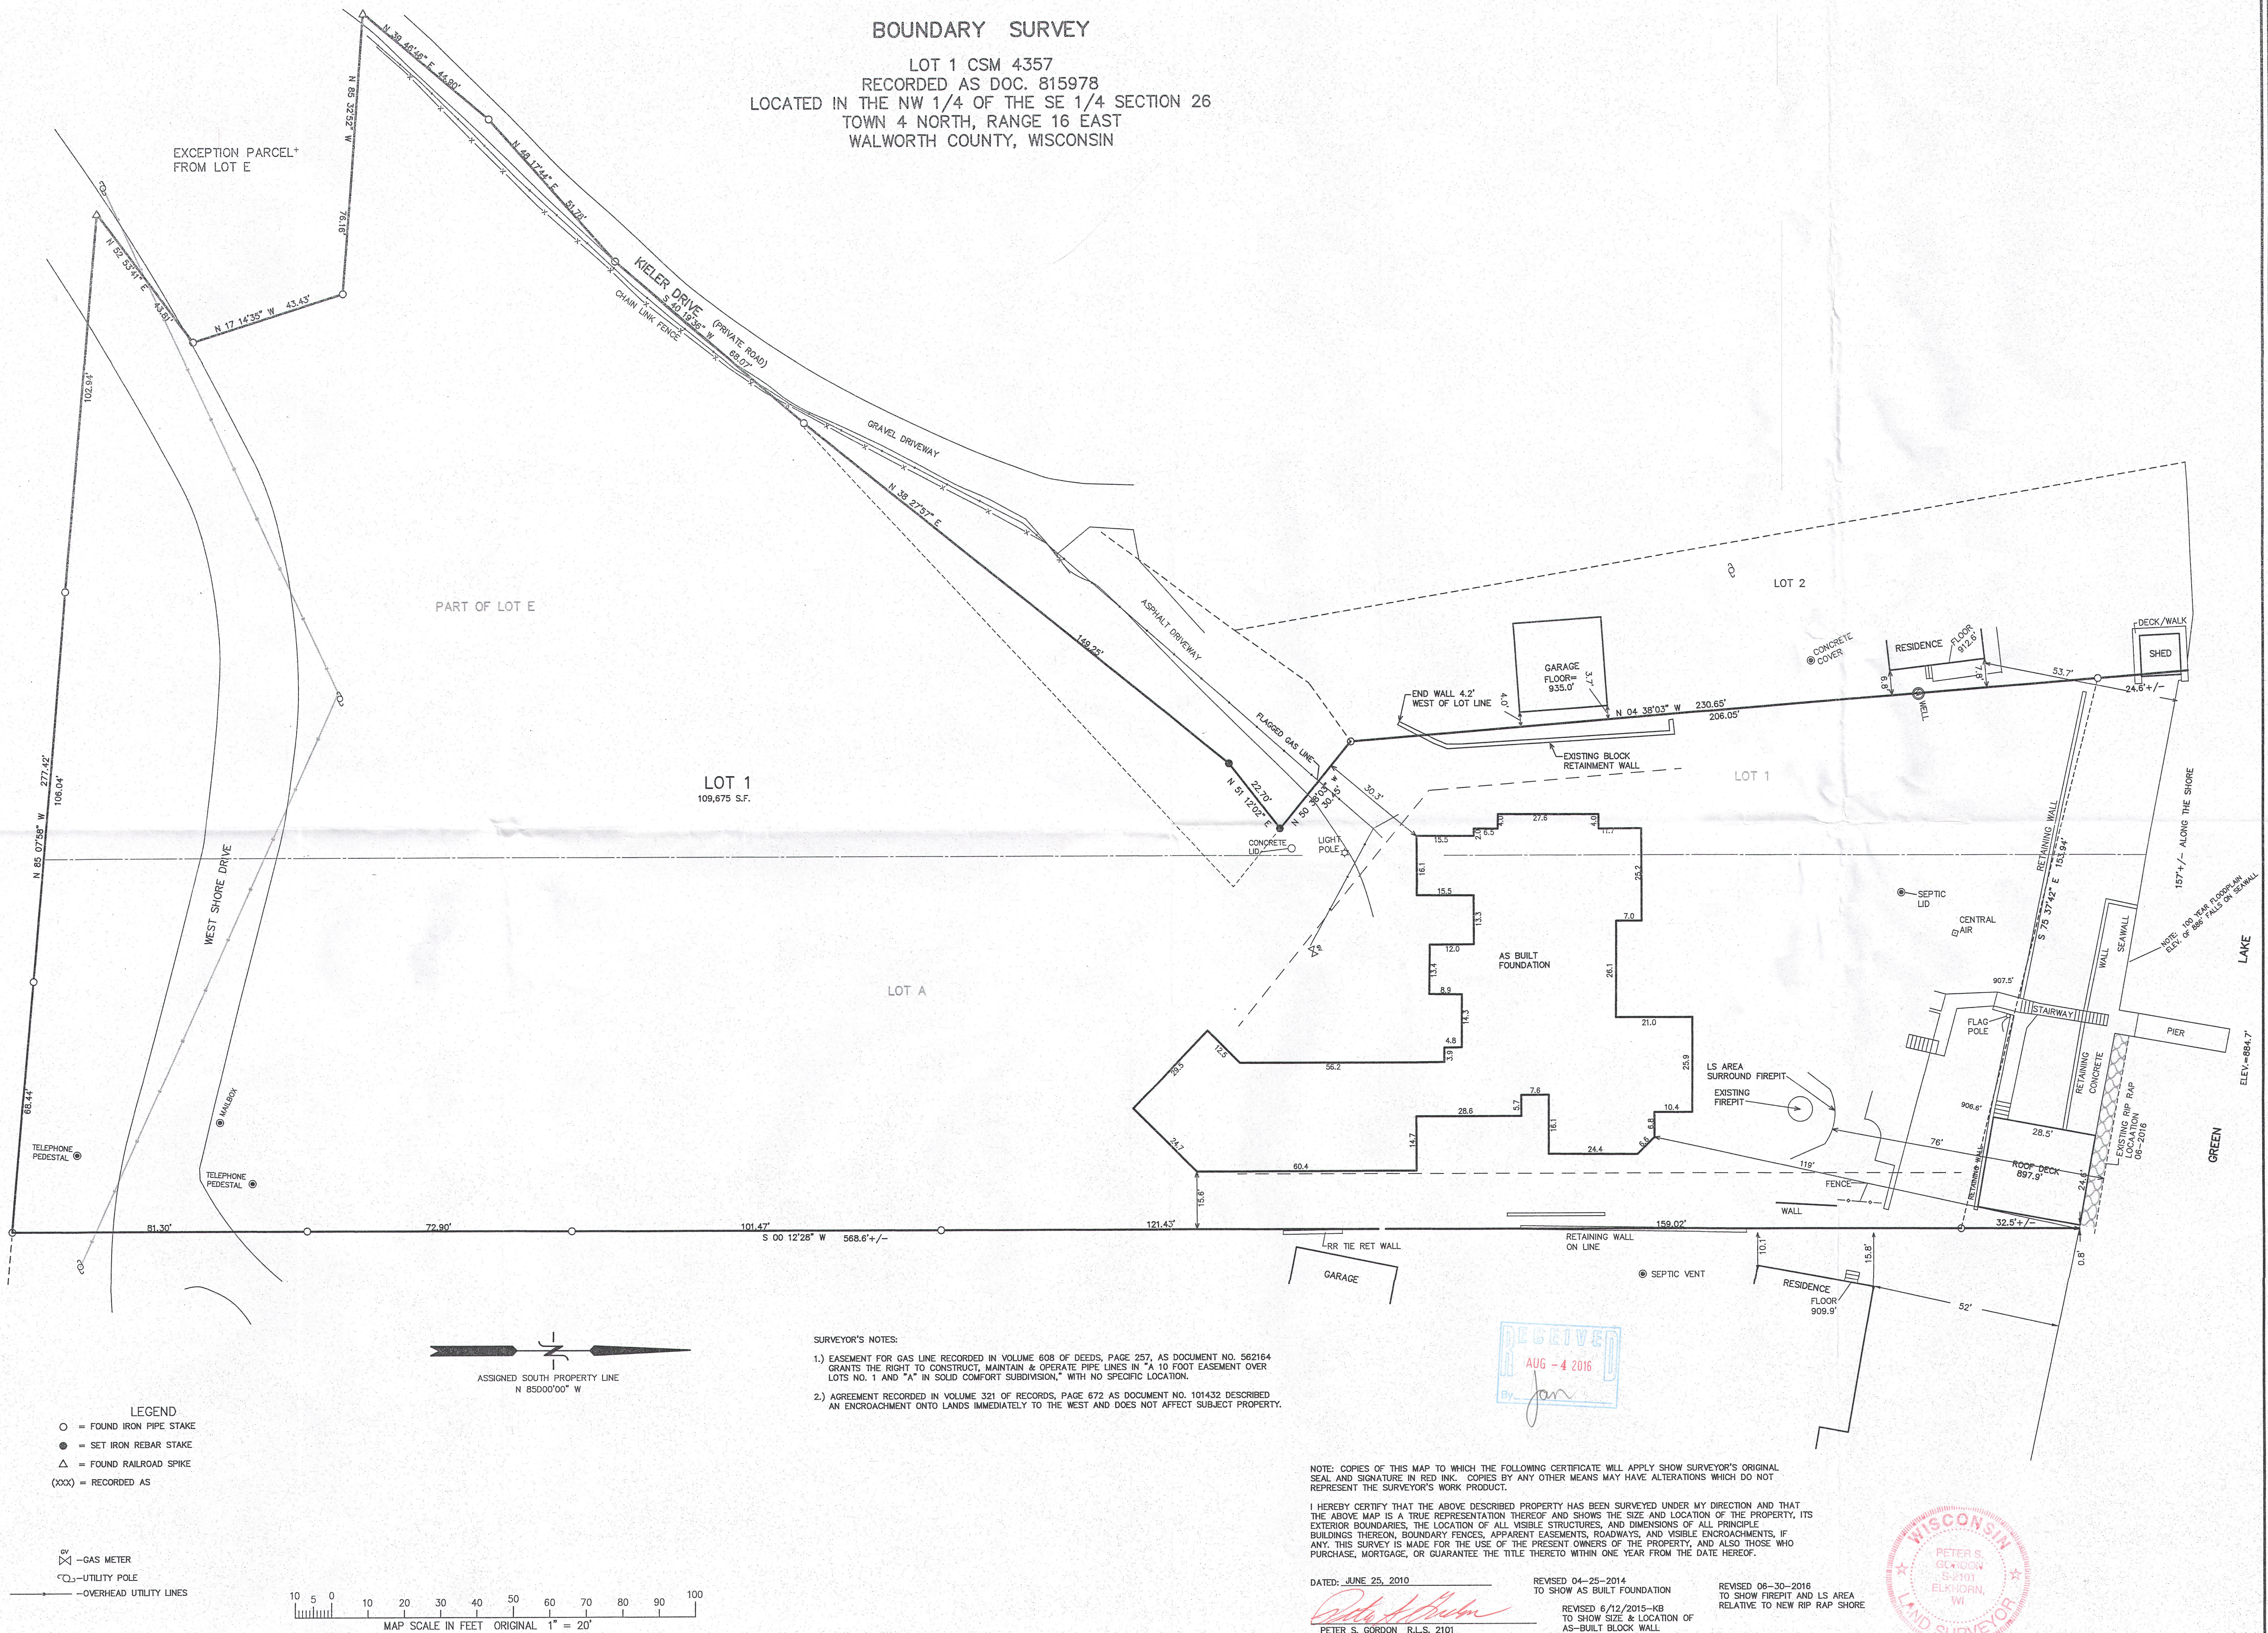

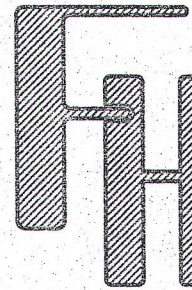

BOUNDARY SURVEY
ORDERED BY:
KEEFE REAL ESTATE
751 GENEVA PARKWAY
LAKE GENEVA, WI. 53147

TOPOGRAPHIC SURVEY
ORDERED BY:
THELEN TOTAL CONSTRUCTION
PO BOX 17
ELKHORN, WI. 53121

FARRIS, HANSEN & ASSOCIATES, INC.
ENGINEERING - ARCHITECTURE - SURVEYING
7 RIDGWAY COURT P.O. BOX 437
ELKHORN, WISCONSIN 53121
OFFICE: (262) 723-2098 FAX: (262) 723-5886

REVISIONS

PROJECT NO.	8182
DATE	06-23-2010
SHEET NO.	1 OF 1