PATHFINDER SURVEYING INC.
(formerly)
J.K. SURVEYING INC.
P.O BOX 322
LAKE GENEVA, WI. 53147
WWW.PATHFINDERSURVEYING.NET
262-248-8303

PLAT OF SURVEY

- OF -

LOT 2 LOST NATION ASSESSOR'S PLAT, ACCORDING TO THE RECORDED PLAT THEREOF. SAID LAND BEING IN THE TOWN OF LAGRANGE, COUNTY OF WALWORTH AND STATE OF WISCONSIN.

PREPARED FOR
JERRY KROUPA
KEEFE REAL ESTATE
ELKHORN WI.

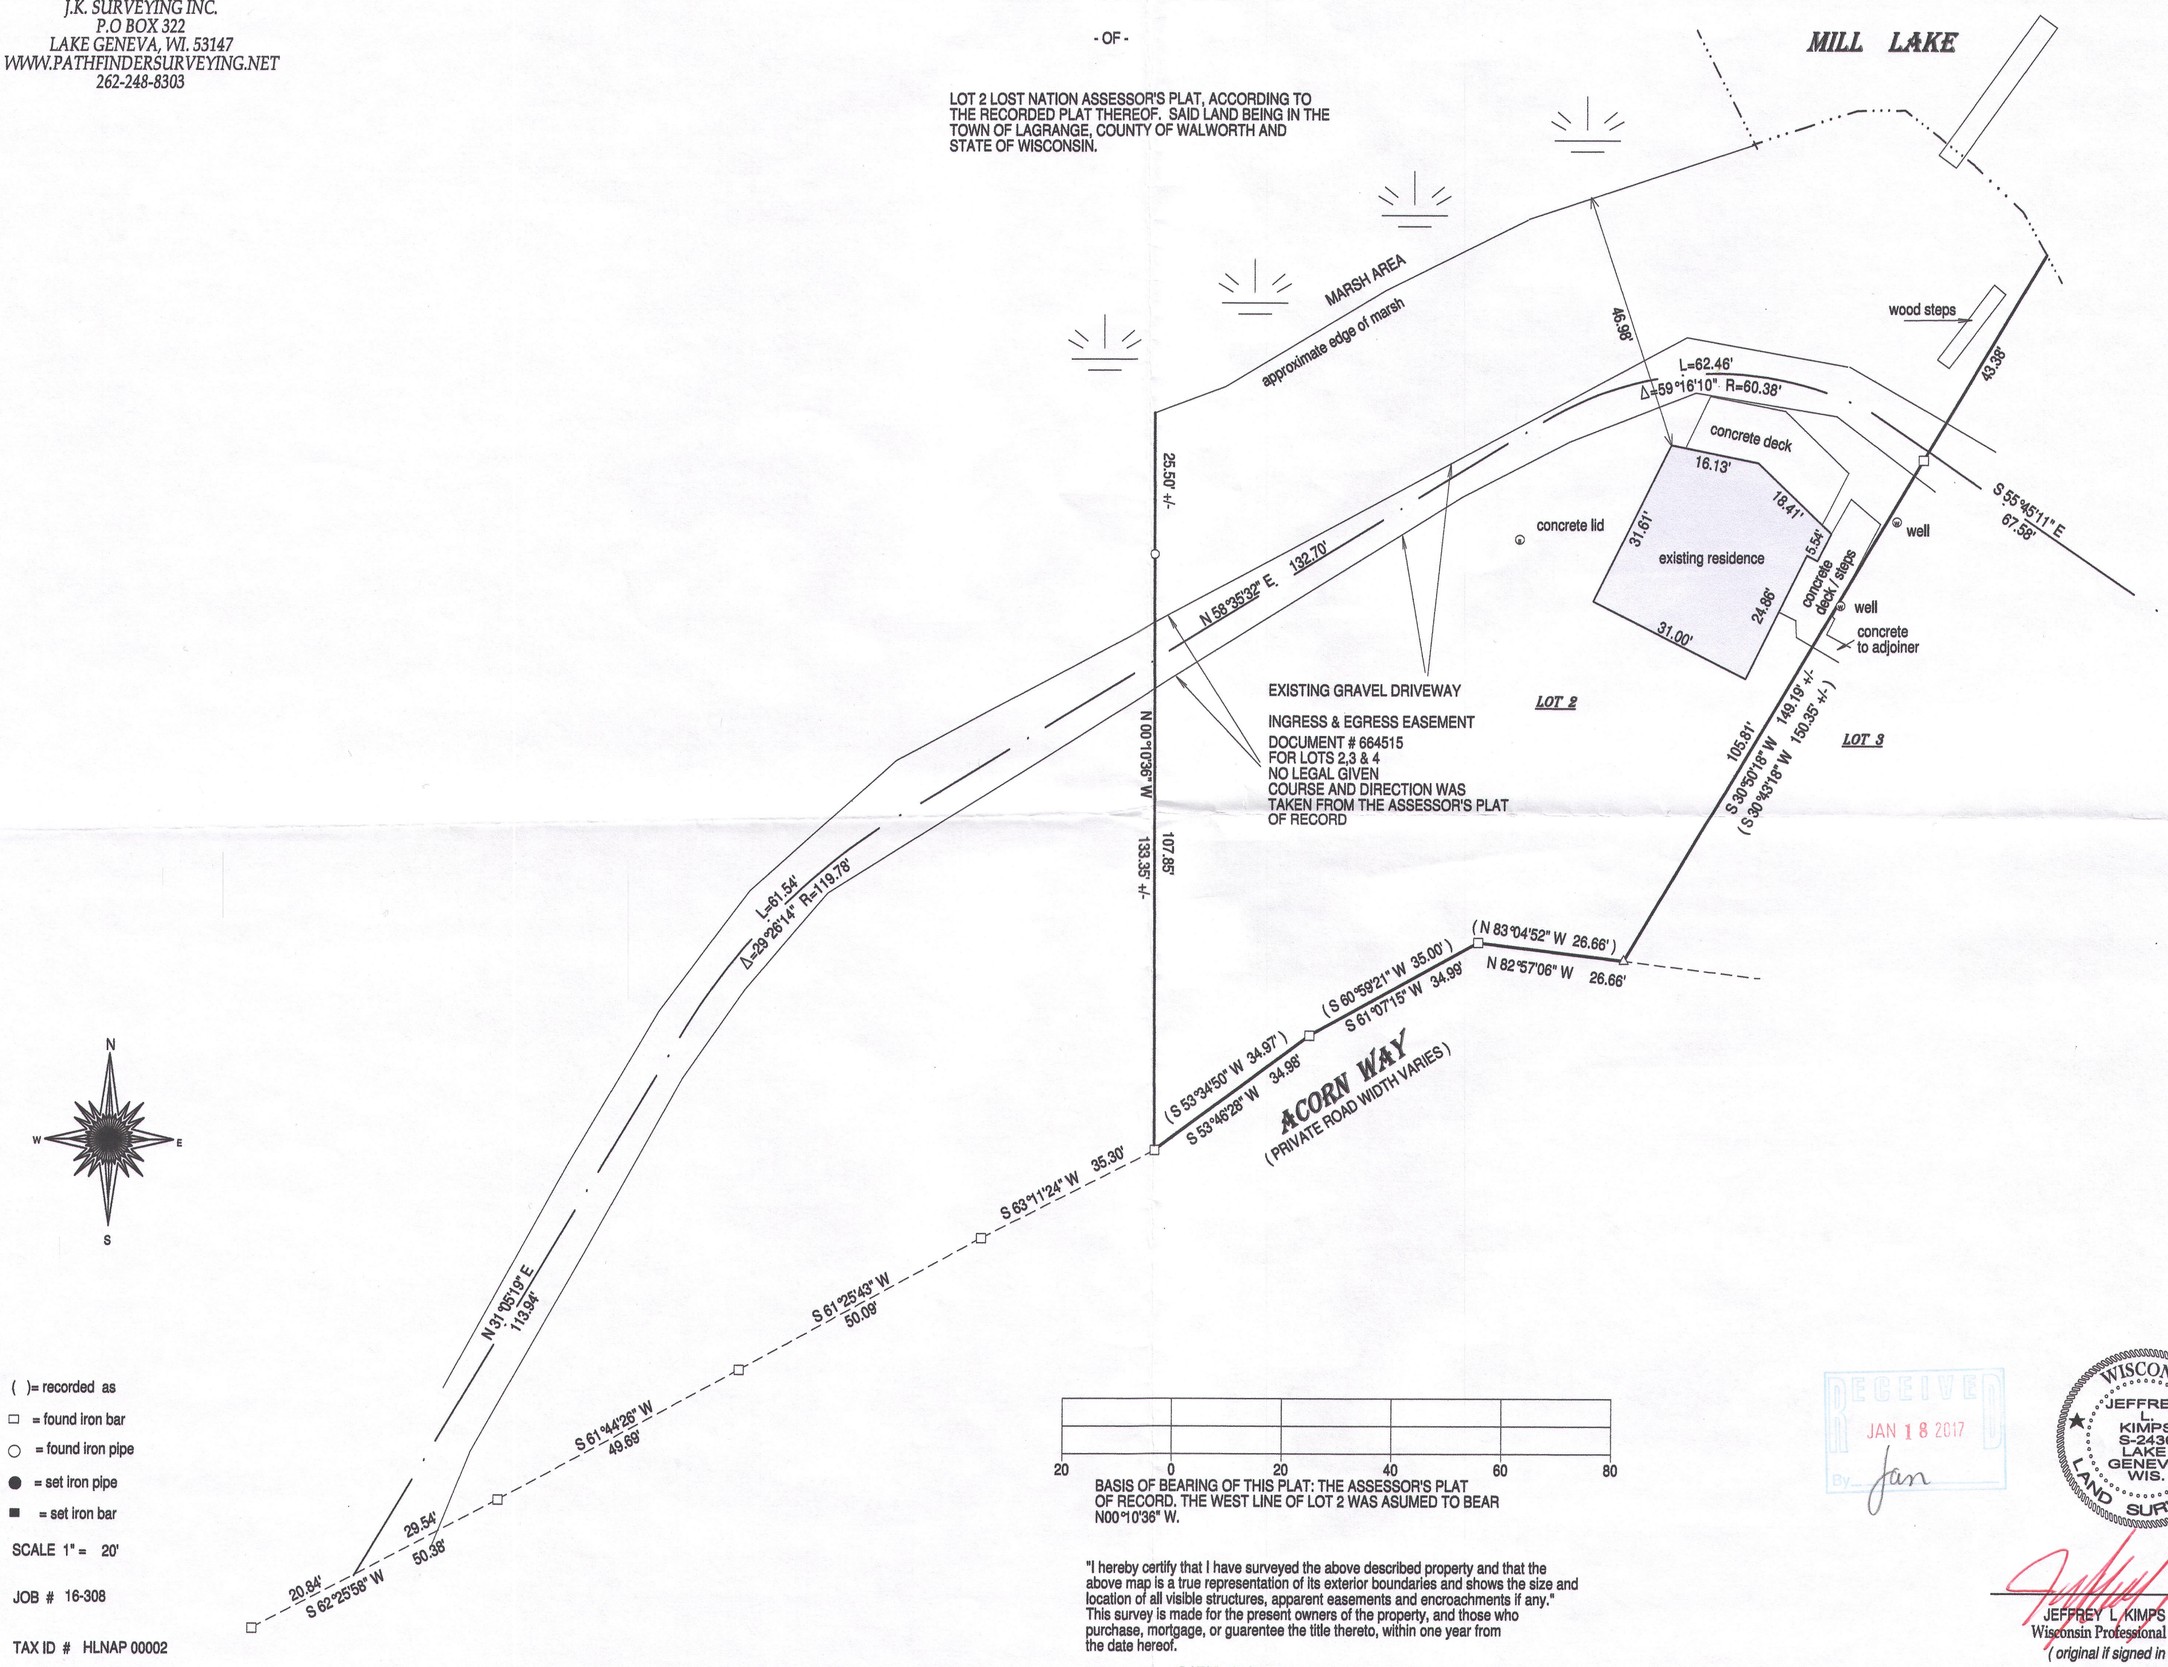

( )= recorded as
□ = found iron bar
○ = found iron pipe
● = set iron pipe
■ = set iron bar

SCALE 1" = 20'

JOB # 16-308

TAX ID # HLNAP 00002

BASIS OF BEARING OF THIS PLAT: THE ASSESSOR'S PLAT OF RECORD. THE WEST LINE OF LOT 2 WAS ASUMED TO BEAR N00°10'36" W.

"I hereby certify that I have surveyed the above described property and that the above map is a true representation of its exterior boundaries and shows the size and location of all visible structures, apparent easements and encroachments if any." This survey is made for the present owners of the property, and those who purchase, mortgage, or guarentee the title thereto, within one year from the date hereof.

DATED THIS 5TH DAY OF OCTOBER, 2016.

RECEIVED
JAN 18 2017
By Jan

WISCONSIN
JEFFREY L. KIMPS
S-2436
LAKE GENEVA, WIS.
LAND SURVEYOR

JEFFREY L. KIMPS S - 2436
Wisconsin Professional Land Surveyor
(original if signed in red)

HLNAP – 2 416 - 2893