

LAND-MARK SURVEYING

Mark L. Miritz

Wisconsin Professional Land Surveyor S-2582

N9330 Knuteson Drive
Whitewater, WI 53190
Phone: (262) 495-3284

MARKMIRITZ@


LAND-MARKSURVEYING.COM

PLAT OF SURVEY

LOT 22, LOST NATION ASSESSOR'S PLAT,
LOCATED IN GOVERNMENT LOT 2, SECTION
35, TOWN 4 NORTH, RANGE 16 EAST, TOWN
OF LAGRANGE, WALWORTH COUNTY, WISCONSIN

OWNER:

SAKMA FAMILY TRUST
C/O MARK OSTERMEIER
1655 EASTWOOD DRIVE
AURORA, IL 60506

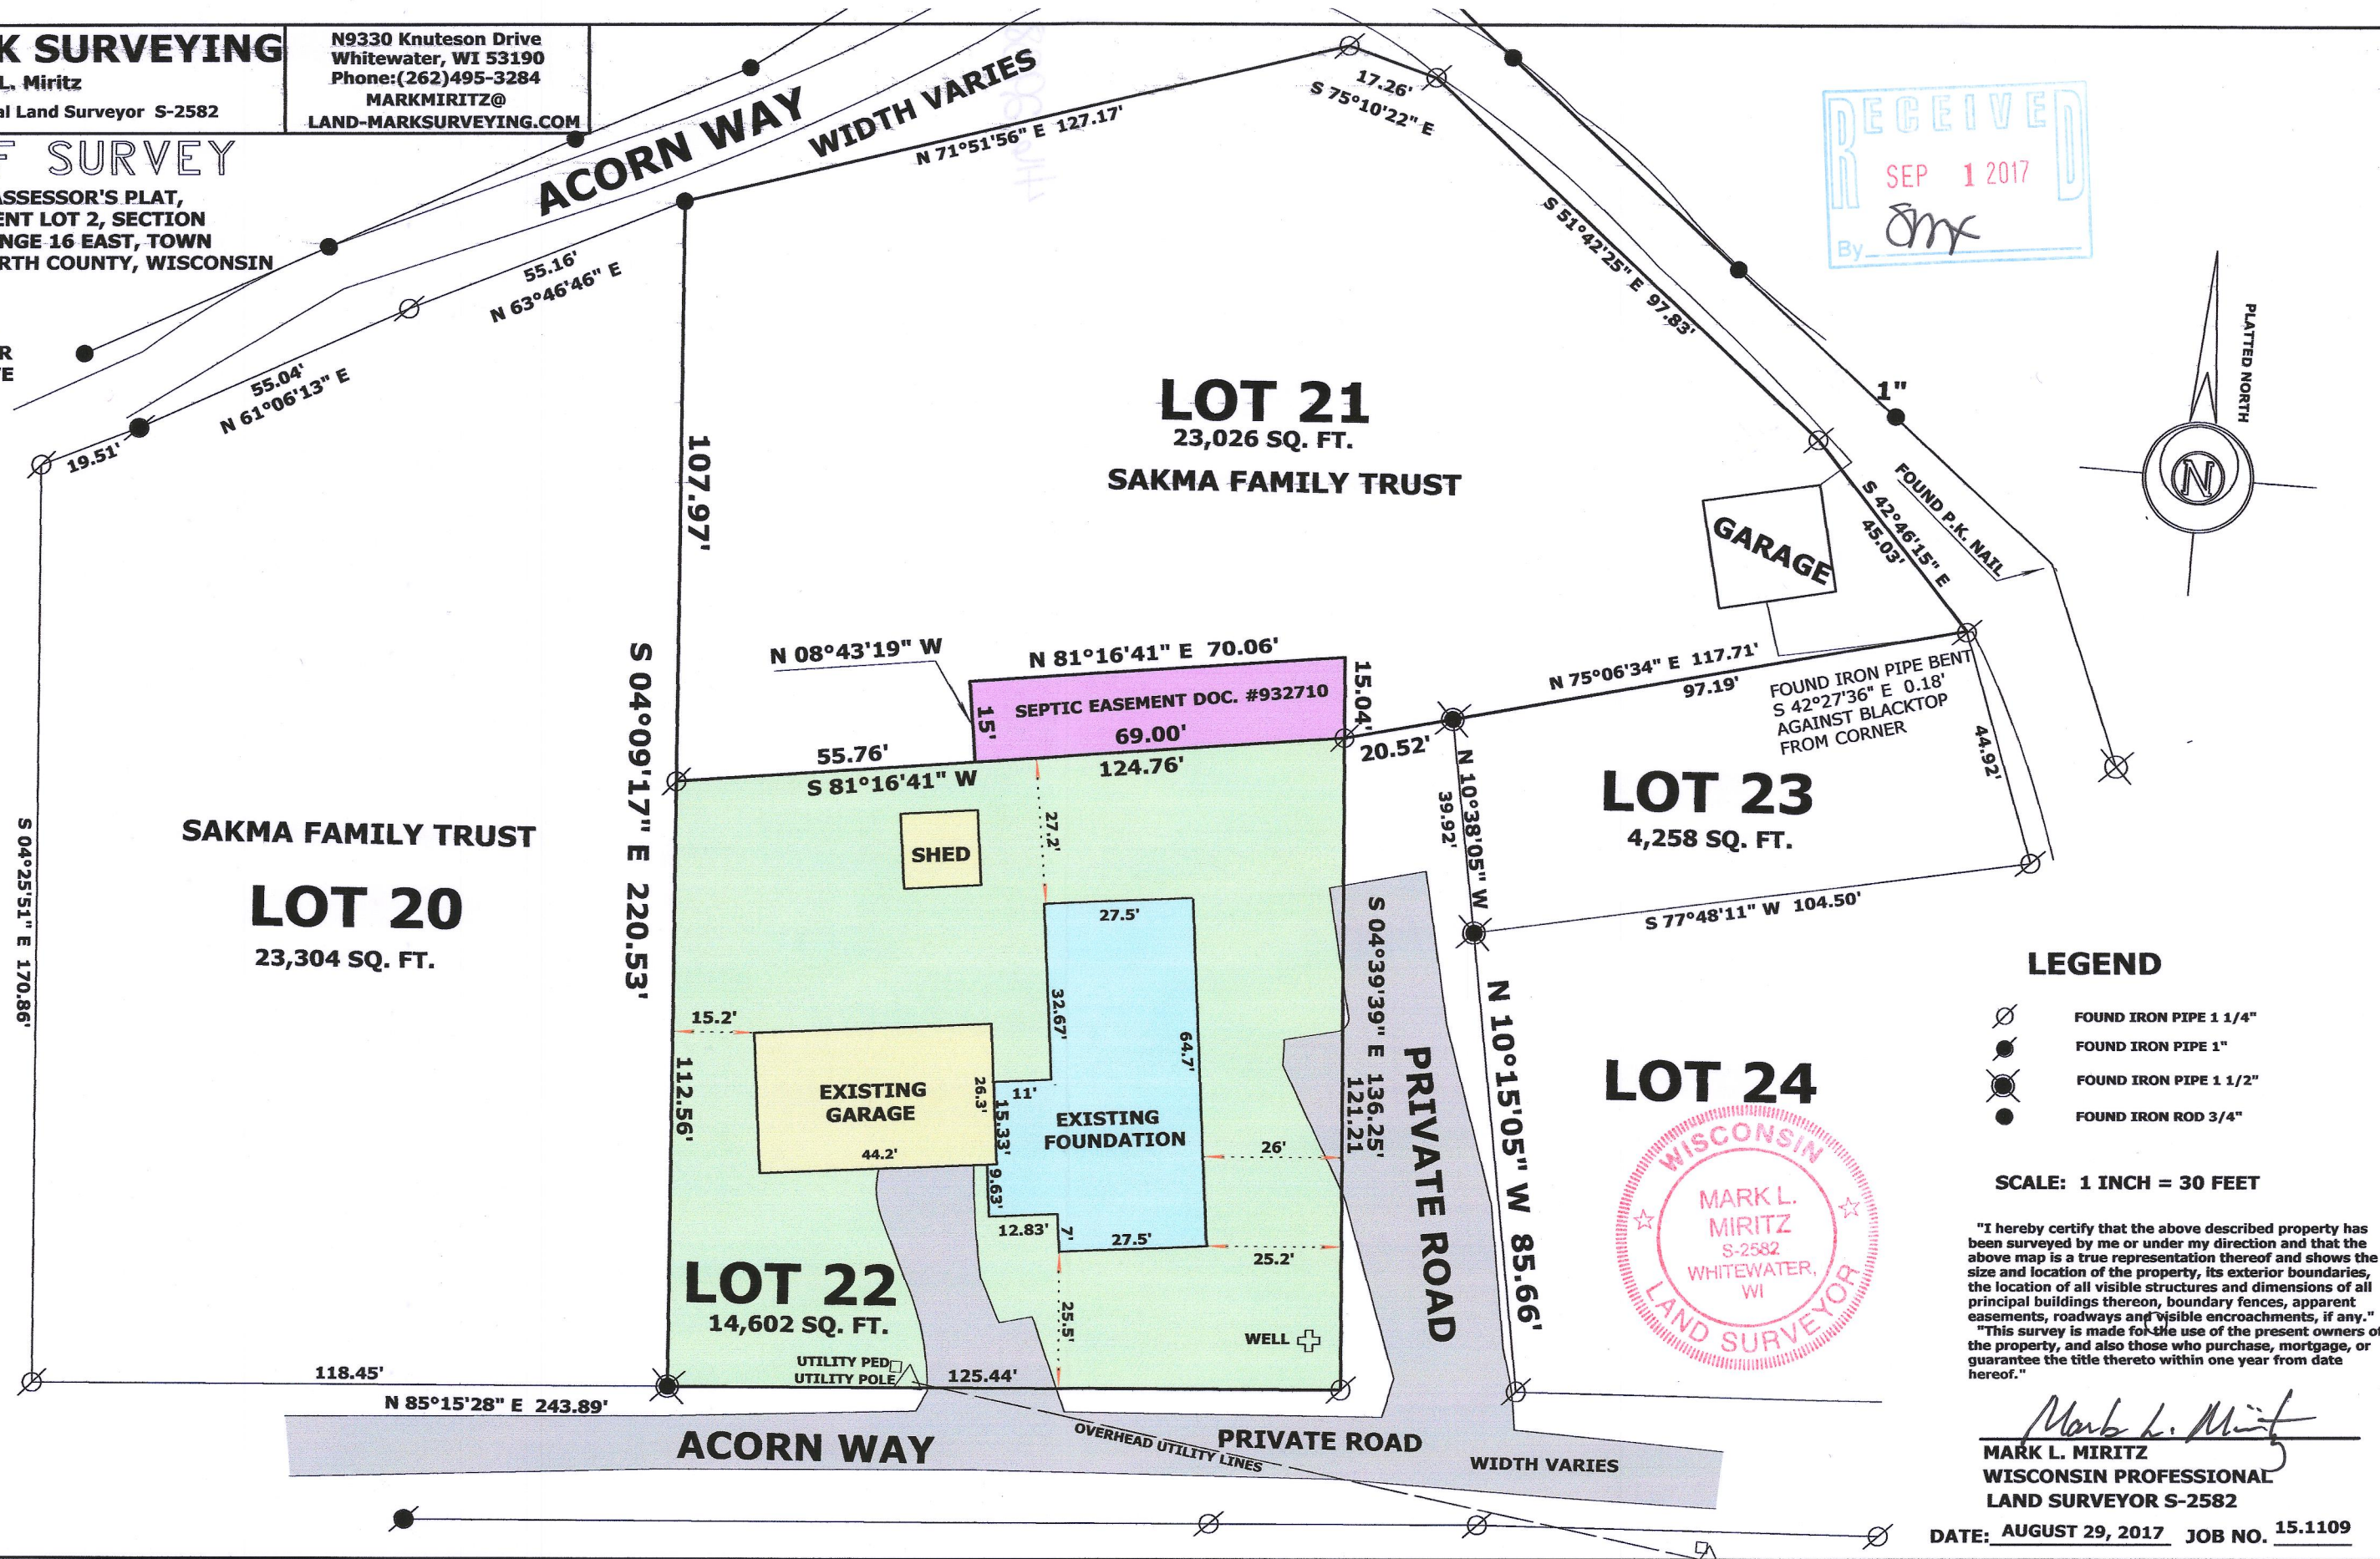

HLNAP-22

416-2938