


Mark L. Miritz

**N9330 Knuteson Drive
Whitewater, WI 53190
Phone: (262) 949-1239
MARKMIRITZ@
LAND-MARKSURVEYING.COM**

**ORDERED BY:
MICK BALESTRIERI
KEEFE REAL ESTATE
751 GENEVA PARKWAY
LAKE GENEVA, WI 53147**

**LOT 23, BLOCK 1, PEBBLE BEACH SUBDIVISION, LOCATED
IN THE NORTHEAST 1/4 OF SECTION 26, TOWN 4 NORTH,
RANGE 16 EAST, TOWN OF LAGRANGE, WALWORTH
COUNTY, WISCONSIN.**

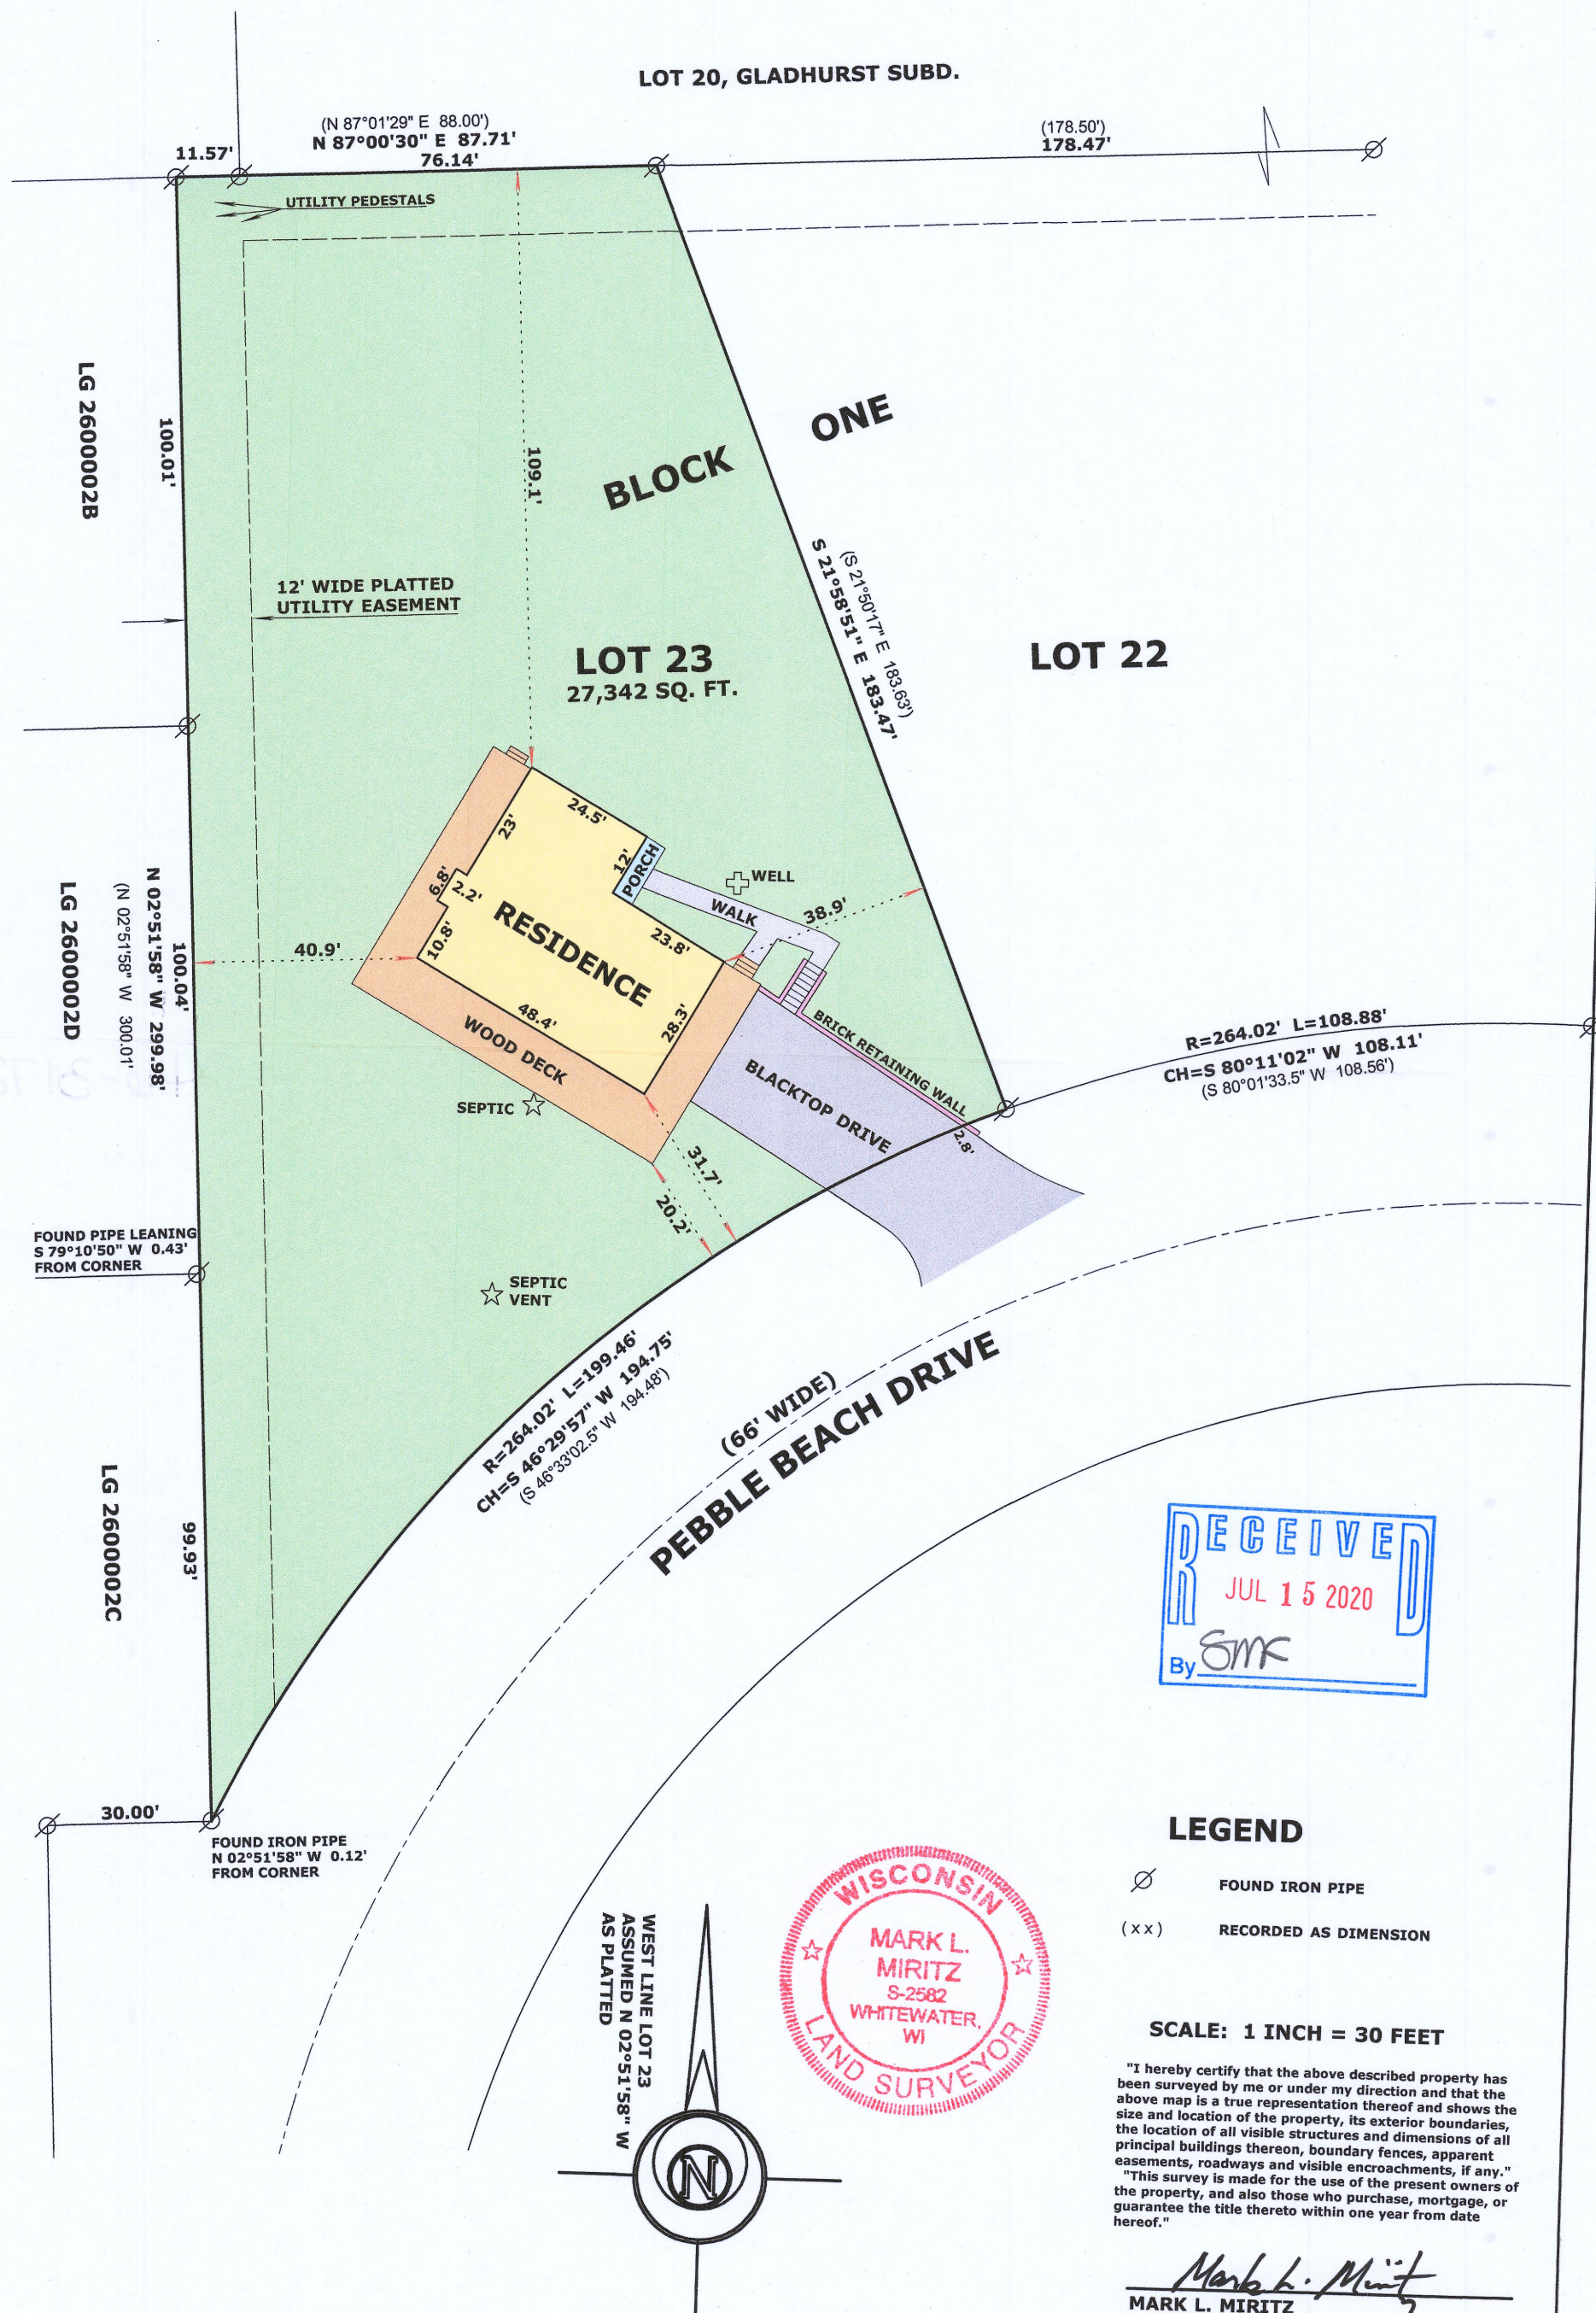

HPE - 23