LAND-MARK SURVEYING
Mark L. Miritz
Wisconsin Professional Land Surveyor S-2582

N9330 Knuteson Drive
Whitewater, WI 53190
Phone:(262)949-1239
MARKMIRITZ@
LAND-MARKSURVEYING.COM

PLAT OF SURVEY

OWNER:
GUSTAFSON LAKEHOUSE 1 LLC
241 OVERLOOK DRIVE
LAKE FOREST, IL 60045

LEGEND
- ∅ FOUND IRON PIPE 1 1/4"
- ● FOUND IRON ROD 3/4"
- (XX) RECORDED AS DIMENSION

Lots 7 and 8 of Droughtville Park as recorded in Vol 5 of Walworth County Plats as Page 145, located in the Southwest 1/4 of Section 25, Town 4 North, Range16 East, Walworth County, Wisconsin, except that part of Lot 8 lying Southwesterly from a line, which line is described as follows: Commencing at the most Southerly corner of said Lot 8; Thence N 53°09'16" W on a straight line that is 0.5 feet perpendicular from the most Easterly corner corner of a boathouse, 199.72 feet to the shore of Middle Lake.

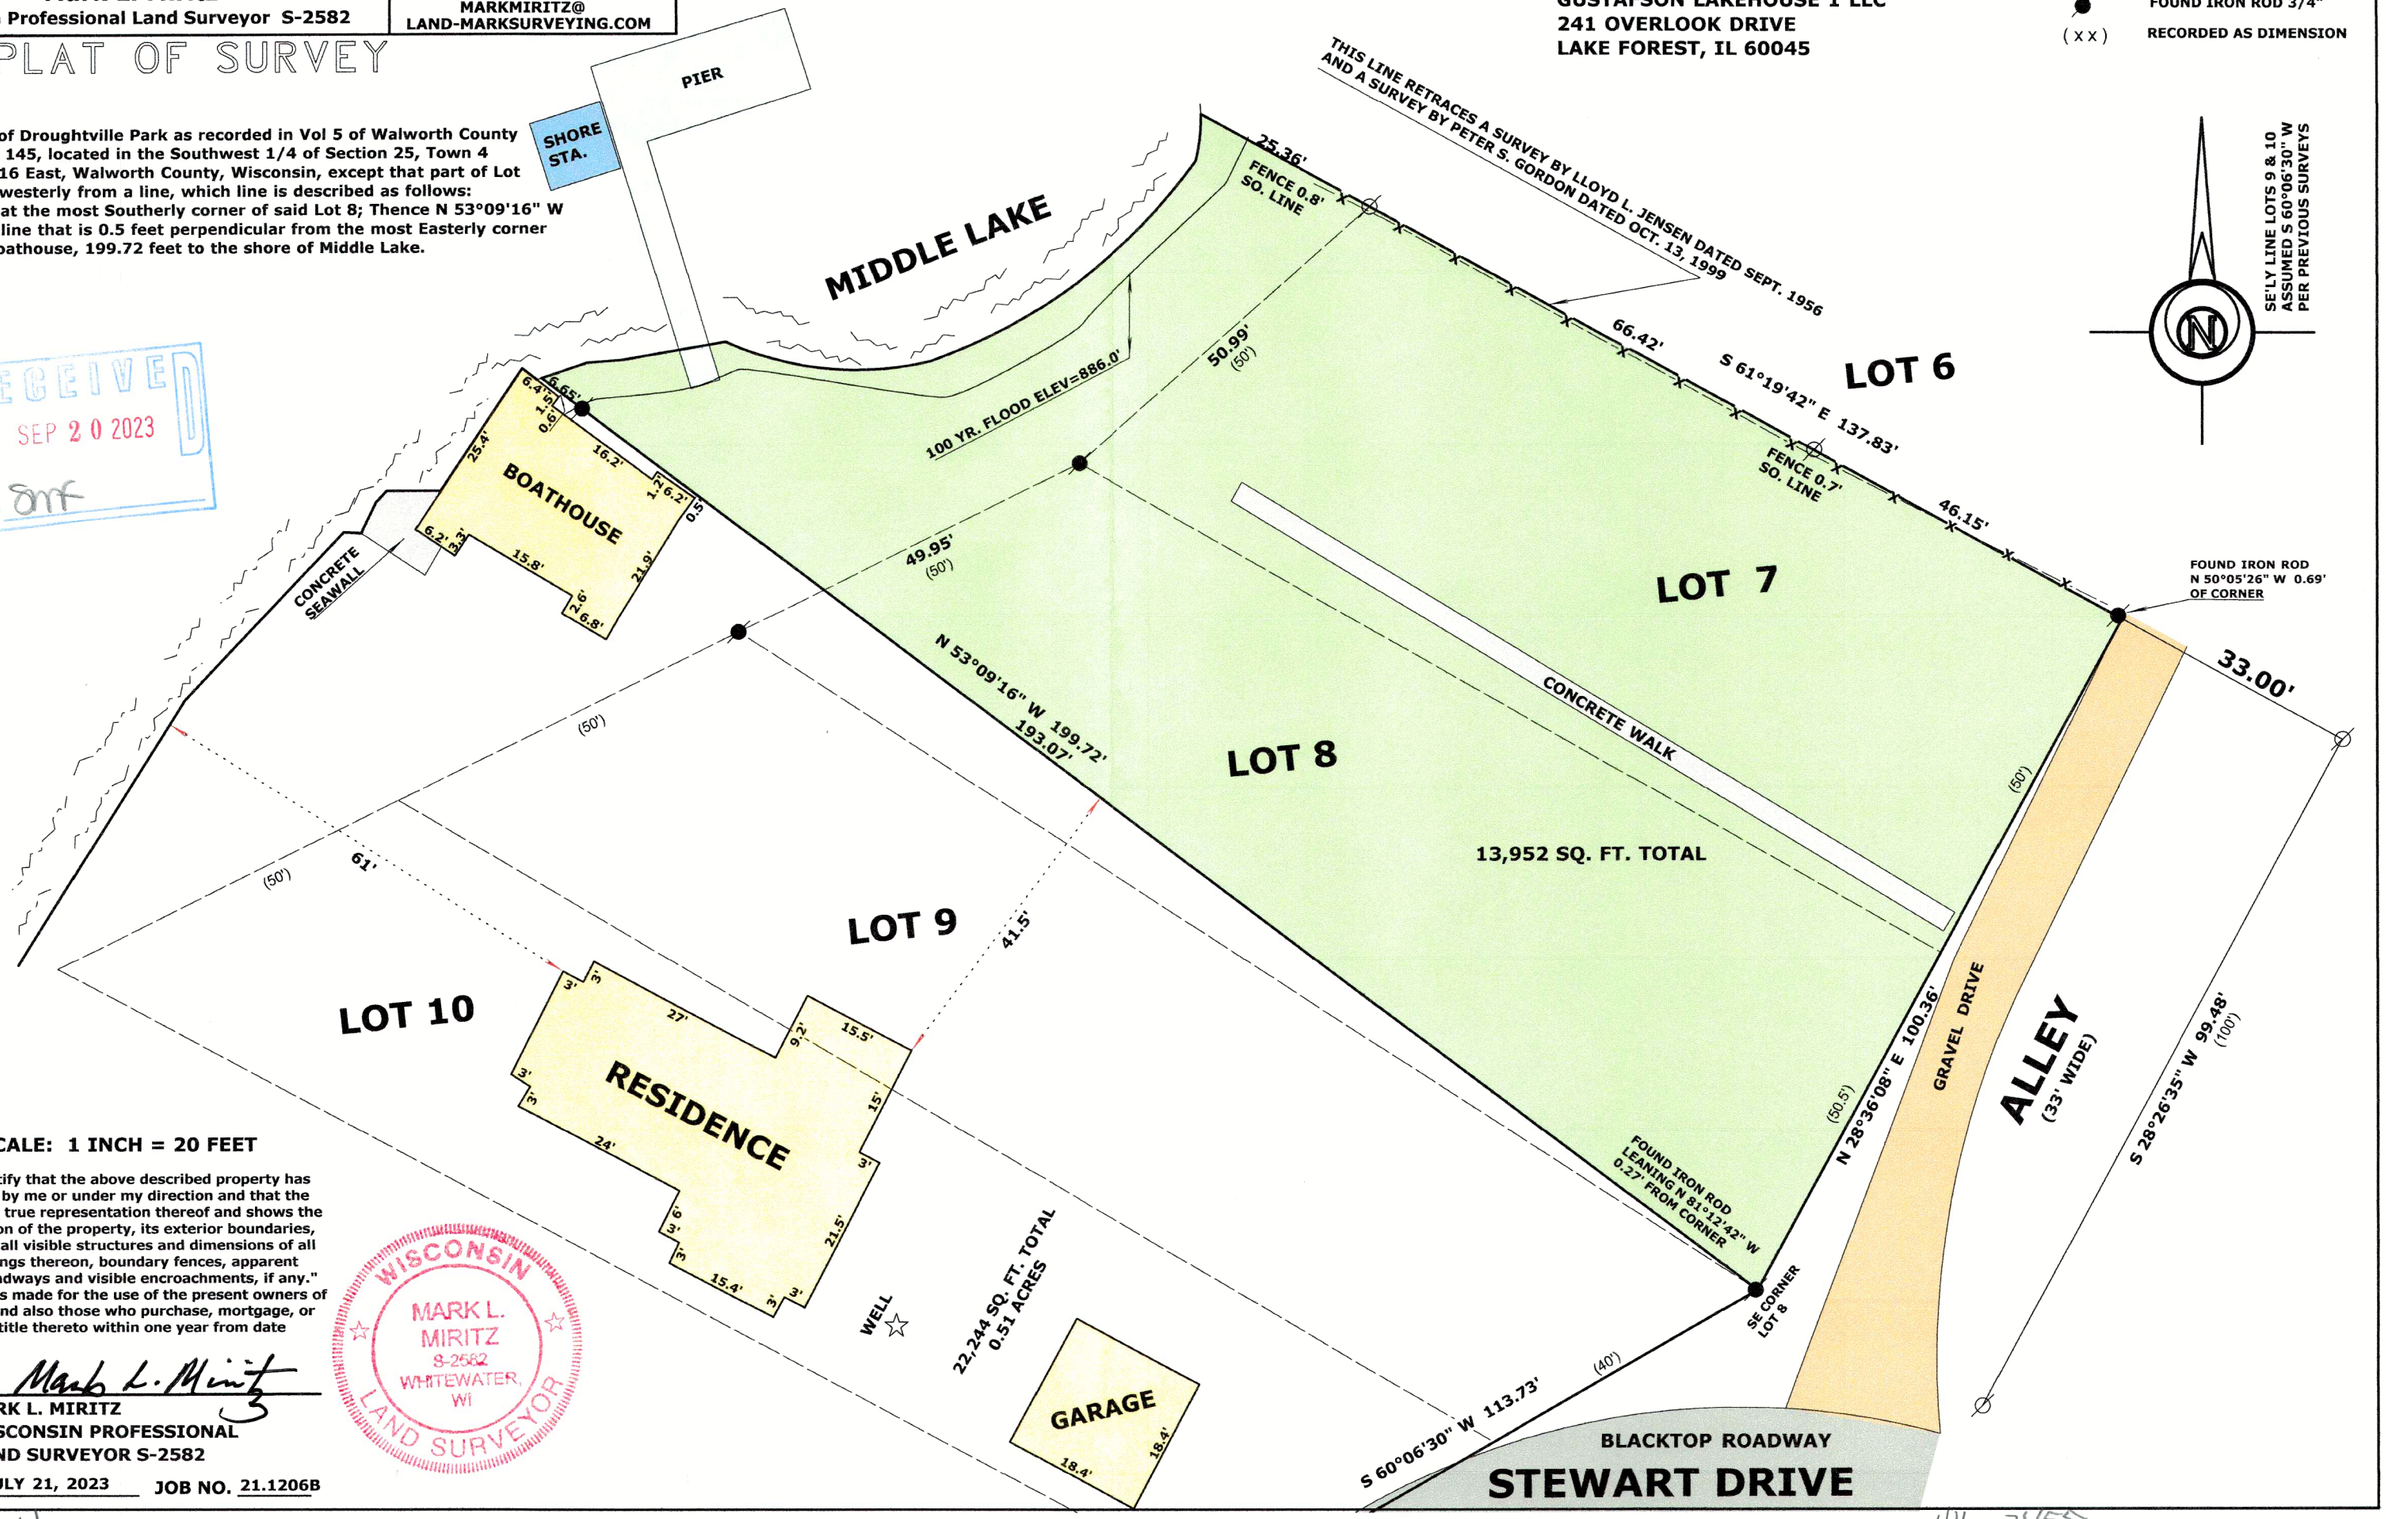

RECEIVED
SEP 20 2023
By: mf

SCALE: 1 INCH = 20 FEET

"I hereby certify that the above described property has been surveyed by me or under my direction and that the above map is a true representation thereof and shows the size and location of the property, its exterior boundaries, the location of all visible structures and dimensions of all principal buildings thereon, boundary fences, apparent easements, roadways and visible encroachments, if any."
"This survey is made for the use of the present owners of the property, and also those who purchase, mortgage, or guarantee the title thereto within one year from date hereof."

Mark L. Miritz

MARK L. MIRITZ
WISCONSIN PROFESSIONAL
LAND SURVEYOR S-2582

WISCONSIN MARK L. MIRITZ S-2582 WHITEWATER, WI LAND SURVEYOR

DATE: JULY 21, 2023 **JOB NO.** 21.1206B

HDP-14

416 3455