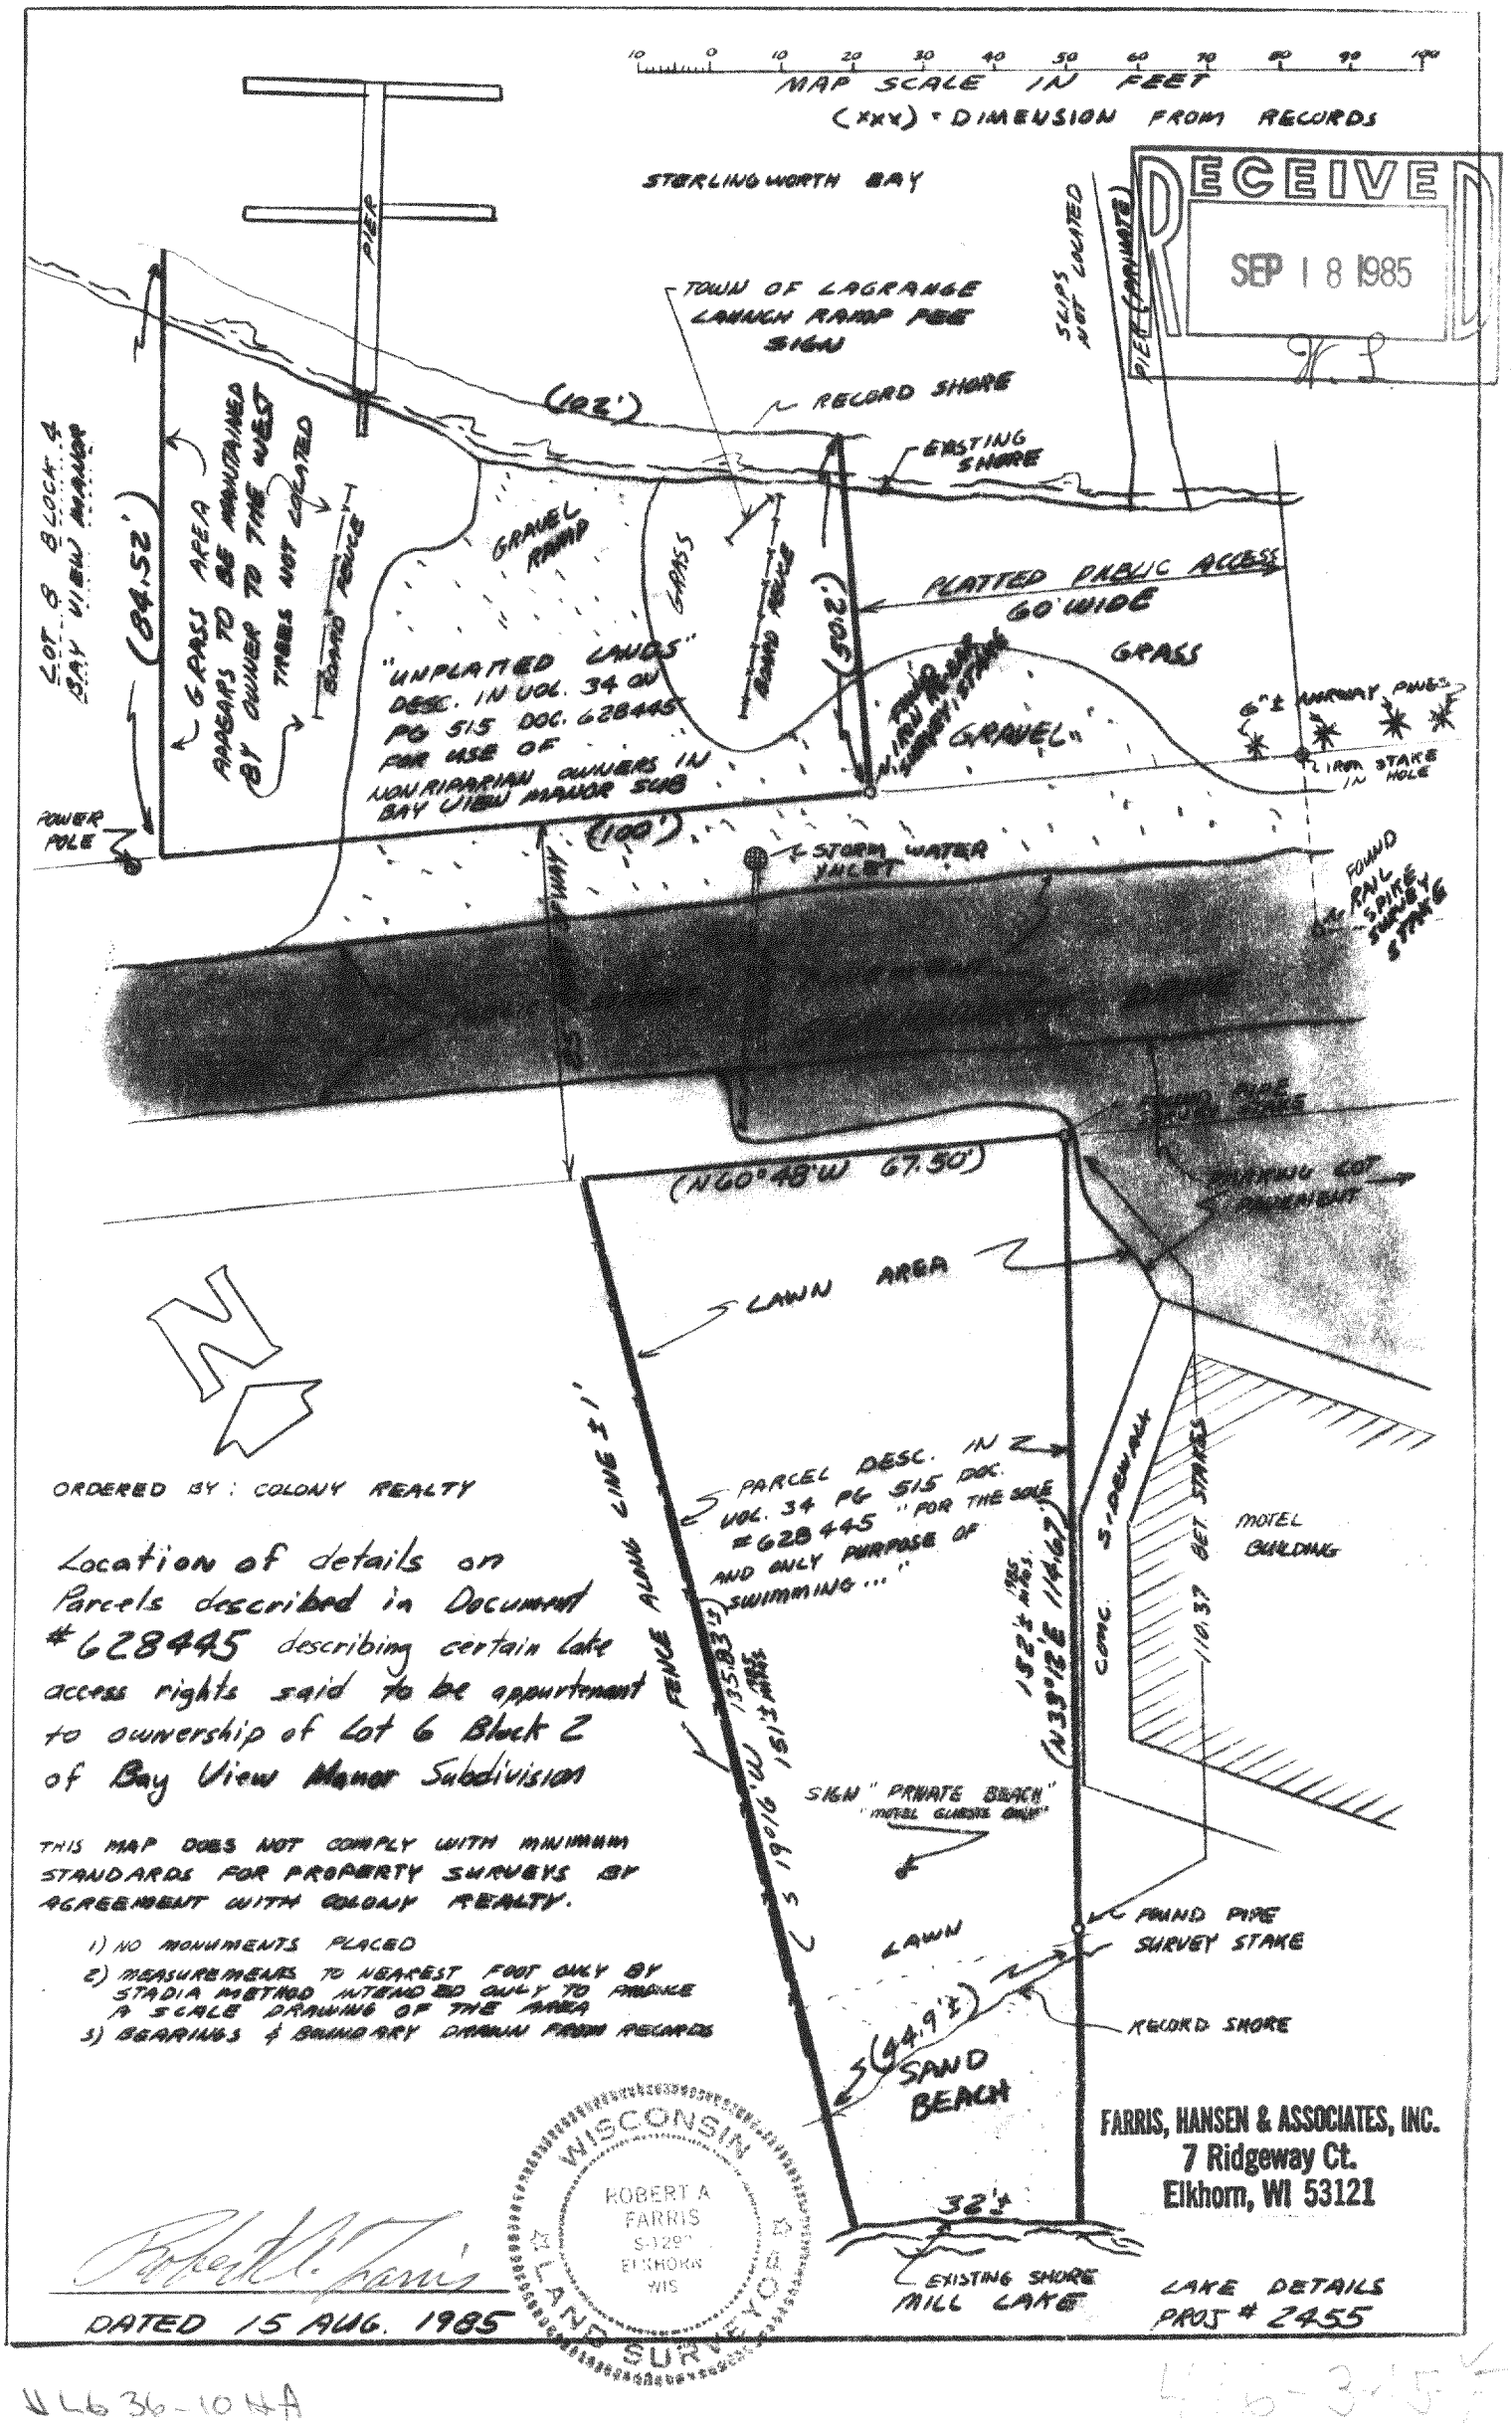

Location of details on Parcels described in Document #628445 describing certain Lake access rights said to be appurtenant to ownership of Lot 6 Block 2 of Bay View Manor Subdivision

THIS MAP DOES NOT COMPLY WITH MINIMUM STANDARDS FOR PROPERTY SURVEYS BY AGREEMENT WITH COLONY REALTY.

1) NO MONUMENTS PLACED
2) MEASUREMENTS TO NEAREST FOOT ONLY BY STADIA METHOD INTENDED ONLY TO PRODUCE A SCALE DRAWING OF THE AREA
3) BEARINGS & BOUNDARY DRAWN FROM RECORDS

WISCONSIN ROBERT A FARRIS S-1292 ELKHORN WIS LAND SURVEYOR

Robert A. Farris

DATED 15 AUG. 1985

FARRIS, HANSEN & ASSOCIATES, INC.
7 Ridgeway Ct.
Elkhorn, WI 53121

RECEIVED SEP 18 1985

WL636-10HA

416-345