

LAND-MARK SURVEYING

Mark L. Miritz


Wisconsin Professional Land Surveyor S-2582

**N9330 Knuteson Drive
Whitewater, WI 53190
Phone: (262) 949-1239**

**MARKMIRITZ@
LAND-MARKSURVEYING.COM**

PLAT OF SURVEY

CERTIFIED SURVEY MAP NO. 2041 LOCATED IN PART OF THE NORTHEAST 1/4 OF THE NORTHWEST 1/4 AND PART OF THE NORTHWEST 1/4 OF THE NORTHEAST 1/4 OF SECTION 8, TOWN 4 NORTH, RANGE 16 EAST, TOWN OF LAGRANGE, WALWORTH COUNTY, WISCONSIN.

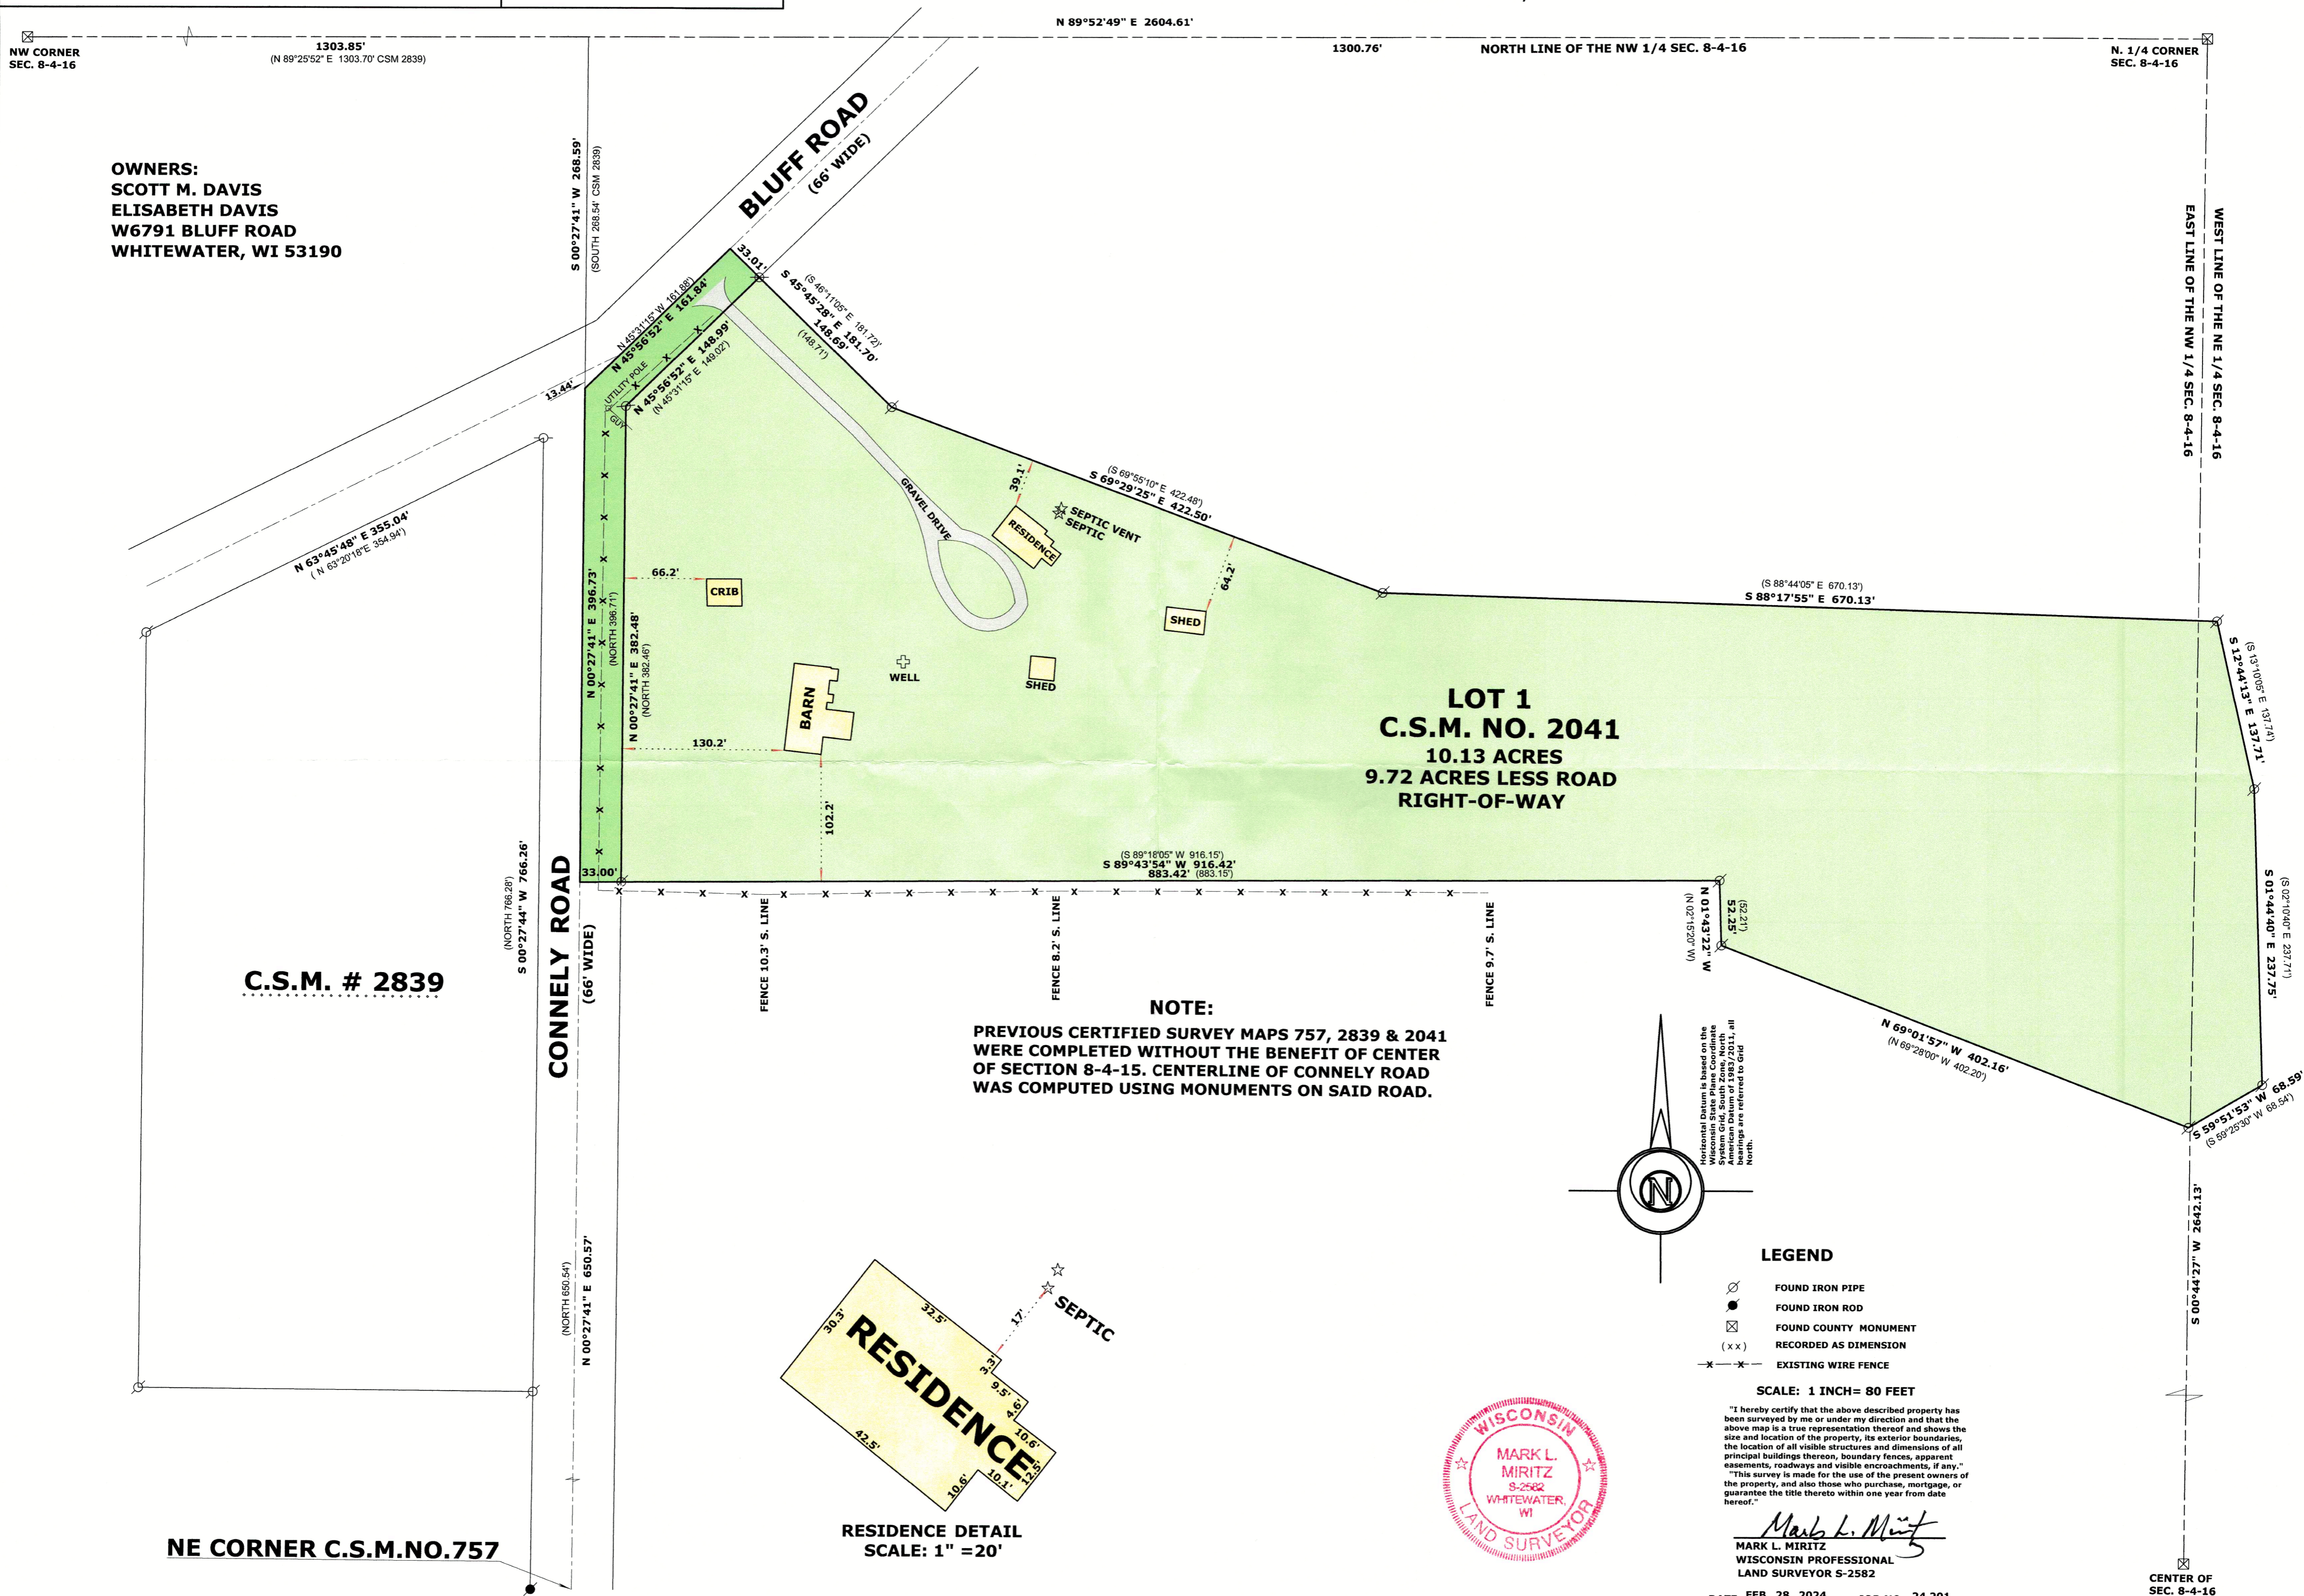

414-3533

416-5533