# AS BUILT MAPPING

## LOT 2 OF CERTIFIED SURVEY MAP NO. 3584

RECORDED IN VOLUME 21 ON PAGE 130 AS DOCUMENT NO. 568652
LOCATED IN PART OF THE NW 1/4 & THE SW 1/4 OF THE NW 1/4 OF SECTION 19,
TOWN 4 NORTH, RANGE 17 EAST, TOWN OF TROY, WALWORTH COUNTY, WISCONSIN

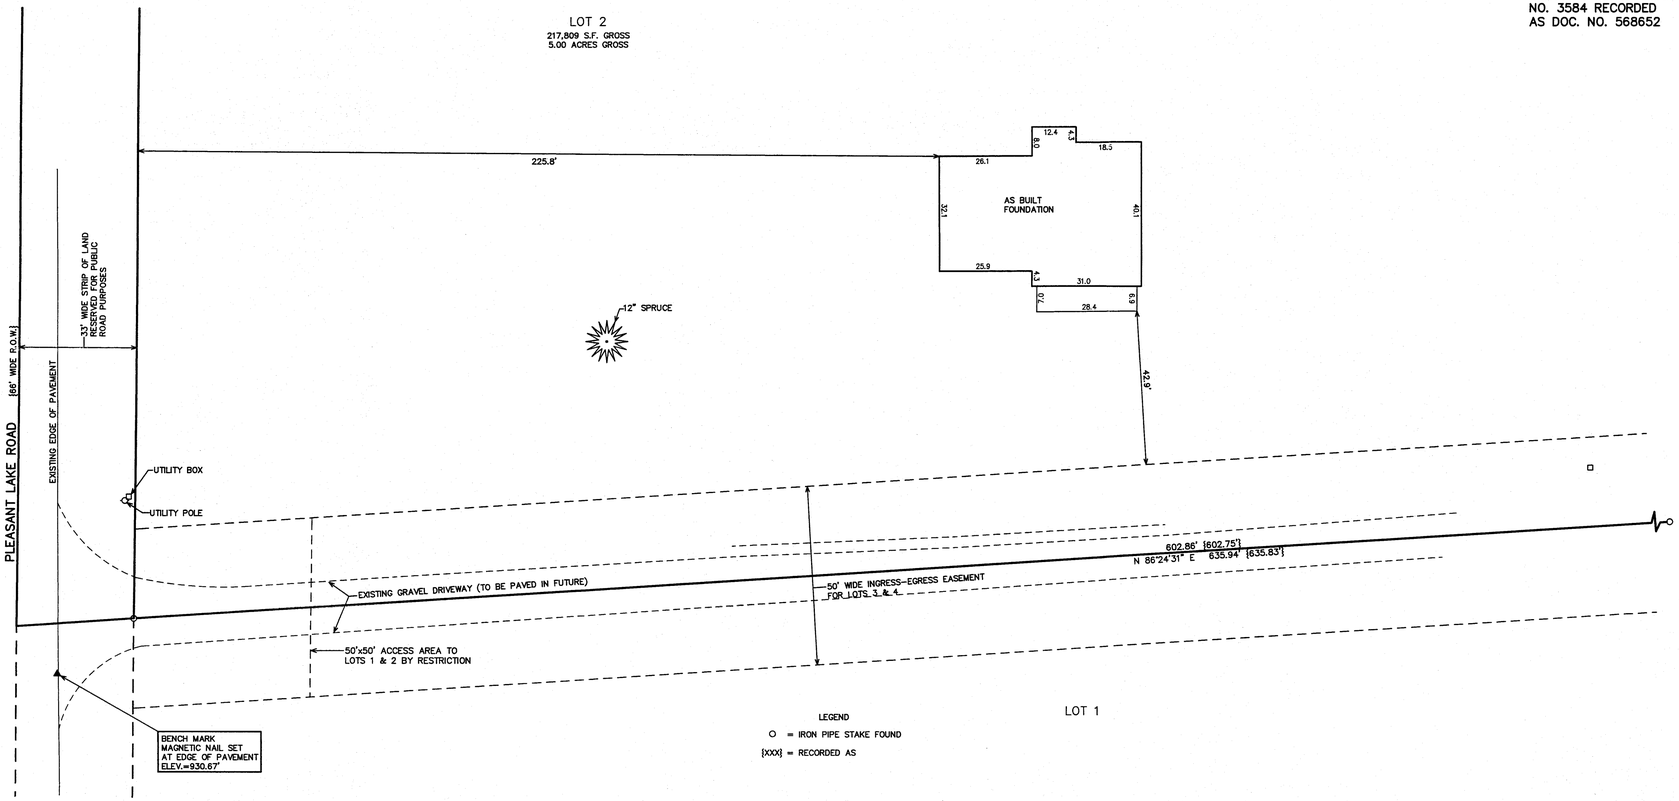


LEGEND

O = IRON PIPE STAKE FOUND

{XXX} = RECORDED AS

NOTE: COPIES OF THIS MAP TO WHICH THE FOLLOWING CERTIFICATE WILL APPLY SHOW THE SURVEYOR'S ORIGINAL SEAL AND SIGNATURE IN RED INK. COPIES BY ANY OTHER MEANS MAY HAVE ALTERATIONS WHICH DO NOT REPRESENT THE SURVEYOR'S WORK PRODUCT.

I HEREBY CERTIFY THAT THIS PLAT IS A TRUE AND ACCURATE REPRESENTATION OF THE LOCATION OF THE PROPOSED RESIDENCE IN RELATION TO THE NORTHWEST, AND SOUTHWEST CORNERS OF LOT 2 OF CERTIFIED SURVEY MAP NO. 3584 TO THE BEST OF MY PROFESSIONAL KNOWLEDGE AND BELIEF. NOTE: THIS IS NOT A SURVEY AS DEFINED IN CHAPTER A-E 7 OF WISCONSIN ADMINISTRATIVE CODE.

DATED: OCTOBER 10, 2013

PETER S. GORDON RLS 2101

REVISED 04-03-2014
TO SHOW SIZE & LOCATION OF
AS BUILT FOUNDATION

RECEIVED
MAY 1 2014
By

10 5 0 10 20 30 40 50 60 70 80 90 100
MAP SCALE IN FEET ORIGINAL 1" = 20'

APR 03 2014

4/3/2014 X:\Projects\8857\Dwgs\BASEMAP_20130730

COPY OF SHEET 2 OF CERTIFIED SURVEY MAP NO. 3584 RECORDED AS DOC. NO. 568652 →

**CERTIFIED SURVEY MAP NO. 3584**

Being a part of the Northwest ¼ and the Southwest ¼ of the Northwest ¼ of Section 19, Town 4 North, Range 17 East, in the Town of Troy, Walworth County, Wisconsin.

OWNERS
JEFFREY J./MICHELE M. AUBERGER
3851 S. 92ND. ST.
GREENFIELD WI. 53220

SURVEYOR
KETTLE MORAINE SURVEYING
P.O. BOX 357
EAGLE WI. 53119
(262)594-3484

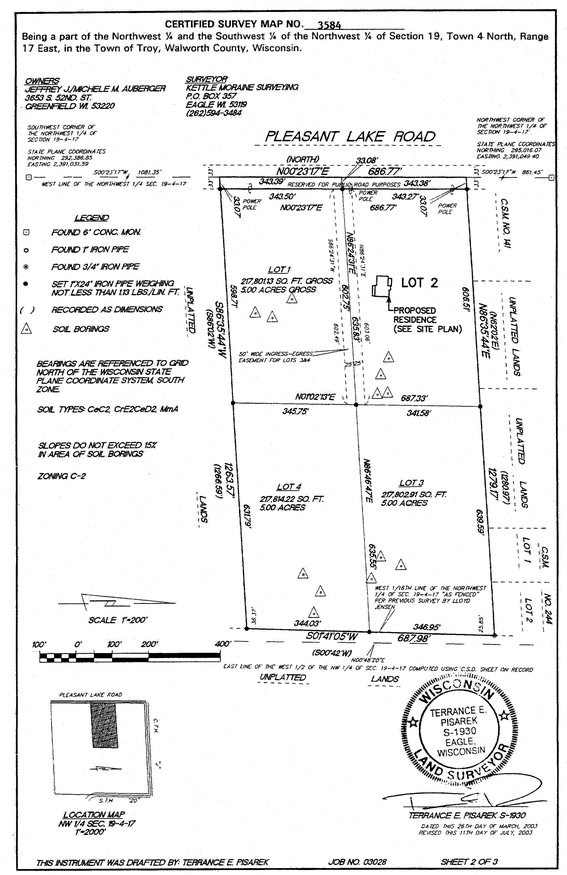


TERRANCE E. PISAREK S-1930
DATED THIS 28TH DAY OF MARCH, 2003
REVISED THIS 11TH DAY OF JULY, 2003

THIS INSTRUMENT WAS DRAFTED BY: TERRANCE E. PISAREK JOB NO. 03028 SHEET 2 OF 3

CS# 3584 Vol. 21 Pg. 130

– WORK ORDERED BY –
LIAM COEN
2615 S. STERLING CIRCLE
EAST TROY, WI 53120


FARRIS, HANSEN & ASSOCIATES, INC.
ENGINEERING – ARCHITECTURE – SURVEYING
7 RIDGWAY COURT P.O. BOX 437
ELKHORN, WISCONSIN 53121
OFFICE: (262) 723-2098 FAX: (262) 723-5886


| REVISIONS | PROJECT NO. | DATE | SHEET NO. |
|---|---|---|---|
| | 8857.13 | 7/30/2013 | 1 OF 1 |

LA3584-2 417-967