


Wisconsin Professional Land Surveyor S-2582

**N9330 Knuteson Drive
Whitewater, WI 53190
Phone:(262)495-3284
MARKMIRITZ@
LAND-MARKSURVEYING.COM**


LOT 20, BOOTH LAKE HEIGHTS SUBDIVISION, LOCATED IN PART OF SECTIONS 13 & 24, TOWN 4 NORTH, RANGE 17 EAST, TROY TOWNSHIP, WALWORTH COUNTY, WISCONSIN.

ORDERED BY: ELLYN DORSEY

**SURVEY ADDRESS: N8578 BOOTH LAKE HEIGHTS ROAD
EAST TROY, WI 53121**

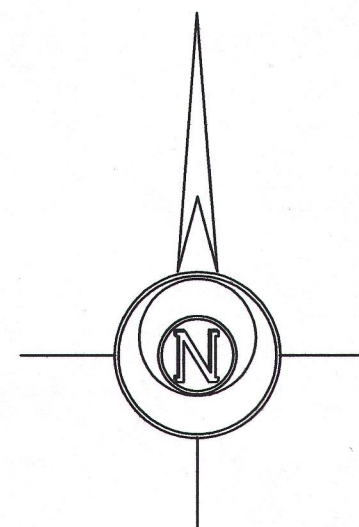

**WEST LINE OF LOT 20 WAS
ASSUMED N 9°45' W**

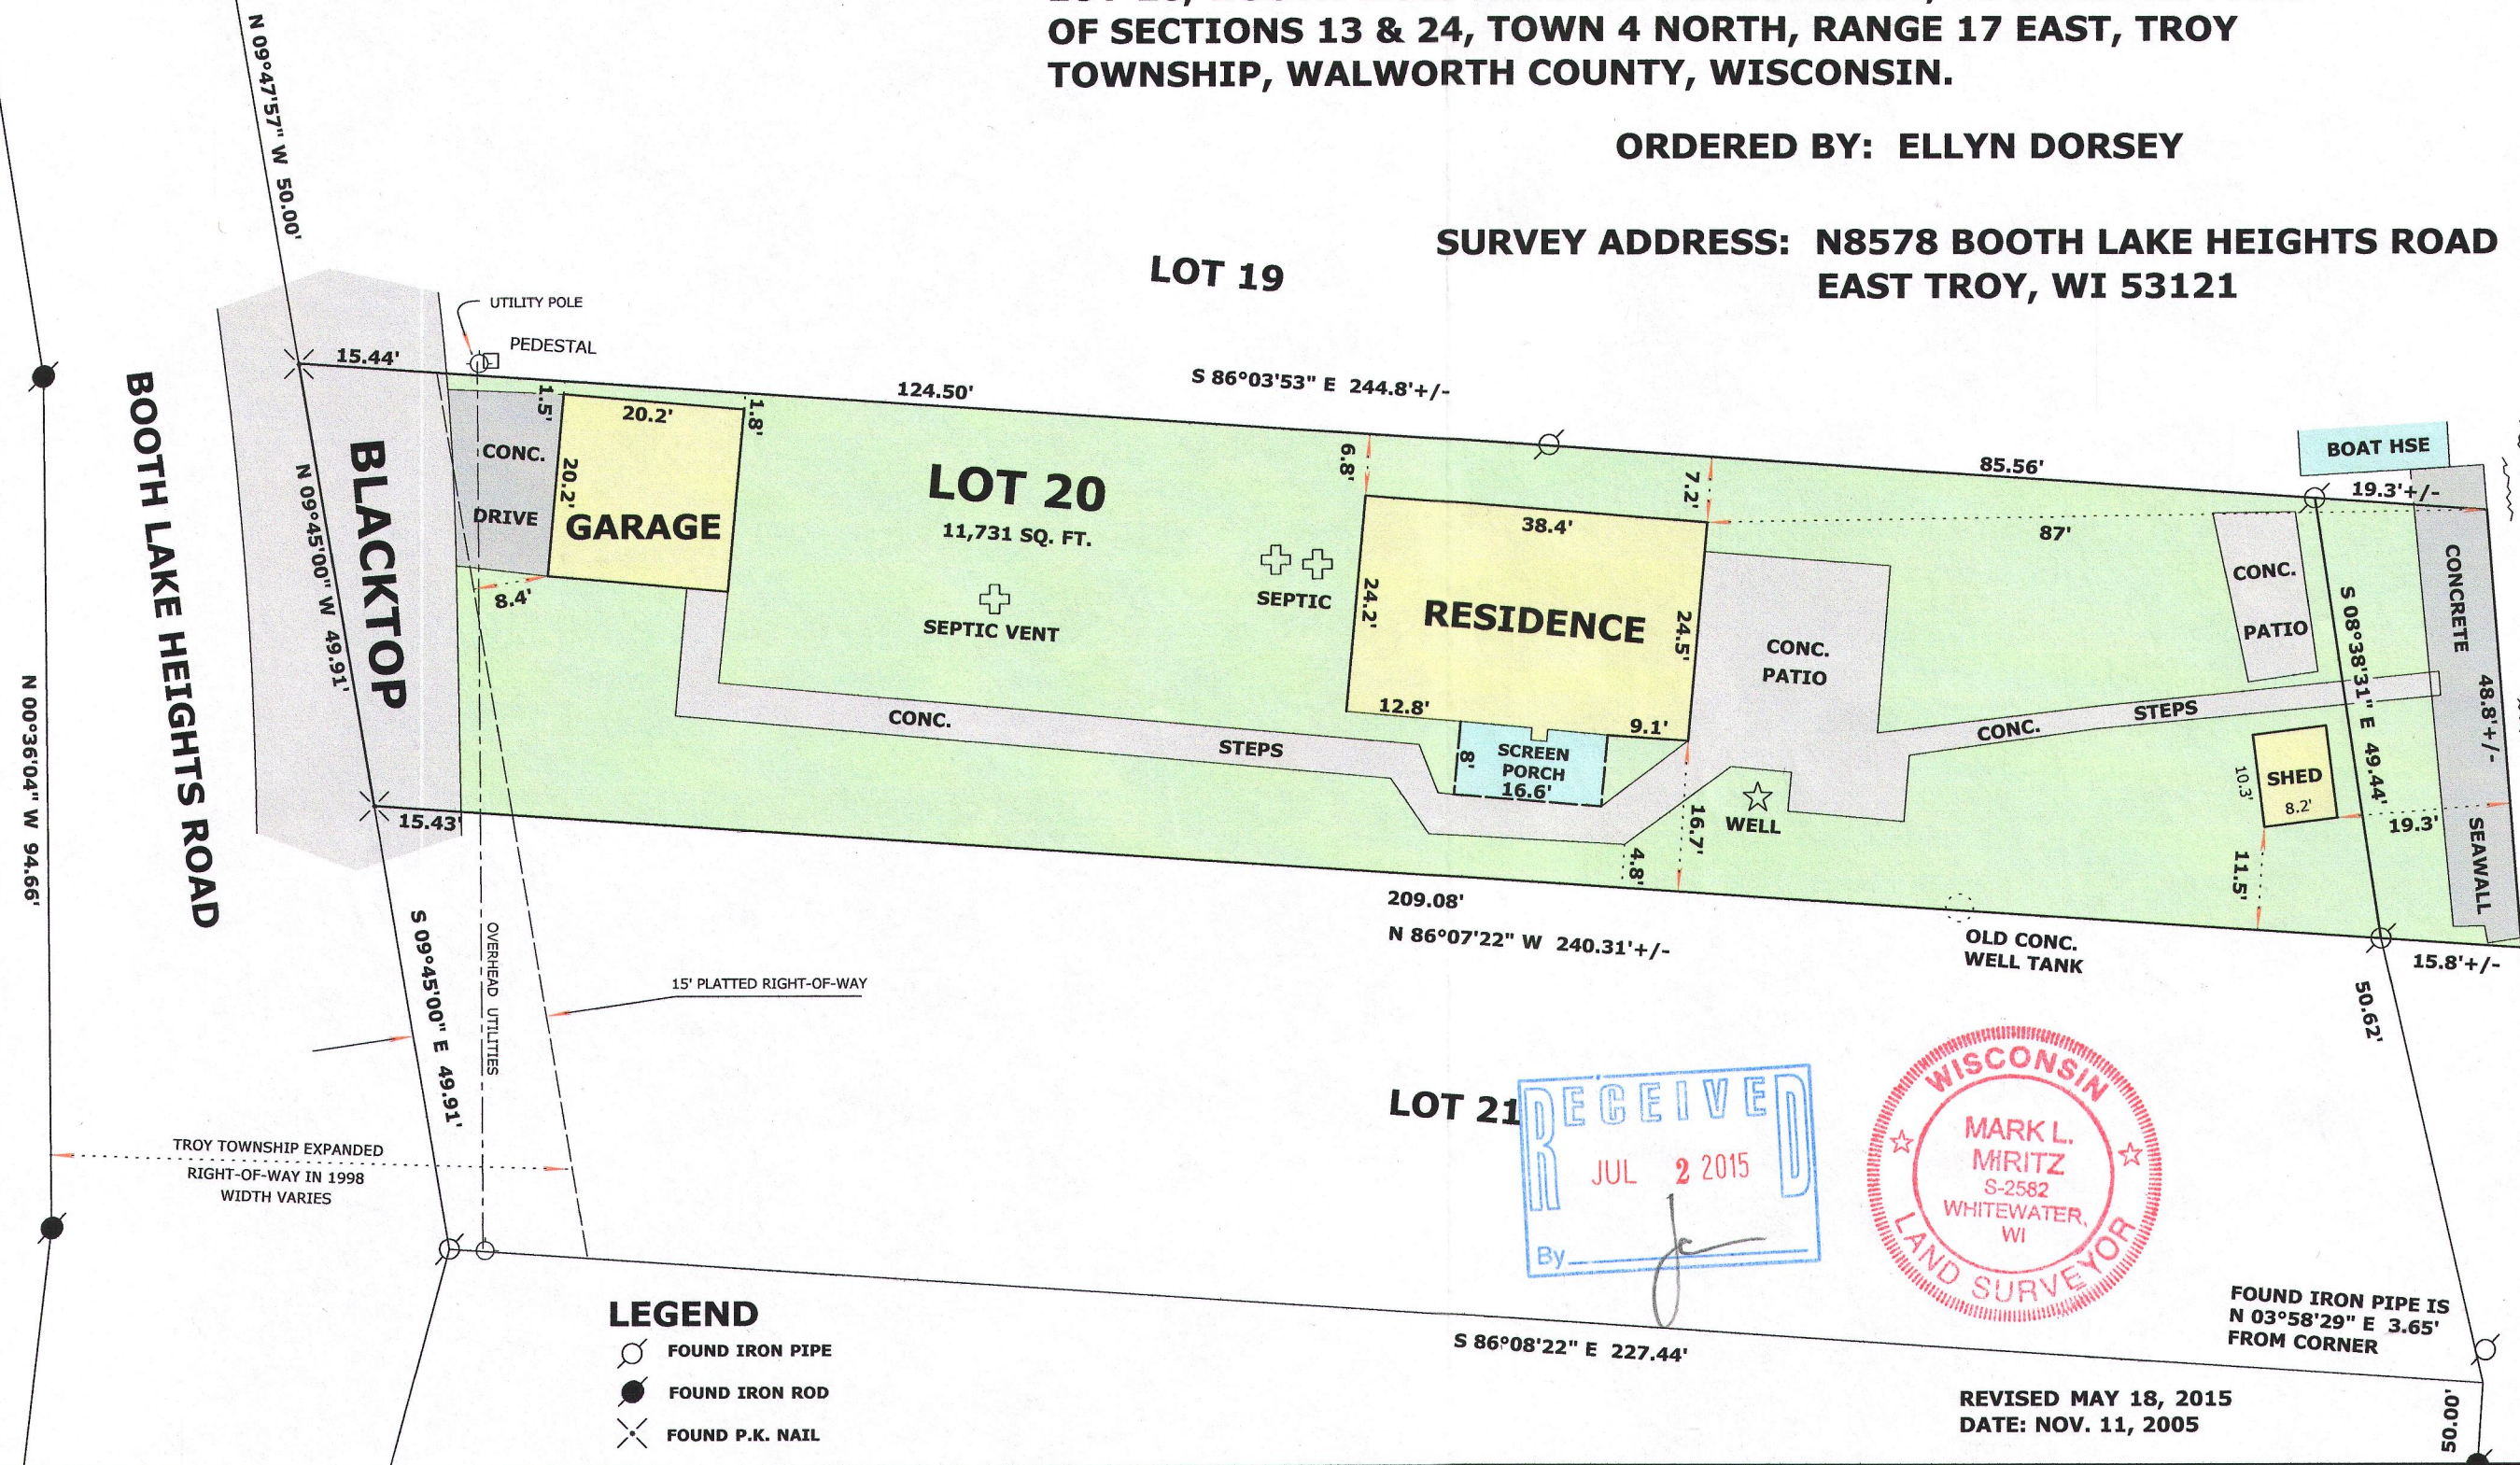

BOOTH LAKE

SCALE: 1" = 20 FEET

LOT 21

RECEIVED
JUL 2 2015
By [Signature]



FOUND IRON PIPE IS
N 03°58'29" E 3.65'
FROM CORNER

REVISED MAY 18, 2015
DATE: NOV. 11, 2005

Mark L. Miritz
MARK L. MIRITZ
WISCONSIN PROFESSIONAL
LAND SURVEYOR S-2582

JOB NO. 05.1106

LBL-18 417-99-