

# PLAT OF SURVEY

## RECORDED LEGAL DESCRIPTION:



(TAKEN FROM WARRANTY DEED, DOCUMENT NO. 0584539)

LOT 1 OF CERTIFIED SURVEY MAP NO. 1818 RECORDED IN THE OFFICE OF THE REGISTER OF DEEDS FOR WALWORTH COUNTY, WISCONSIN ON MAY 2, 1989 IN VOLUME 8 OF CERTIFIED SURVEY MAPS, PAGE 303, AS DOCUMENT NO. 177303, LOCATED IN THE NORTHWEST 1/4 OF THE NORTHWEST 1/4 AND THE SOUTHWEST 1/4 OF THE NORTHWEST 1/4 OF SECTION 4, IN TOWNSHIP 4 NORTH, RANGE 18 EAST, IN THE TOWN OF EAST TROY, WALWORTH COUNTY, WISCONSIN.

## LEGEND:

1" ●	IRON PIPE-FOUND (SIZED AS NOTED)
○	1" IRON ROD-FOUND
⊗	1.5" "MAG" MASONRY NAIL-SET
Ⓟ	POWER POLE
⊗	LIGHT POLE
Ⓜ	ELECTRIC PEDESTAL
Ⓣ	TELECOMMUNICATIONS PEDESTAL
Ⓢ	CABLE TV PEDESTAL
—E—	OVERHEAD UTILITY LINE
Ⓢ	SEPTIC TANK
Ⓢ	SEPTIC VENT

UNPLATTED LANDS

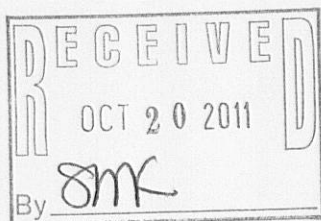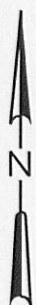

0' 50'

## BASIS OF BEARING:

THE EAST LINE OF  
LOT 1 WAS TAKEN  
TO BEAR S00° 27' 54" W.

## NOTE:

NO TITLE COMMITMENT OR RESULTS OF A TITLE SEARCH WERE FURNISHED TO RSV ENGINEERING, INC., PERTAINING TO THIS SURVEY. THIS PLAT OF SURVEY MAY NOT REFLECT EASEMENTS OF RECORD, ENCUMBRANCES, RESTRICTIONS, OWNERSHIP TITLE EVIDENCE, OR OTHER FACTS THAT AN ACCURATE AND CURRENT TITLE SEARCH MAY DISCLOSE.

LAST REVISED: 049/02/2009

SURVEY DATE: 03/26/2008


SURVEY MADE FOR:

STRAIGHT ARROW  
BUILDERS, LLC

**RSV**  
ENGINEERING, INC.  
W232 S7530 BIG BEND DRIVE  
BIG BEND, WI 53103  
(262) 662-4292

THIS SURVEY IS MADE FOR THE USE OF THE  
PRESENT OWNERS OF THE PROPERTY, AND  
ALSO THOSE WHO PURCHASE, MORTGAGE OR  
GUARANTEE TITLE TO WITHIN ONE (1) YEAR  
FROM DATE HERETO.

I, MICHAEL A. GREESON R.L.S. \*2770, HEREBY CERTIFY THAT  
THIS SURVEY WAS MADE IN ACCORDANCE WITH  
THE MINIMUM STANDARDS FOR PROPERTY SURVEYS  
(CHAPTER A-E 7) FOR THE STATE OF WISCONSIN AND  
HAS BEEN PREPARED UNDER MY DIRECTION AND  
CONTROL AND IS CORRECT TO THE BEST OF MY  
KNOWLEDGE AND BELIEF.

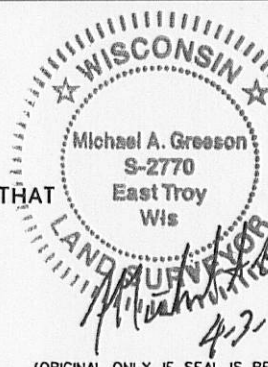

(ORIGINAL ONLY IF SEAL IS RED)

PLOT DATE: \$DATE\$

PA1818-1

RSV JOB#: 08-026

...\\CAD\\Survey\\08026 WETLANDS.dgn 4/3/2009 7:44:47 AM

418-2233