Plat of Survey

of

Lot 1 of Certified Survey Map No. 1287,

recorded in Vol. 6 of Certified Survey Maps of Walworth County on Page 74 as Document No. 92412 and located in the Northwest 1/4 of Section 25, Town 4 North, Range 18 East, Town of East Troy, Walworth County, Wisconsin.

Surveyed for: **Mario Reyes**
N8035 Bell School Road
East Troy, Wisconsin. 53120

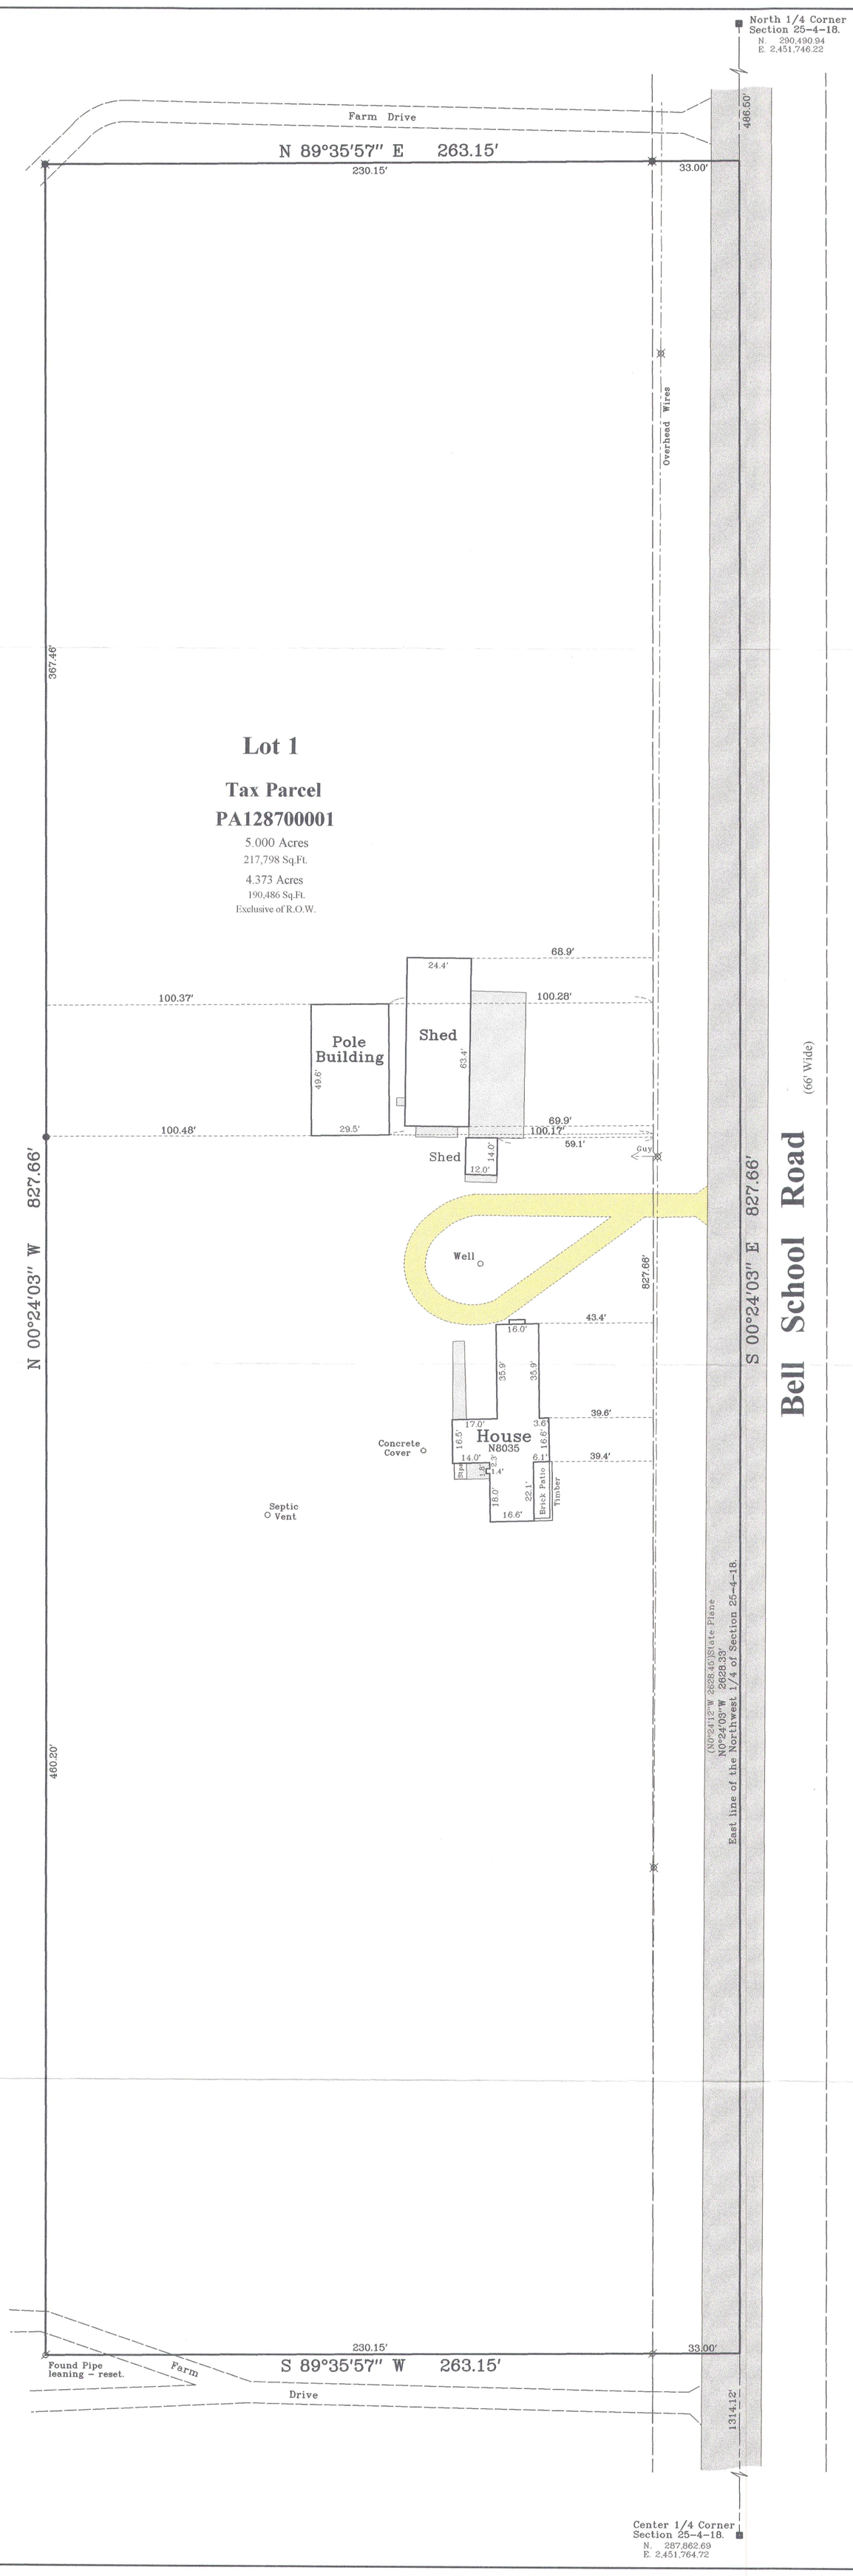

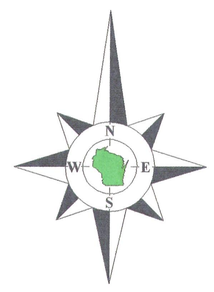

Bearings referenced to C.S.M. 1287.

WISCONSIN
DOUGLAS OLSON
S-2093
ELKHORN, WI
LAND SURVEYOR

Not Certified Unless Stamped in Red.

Notes:

1) This survey plat is not certified unless signed and sealed in red ink.
2) This survey is subject to Wisconsin lien laws. This Plat of Survey is the notice of intent to file lien. Lien waiver required.

Copyright 2011 by Jensen & Olson Land Surveying, LLC.

All rights reserved. No part of this survey plat may be reproduced or transmitted in any form by any means - graphic, electronic, or mechanical, including photocopying, tracing, or information storage and retrieval systems - without permission in writing from Douglas G. Olson, Jensen & Olson Land Surveying, LLC.

RECEIVED FEB 2 2012 By

I, Douglas G. Olson, Wisconsin Registered Land Surveyor, do hereby certify that this survey was performed by me, or under my direction in full compliance with the owner's/agent's instructions and Chapter A-E 7 of the Wisconsin Administrative Code "Minimum Standards for Property Surveys"; and that this map is an accurate representation thereof to the best of my knowledge and belief.

Douglas G. Olson
Wisconsin Registered Land Surveyor - 2093

2011.075

Sheet 1 of 1 Sheets

Drawing Name: t4nr18e-2011075-2011075Plat.scj

Job Reference Number
2011.075

Legend

- Found County Monument
- Found Iron Pipe
- Set Iron Rod, 3/4" dia.
- Found Iron Rod
- Recorded Information
- Utility Pole
- Concrete Surface
- Asphalt Surface
- Gravel Surface

Jensen & Olson Land Surveying, LLC
45 South Wisconsin Street * P.O. Box 322 * Elkhorn, Wisconsin. 53121
Telephone: (262) 723-3434 * Facsimile: (262) 723-8044
Email: jensen.olson@elknet.net

Scale in Feet
1" = 30'
0' 15' 30' 60' 90'

Survey date: February 6, 2001.
Revisions: No. 1 - House Addition
No. 2 - Barn Removed
New Shed

PA1287-1

418-2269