PLAT OF SURVEY

DATE: 1/24/02

LEGAL DESCRIPTION:
LOT 2 OF LAKE BEULAH WOODLANDS, BEING A REPLAT OF A PART OF LAKE BEULAH COUNTRY PARK SUBDIVISION, ALL LYING WITHIN THE NORTHEAST 1/4 AND THE NORTHWEST 1/4 OF THE NORTHEAST 1/4 OF SECTION 18, TOWN 4 NORTH, RANGE 18 EAST, TOWN OF EAST TROY, WALWORTH COUNTY, WISCONSIN.

SURVEYOR'S CERTIFICATE:
THE ABOVE MAP IS A TRUE REPRESENTATION THEREOF AND SHOWS THE SIZE AND LOCATION OF ALL THE PROPERTY, EXTERIOR BOUNDARIES, THE LOCATION OF ALL VISIBLE BOUNDARY FENCES, APPARENT EASEMENTS, ROADWAYS AND VISIBLE ENCROACHMENTS, IF ANY.

THIS SURVEY IS MADE FOR THE USE OF THE PRESENT OWNERS OF THE PROPERTY, AND ALSO THOSE WHO PURCHASE, MORTGAGE OR GUARANTEE TITLE THERETO WITHIN ONE (1) YEAR FROM DATE HERETO.

1/24/02

BRADFORD L. SPENCER, R.L.S. 2069

WISCONSIN BRADFORD L. SPENCER S-2069 MUKWONAGO, WIS.

THIS IS ORIGINAL PRINT ONLY IF SEAL IS IN PRINTED (RED)

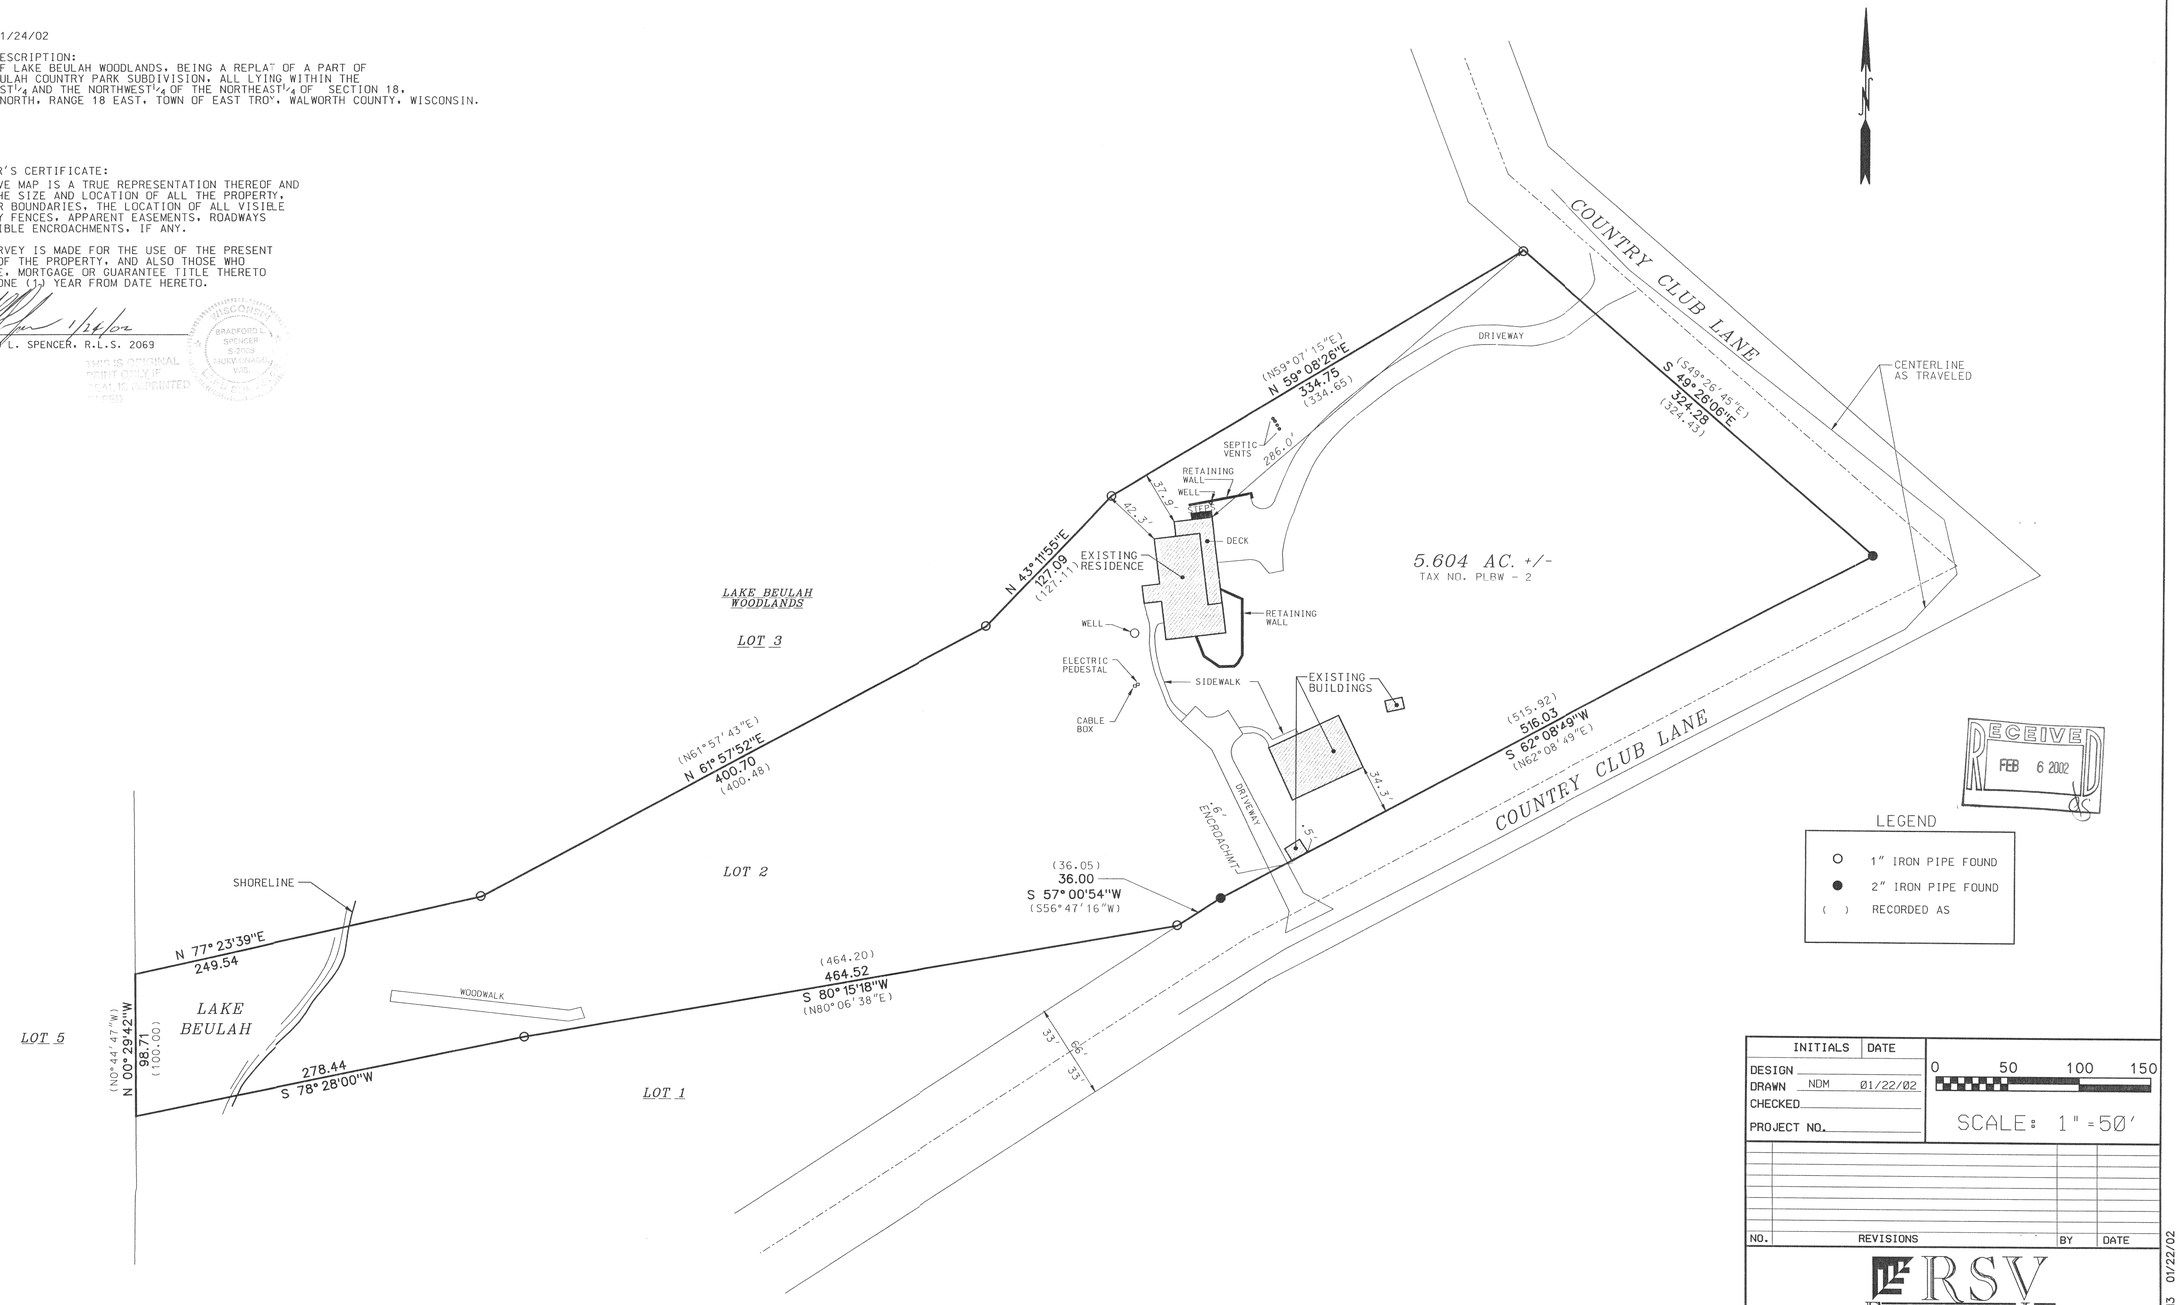

RECEIVED FEB 6 2002

LEGEND

- ○ 1" IRON PIPE FOUND
- ● 2" IRON PIPE FOUND
- ( ) RECORDED AS

INITIALS	DATE
DESIGN	
DRAWN NDM	01/22/02
CHECKED	
PROJECT NO.	

0 50 100 150

SCALE: 1" = 50'

NO.	REVISIONS	BY	DATE

RSV ENGINEERING, INC.
Engineers • Land Surveyors • Environmental Scientists
801 MAIN STREET MUKWONAGO, WISCONSIN 53149 (262)363-2004

RSV•02013 01/22/02

PLBW-2
4/18-1527