


PLAT OF SURVEY

LOT 2 OF CERTIFIED SURVEY MAP NO. 27, LOCATED IN THE EAST 1/2 OF SECTION 9, TOWN 4 NORTH, RANGE 18 EAST, IN THE TOWN OF EAST TROY, WALWORTH COUNTY, WISCONSIN.

SURVEYED FOR: URBAN HERRIGES & SONS INC.

BEULAH

LAKE

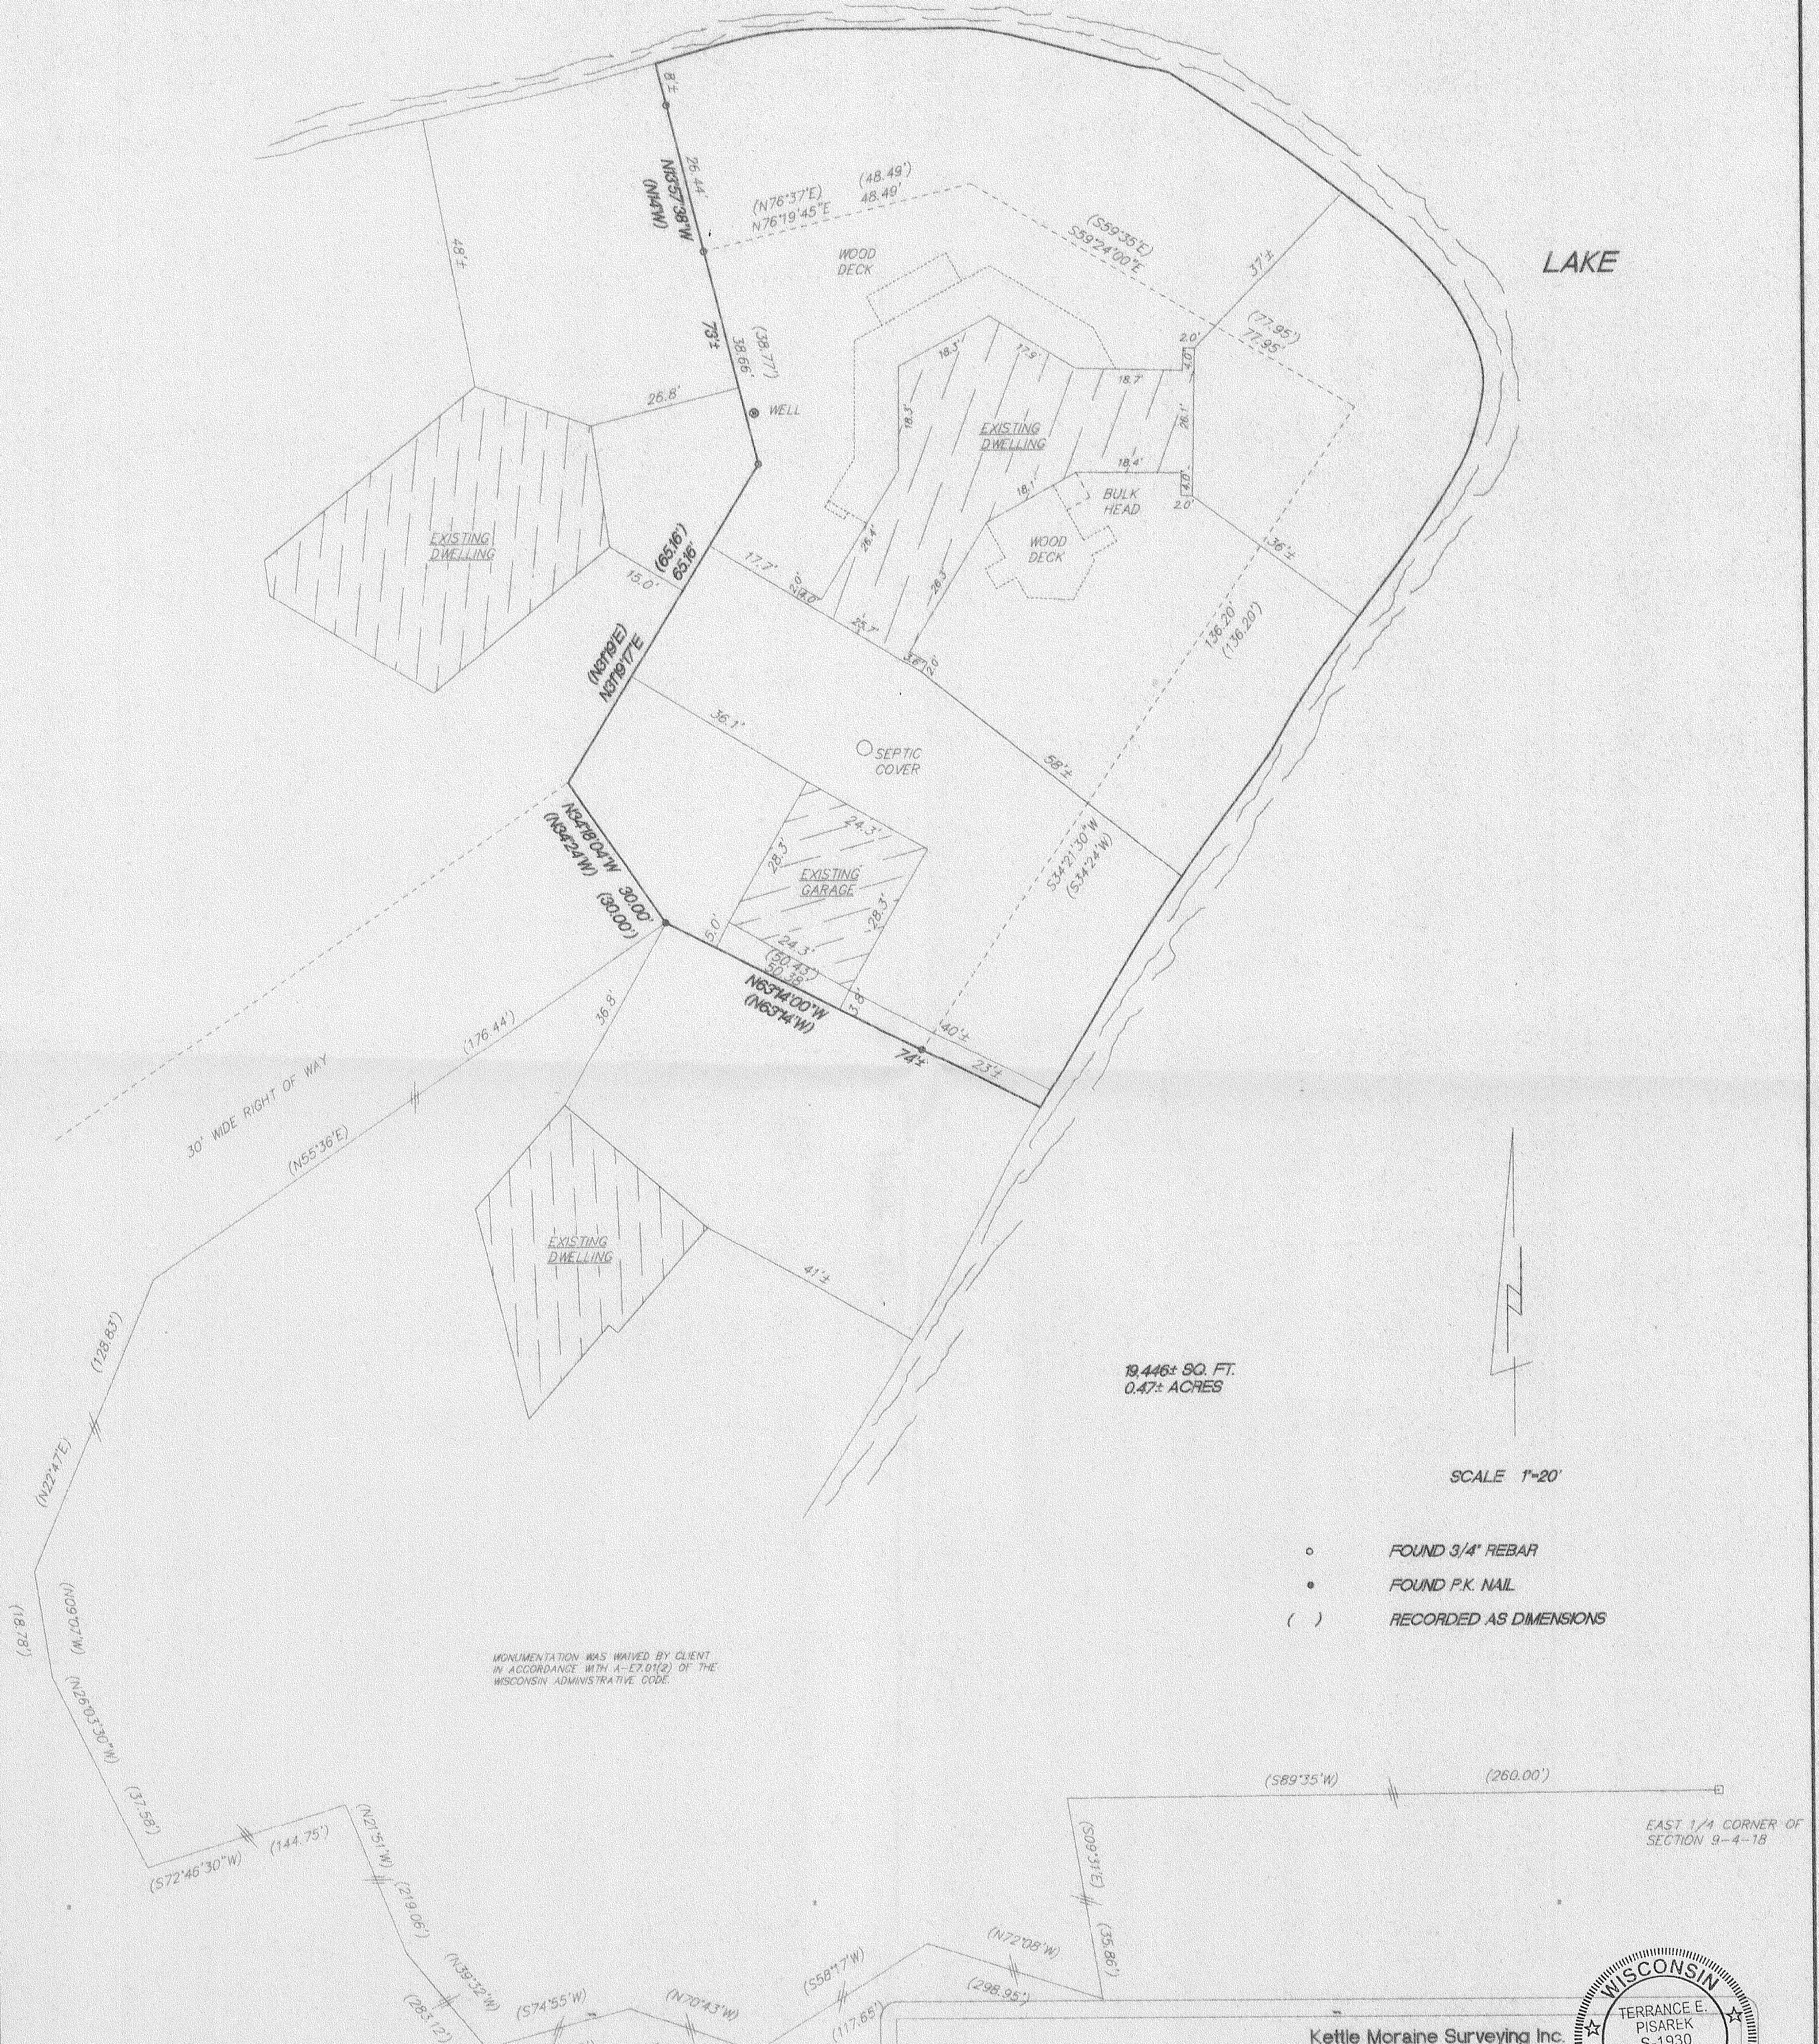


19,446± SQ. FT.
0.47± ACRES

SCALE 1"=20'

- FOUND 3/4" REBAR
- FOUND P.K. NAIL
- () RECORDED AS DIMENSIONS


Kettle Moraine Surveying Inc.
P.O. Box 357
Eagle WI. 53119
(262)594-3484

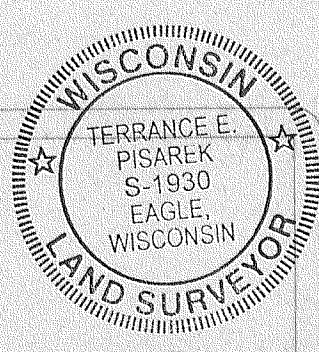

"I hereby certify that I have surveyed the above property and that the above map is a true representation thereof and shows the size and location of the property exterior boundaries, the location of all 'in situ' structures and dimensions of all principal buildings thereon, boundary fences, apparent easements, roadways and encroachments if any.
This survey is made for the use of the present owners of the property, and also those who purchase, mortgage or guarantee the title thereto within one year from date hereof."

THIS IS NOT AN ORIGINAL SURVEY UNLESS THE SEAL IS RED.

7/16/07 DATE TEP FIELD WORK BY TEP DRAWN BY 07098 JOB NUMBER

