Plat of Survey

of

Lot 2 of Certified Survey Map No. 2295,

recorded in Vol. 11 of Certified Survey Maps of Walworth County on Page 139 and located in the Northeast 1/4 of Section 19, Town 4 North, Range 18 East, Town of East Troy, Walworth County, Wisconsin.

Surveyed for: **Carl Jaskiewicz**
W2143 St. Peters Road
East Troy, Wisconsin. 53120

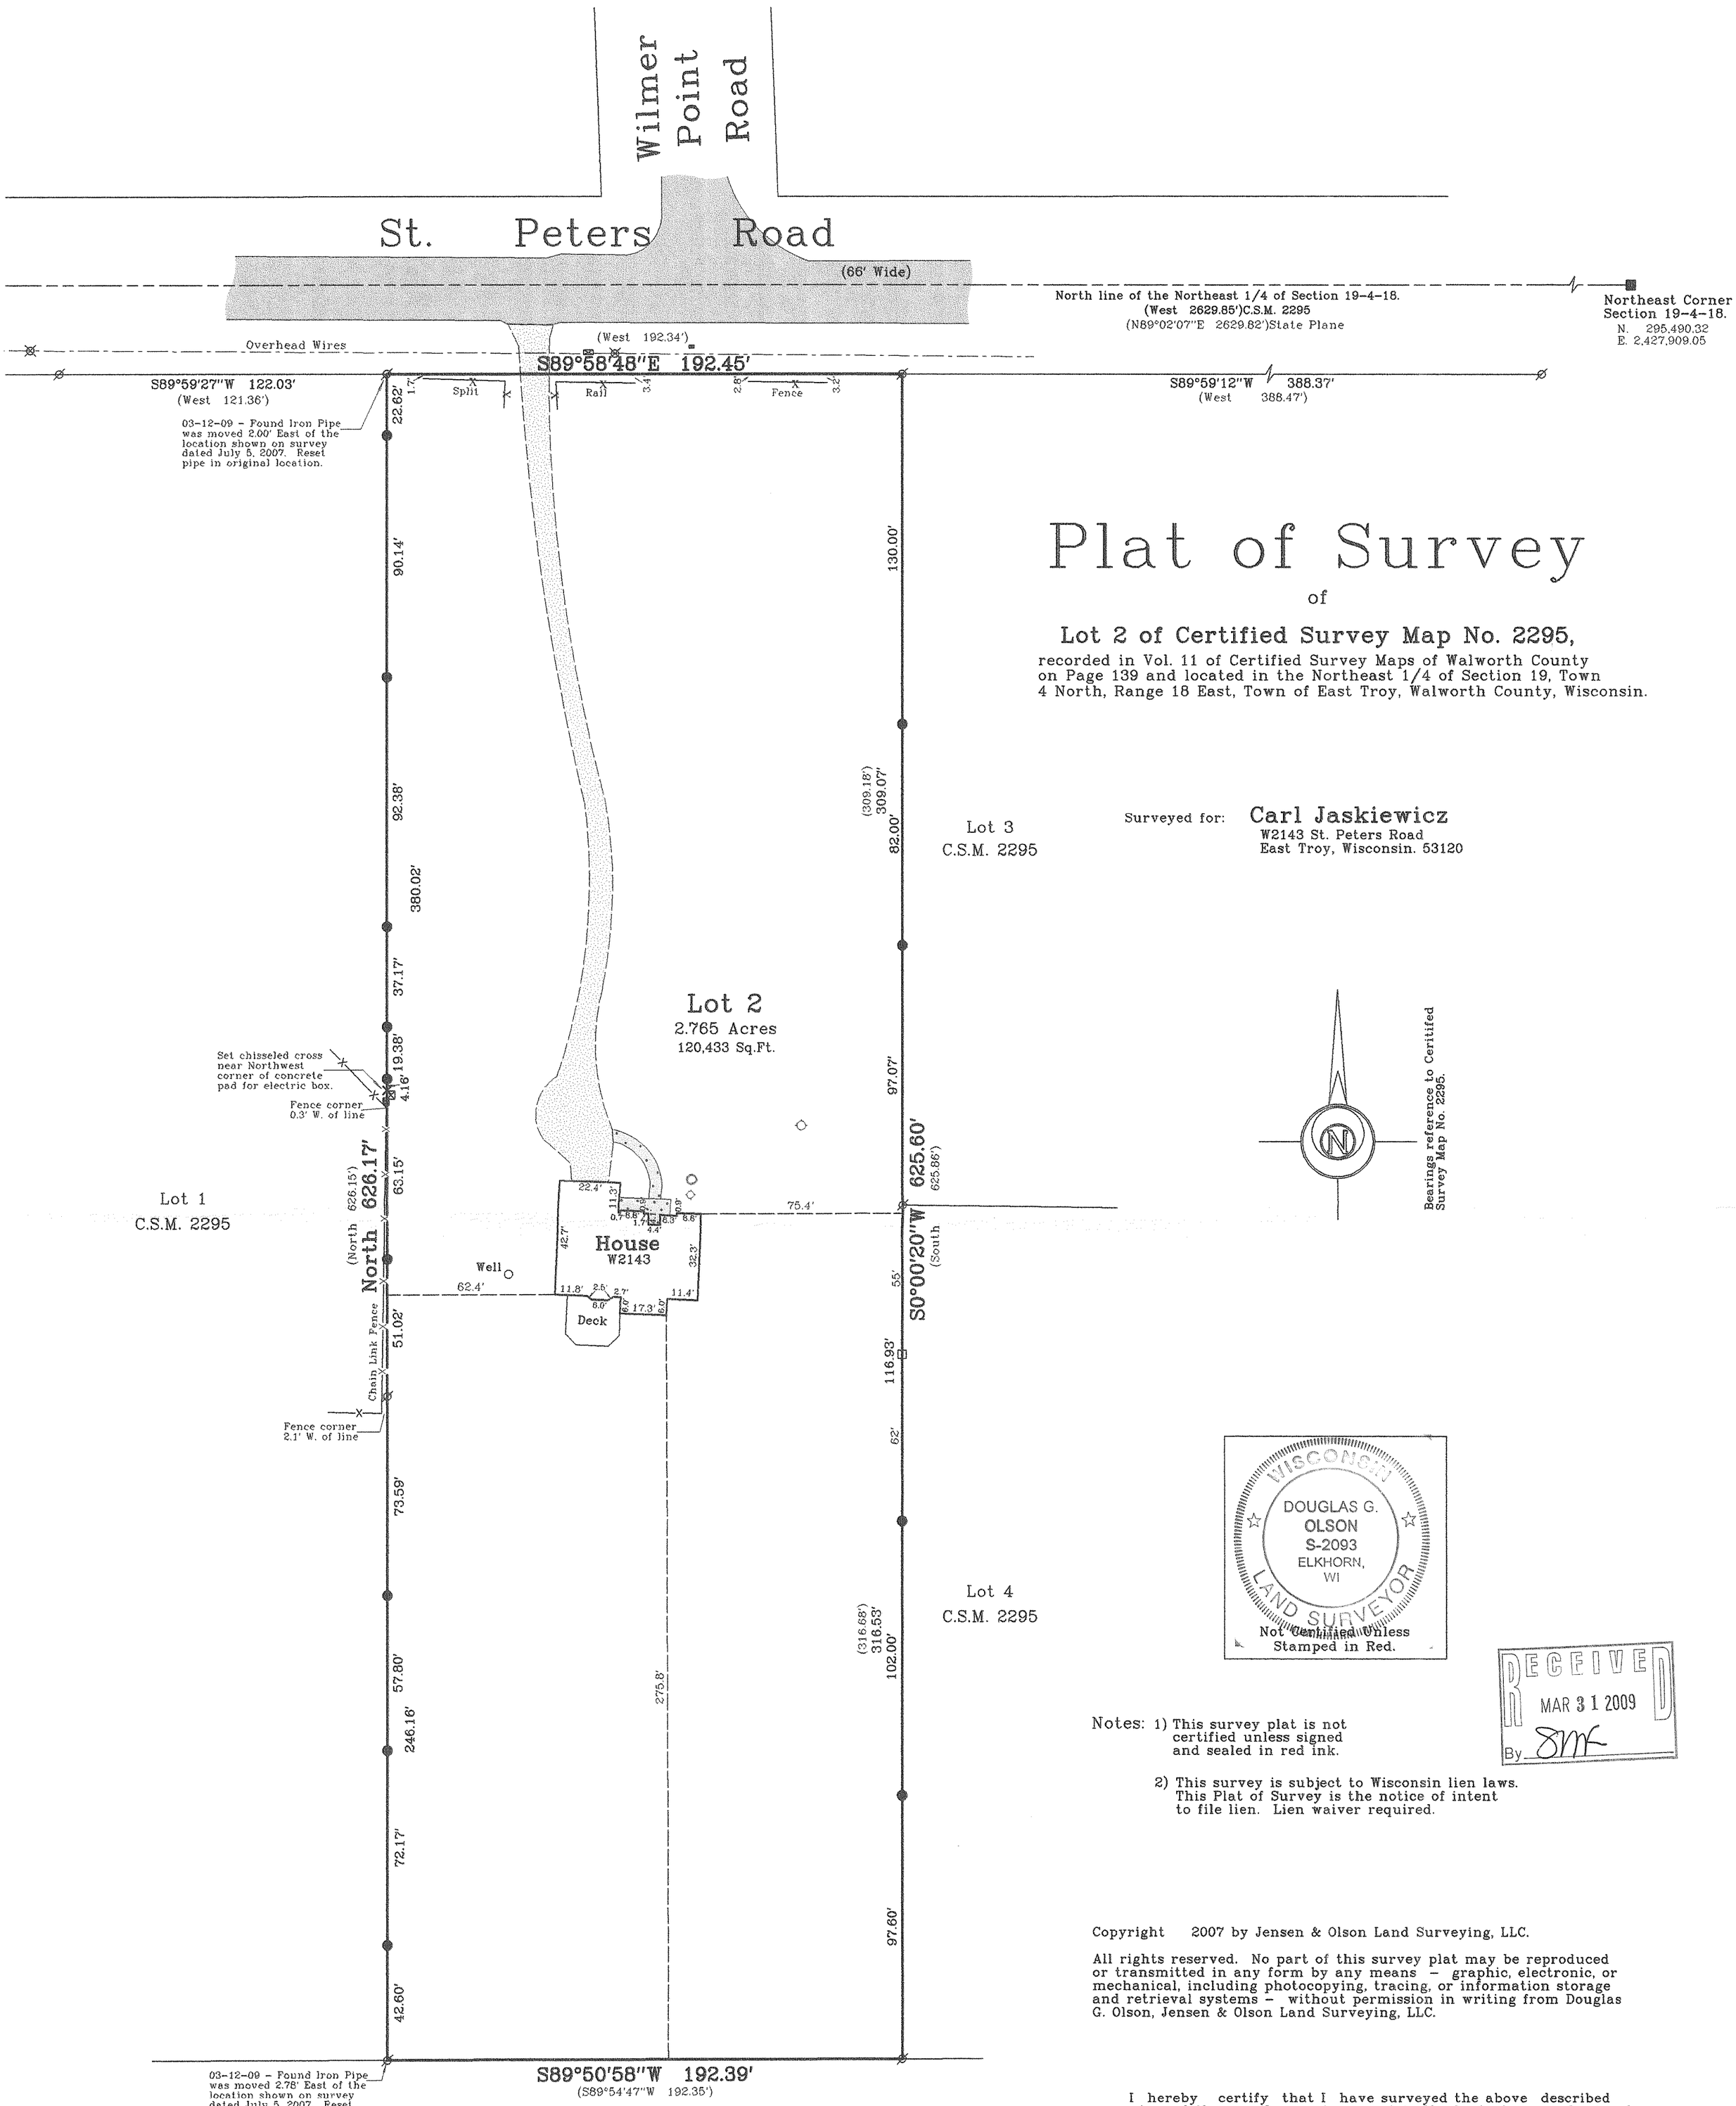

WISCONSIN
DOUGLAS G. OLSON
S-2093
ELKHORN, WI
LAND SURVEYOR
Not Certified Unless Stamped in Red.

RECEIVED
MAR 31 2009
By SMF

Notes: 1) This survey plat is not certified unless signed and sealed in red ink.

2) This survey is subject to Wisconsin lien laws. This Plat of Survey is the notice of intent to file lien. Lien waiver required.

Copyright 2007 by Jensen & Olson Land Surveying, LLC.

All rights reserved. No part of this survey plat may be reproduced or transmitted in any form by any means – graphic, electronic, or mechanical, including photocopying, tracing, or information storage and retrieval systems – without permission in writing from Douglas G. Olson, Jensen & Olson Land Surveying, LLC.

I hereby certify that I have surveyed the above described property and the map hereon is correct to the best of my professional knowledge and belief and shows the size and location of the property, its exterior boundaries, the location and dimensions of all visible structures thereon, boundary fences, apparent easements and roadways and visible encroachments, if any.

This survey is made for the exclusive use of the present owners of property, and also those who purchase, mortgage or guarantee title thereto, within one year from the date hereof.

Douglas G. Olson
Wisconsin Registered Land Surveyor – 2093

2009.010

Sheet 1 of 1 Sheets

Job Reference Number
2009.010

Legend
- Set Iron Rod, 3/4" dia.
- Set Wood Lath
- Found County Section Corner
- Found Iron Pipe
- ( ) Recorded Information
- Utility Pole
- Pedestal
- Concrete Cover
- Septic Vent
- Concrete Surface
- Asphalt Surface
- Gravel

Jensen & Olson Land Surveying, LLC
45 South Wisconsin Street P.O. Box 322
Elkhorn, Wisconsin. 53121
Telephone (262) 723-3434
Facsimile (262) 723-8044

Scale in Feet
1" = 40'
0' 20' 40' 80'

Survey Date: July 5, 2007.
Revisions: No. 1 – Points set on side lot lines.
No. 2 – Points set on side lot lines.

PA2295-2

418-2147