

PREPARED FOR:  
MARK MARZION  
MARZION HOME & REALTY  
S92 W34720 JOSHUA WAY  
EAGLE, WI 53119


KROTT SURVEYING INC.  
N3705 WILLOW BEND LANE  
LAKE GENEVA WI 53147  
PHONE # (262)248-3697  
FAX # (262)249-0639

PLAT OF SURVEY

-OF-

A PARCEL OF LAND LOCATED IN SECTION 9, T.4 N., R.18 E., WALWORTH COUNTY, WISCONSIN; COMMENCING AT THE WEST 1/4 CORNER OF SECTION 9; THENCE S61°00' E 66.00 FEET; THENCE N 36°51' E 411.92 FEET; THENCE S 87°15' E 179.53 FEET; THENCE S 69°23' E 341.96 FEET; THENCE S 7°46' W 258.65 FEET; THENCE S 19°18' W 45.91 FEET; THENCE S 34°36' E 84.00 FEET; THENCE S 48°21' E 100.31 FEET; THENCE S 82°07' E 128.13 FEET; THENCE N 15°52' W 333.36 FEET; THENCE N 12°08' E 178.86 FEET; THENCE N 43°06'39" E 115.07 FEET TO THE PLACE OF BEGINNING; THENCE CONTINUE N 43°06'39" E 49.91 FEET; THENCE N 09°46'43" W 48.06 FEET; THENCE N 14°05'42" E 105.86 FEET; THENCE N 41°48'27" W 95.36 FEET; THENCE N 03°58'32" E 25.40 FEET; THENCE N 42°50' W 206.97 FEET TO A POINT ON MEANDER LINE, SAID POINT IS LOCATED S 42°50' E 16.4 FEET MORE OR LESS FROM THE SHORE OF LAKE BEULAH; THENCE S 18°24'00" W ALONG SAID MEANDER LINE, 157.47 FEET TO A POINT 39 FEET MORE OR LESS SOUTHERLY FROM THE SHORE OF LAKE BEULAH; THENCE S 88°50'25" W ALONG SAID MEANDER LINE, 160.89 FEET TO A POINT 30 FEET SOUTHERLY FROM THE SHORE OF LAKE BEULAH; THENCE N 24°37'17" W ALONG SAID MEANDER LINE 170.12 FEET TO A POINT S 19°20'28" W 2.1 FEET MORE OR LESS FROM THE SHORE OF LAKE BEULAH; THENCE S 19°20'28" W 102.57 FEET; THENCE S 00°49'50" E 200.00 FEET; THENCE S 75°07'51" E 204.83 FEET; THENCE S 01°09'29" E 65.88 FEET; THENCE N 85°43'32" E 192.62 FEET; THENCE S 63°31'19" E 80.34 FEET TO THE POINT OF BEGINNING.


ALSO, ALL THE LAND BETWEEN THE SAID MEANDER LINE AND THE SHORE OF LAKE BEULAH.

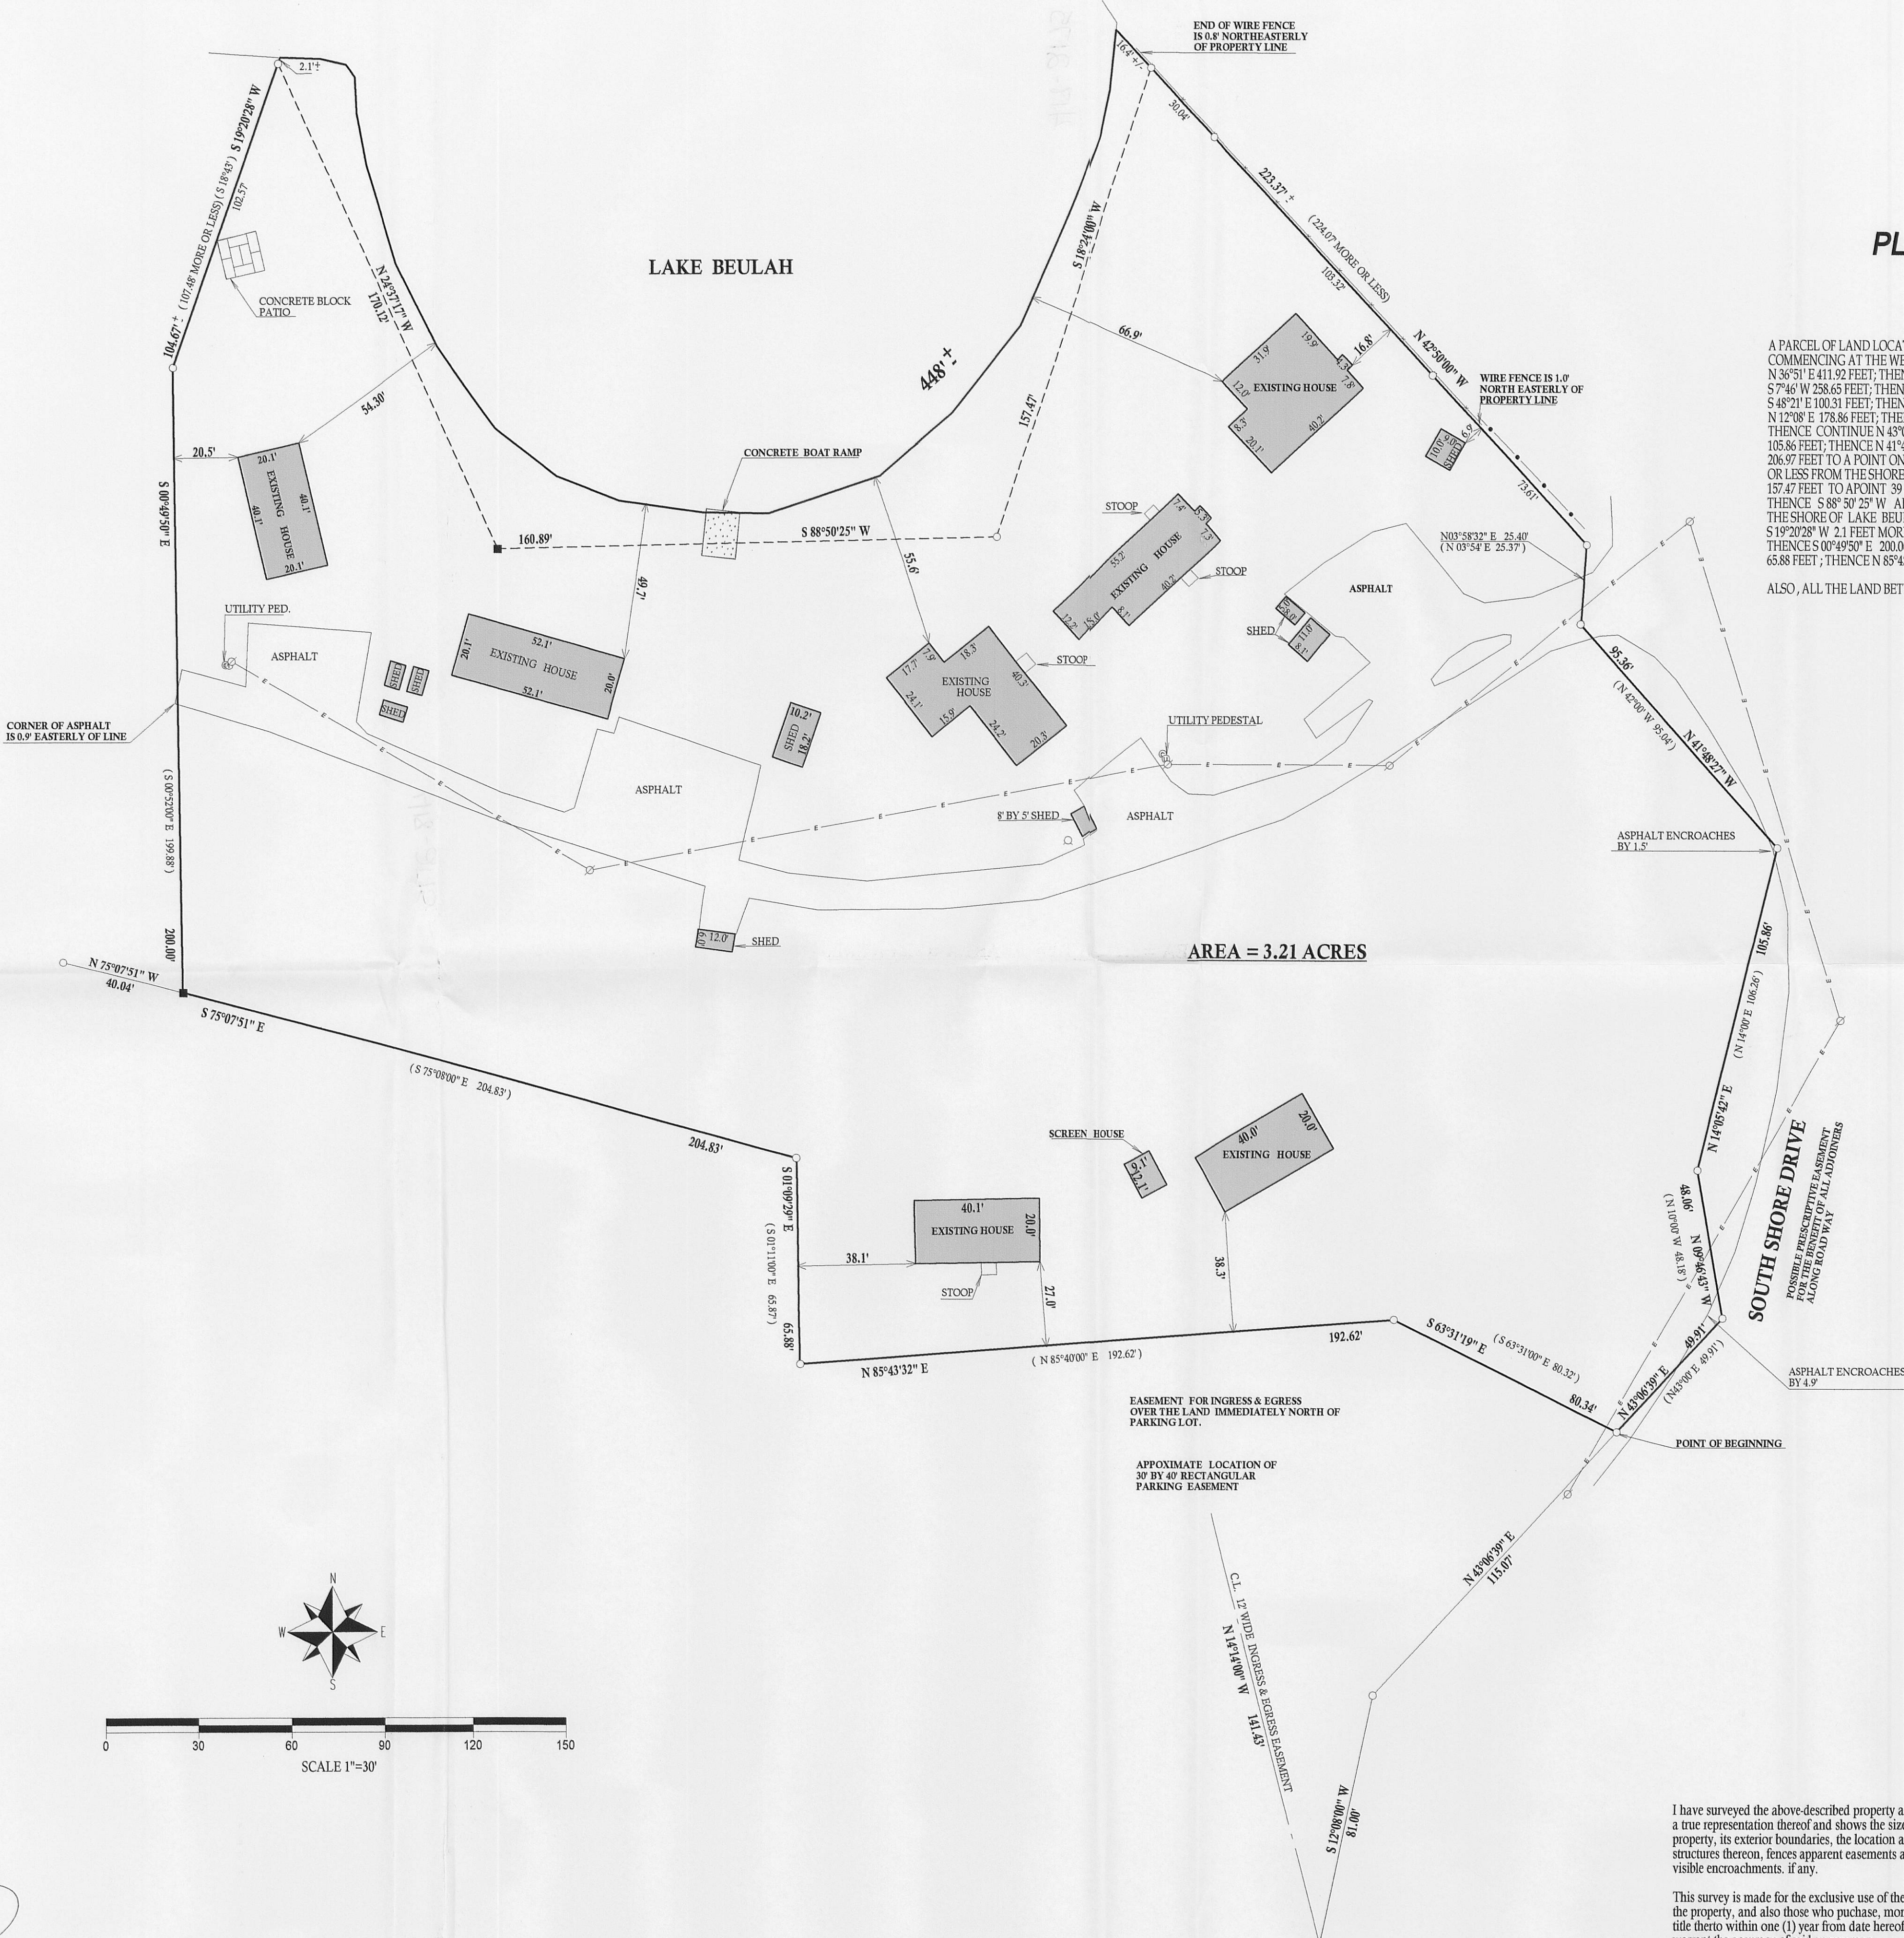

LEGEND

- POST AND RAIL FENCE
- WIRE FENCE
- UTILITY POLE
- OVER HEAD UTILITIES
- FOUND IRON PIPE
- FOUND IRON BAR
- SET IRON BAR
- RECORDED AS

JOB # 10-025 TAX ID # PET900036

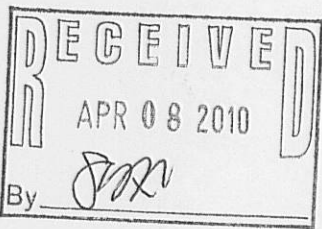

I have surveyed the above-described property and the above map is a true representation thereof and shows the size and location of the property, its exterior boundaries, the location and dimensions of all structures thereon, fences apparent easements and roadways and visible encroachments, if any.

This survey is made for the exclusive use of the present owners of the property, and also those who purchase, mortgage, or insure the title thereto within one (1) year from date hereof; and as to them I warrant the accuracy of said survey map.

DATED THIS 15th, DAY OF MARCH, 2010

JOHN KROTT S - 2258  
Wisconsin Registered Land Surveyor  
(original if signed in red)

418-2175