Plat of Survey

LOT 2, CERTIFIED SURVEY MAP NO. 2261, being a part of the Northwest ¼ of the Northwest ¼ of Section 3, Town 4 North, Range 18 East, Town of East Troy, Walworth County, Wisconsin.

Surveyed for: Rob Day

Survey address: N9628 C.T.H. I

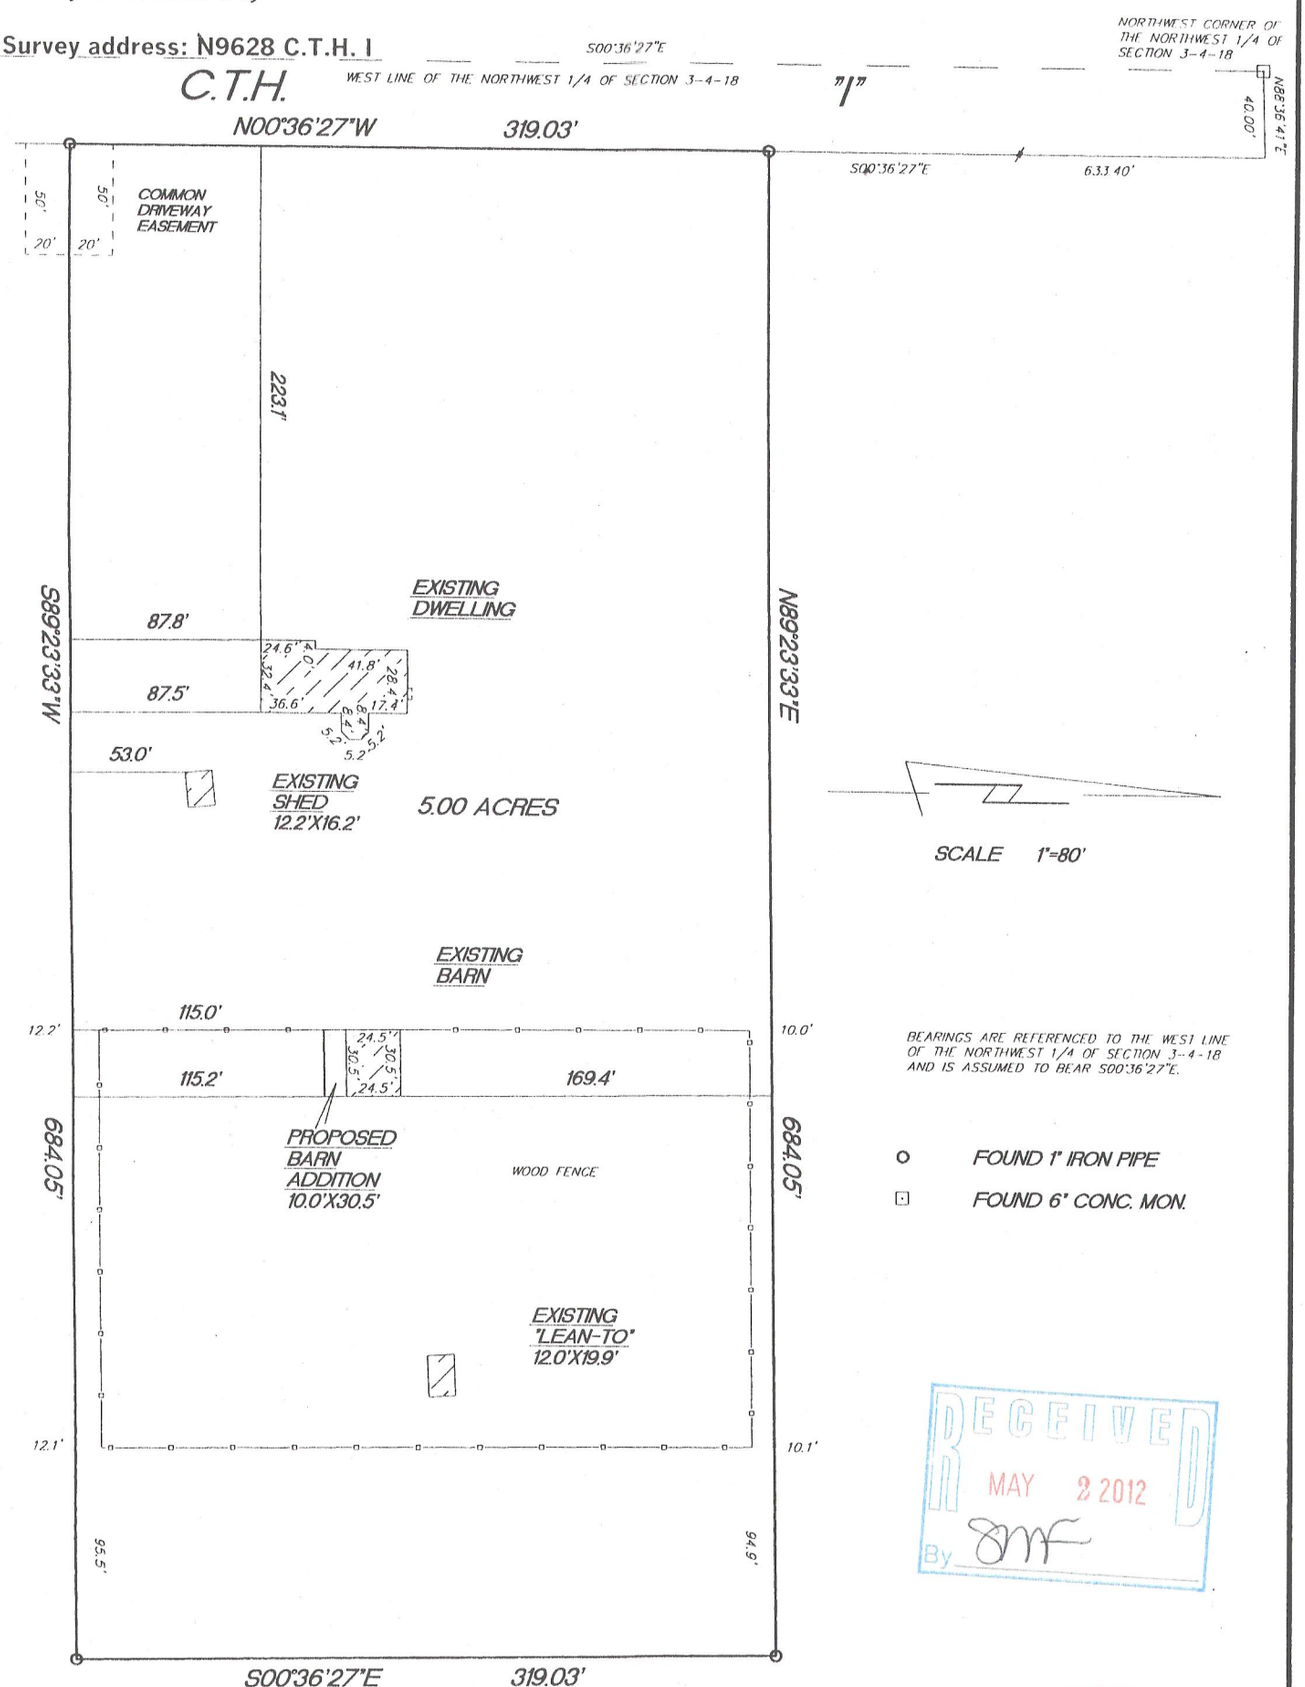

BEARINGS ARE REFERENCED TO THE WEST LINE OF THE NORTHWEST 1/4 OF SECTION 3-4-18 AND IS ASSUMED TO BEAR S00°36'27"E.

○ FOUND 1" IRON PIPE

⊡ FOUND 6" CONC. MON.

RECEIVED
MAY 2 2012
By

"I hereby certify that I have surveyed the above described property and that the above map is a true representation thereof and shows the size and location of the property, its exterior boundaries, the location of all visible structures and dimension of all principal buildings thereon, boundary fences, apparent easements, roadways and encroachments if any."

"This survey is made for the use of the present owners of the property, and also those who purchase, mortgage or guarantee the title thereto within one year from date hereof."

KETTLE MORAINE SURVEYING INC.
S75 W36245 Wilton Road
Eagle Wisconsin 53119
P.O. Box 357
(262) 594-3484
Terrance E. Pisarek R.L.S.

WISCONSIN TERRANCE E. PISAREK S-1930 EAGLE, WISCONSIN LAND SURVEYOR

THIS IS NOT AN original SURVEY UNLESS THE SEAL IS RED.

2/28/12	TEP	TEP	12012
DATE	FIELD WORK BY	DRAWN BY	JOB NUMBER

PLA2261-2

418-2274