LAND-MARK SURVEYING
Mark L. Miritz
Wisconsin Registered Land Surveyor S-2582

N9330 Knuteson Drive
Whitewater, WI 53190
Phone:(262)495-3284
FAX : (262) 495-8421
LAND-MARKSURVEYING.COM

PLAT OF SURVEY

LOT 1 OF CERTIFIED SURVEY MAP NO. 30, LOCATED IN THE EAST 1/2 OF SECTION 9, TOWN 4 NORTH, RANGE 18 EAST, EAST TROY TOWNSHIP, WALWORTH COUNTY, WISCONSIN.

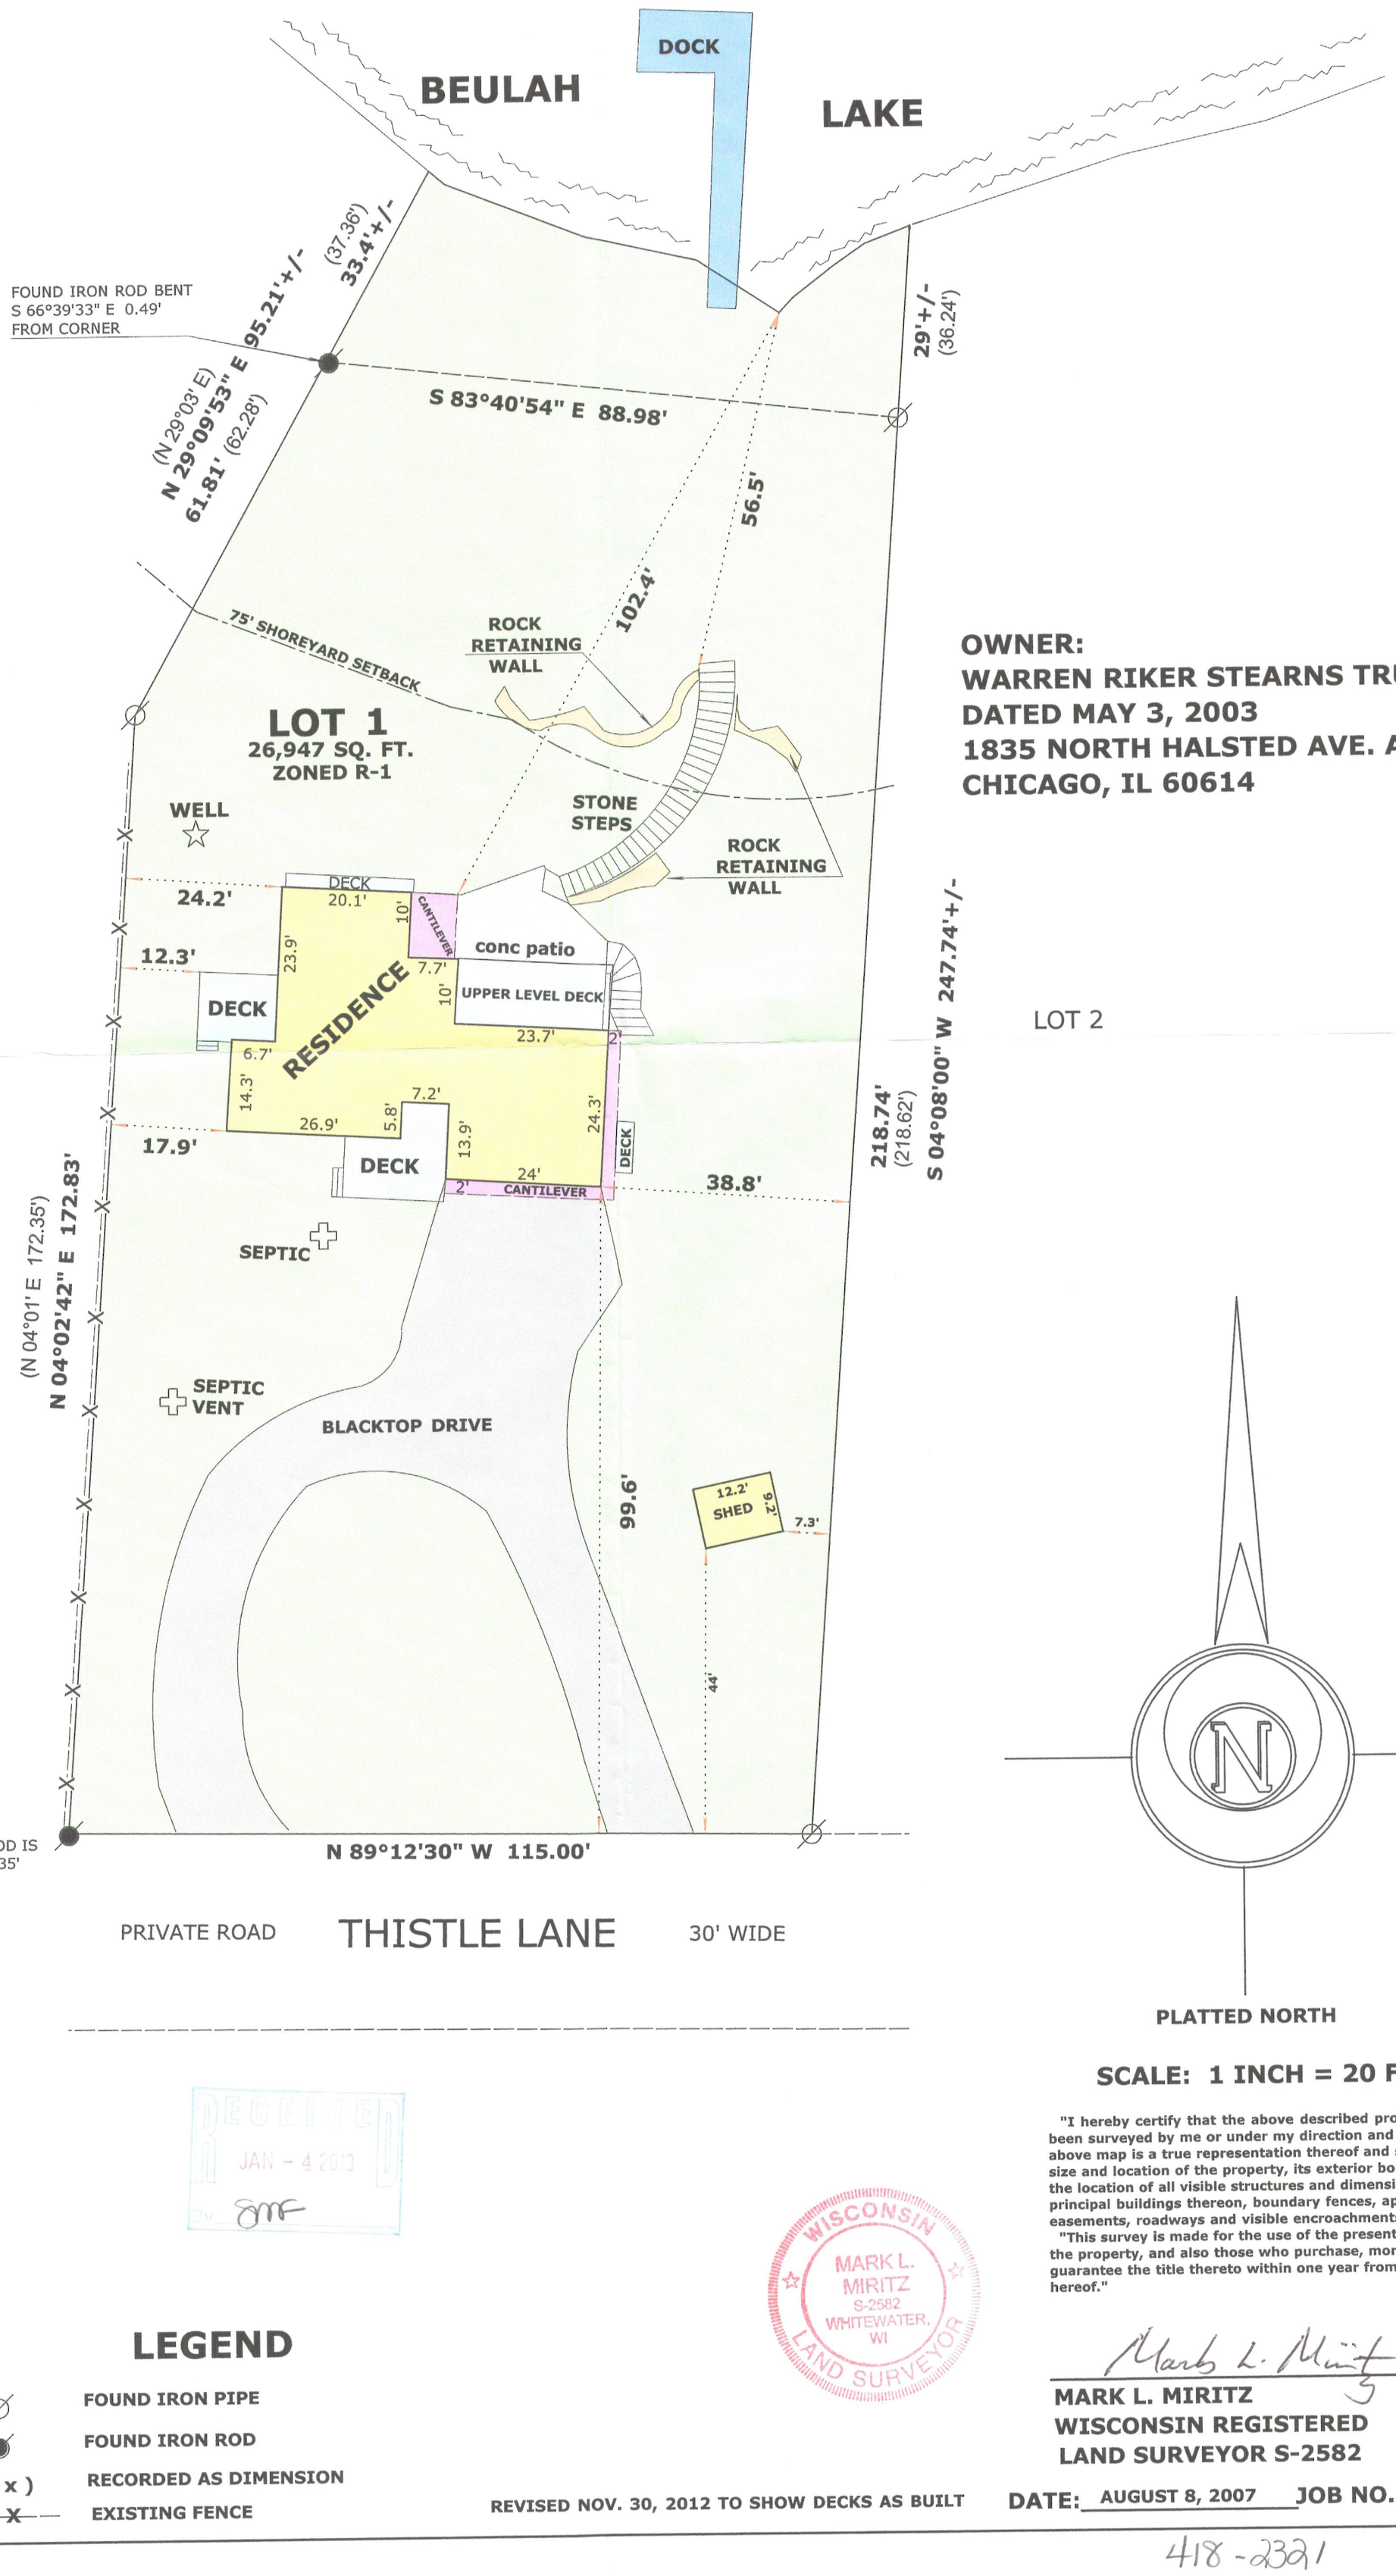

OWNER:
WARREN RIKER STEARNS TRUST
DATED MAY 3, 2003
1835 NORTH HALSTED AVE. APT 5
CHICAGO, IL 60614

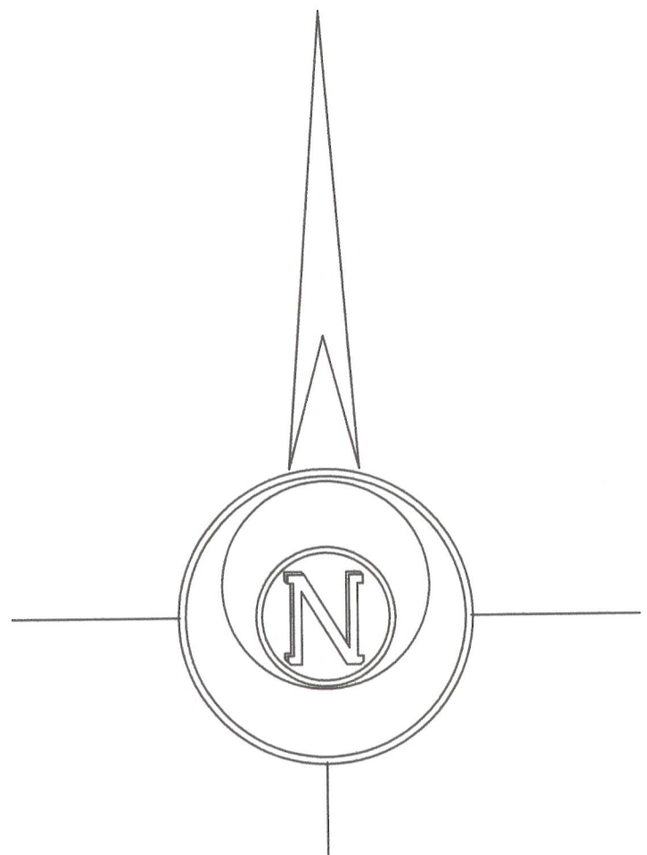

SCALE: 1 INCH = 20 FEET

"I hereby certify that the above described property has been surveyed by me or under my direction and that the above map is a true representation thereof and shows the size and location of the property, its exterior boundaries, the location of all visible structures and dimensions of all principal buildings thereon, boundary fences, apparent easements, roadways and visible encroachments, if any."
"This survey is made for the use of the present owners of the property, and also those who purchase, mortgage, or guarantee the title thereto within one year from date hereof."

Mark L. Miritz

MARK L. MIRITZ
WISCONSIN REGISTERED
LAND SURVEYOR S-2582

DATE: AUGUST 8, 2007 **JOB NO.** 07.803

RECEIVED
JAN - 4 2013
BY: SMF

WISCONSIN
MARK L. MIRITZ
S-2582
WHITEWATER, WI
LAND SURVEYOR

LEGEND

- ∅ FOUND IRON PIPE
- ● FOUND IRON ROD
- (x x) RECORDED AS DIMENSION
- —x—x— EXISTING FENCE

REVISED NOV. 30, 2012 TO SHOW DECKS AS BUILT

PA 30-1

418-2321