


## PLAT OF SURVEY


  
WCPS0044262

**LOCATION:** N9066 Austin Road, East Troy, Wisconsin


**LEGAL DESCRIPTION:** Lot 1 in **CERTIFIED SURVEY MAP NO. 2185**, being a part of the Northeast 1/4 of the Southeast 1/4 of Section 7, and a part of the Northwest 1/4 of the Southwest 1/4 of Section 8, Town 4 North, Range 18 East, in the Town of East Troy, Walworth County, Wisconsin.

December 13, 1999

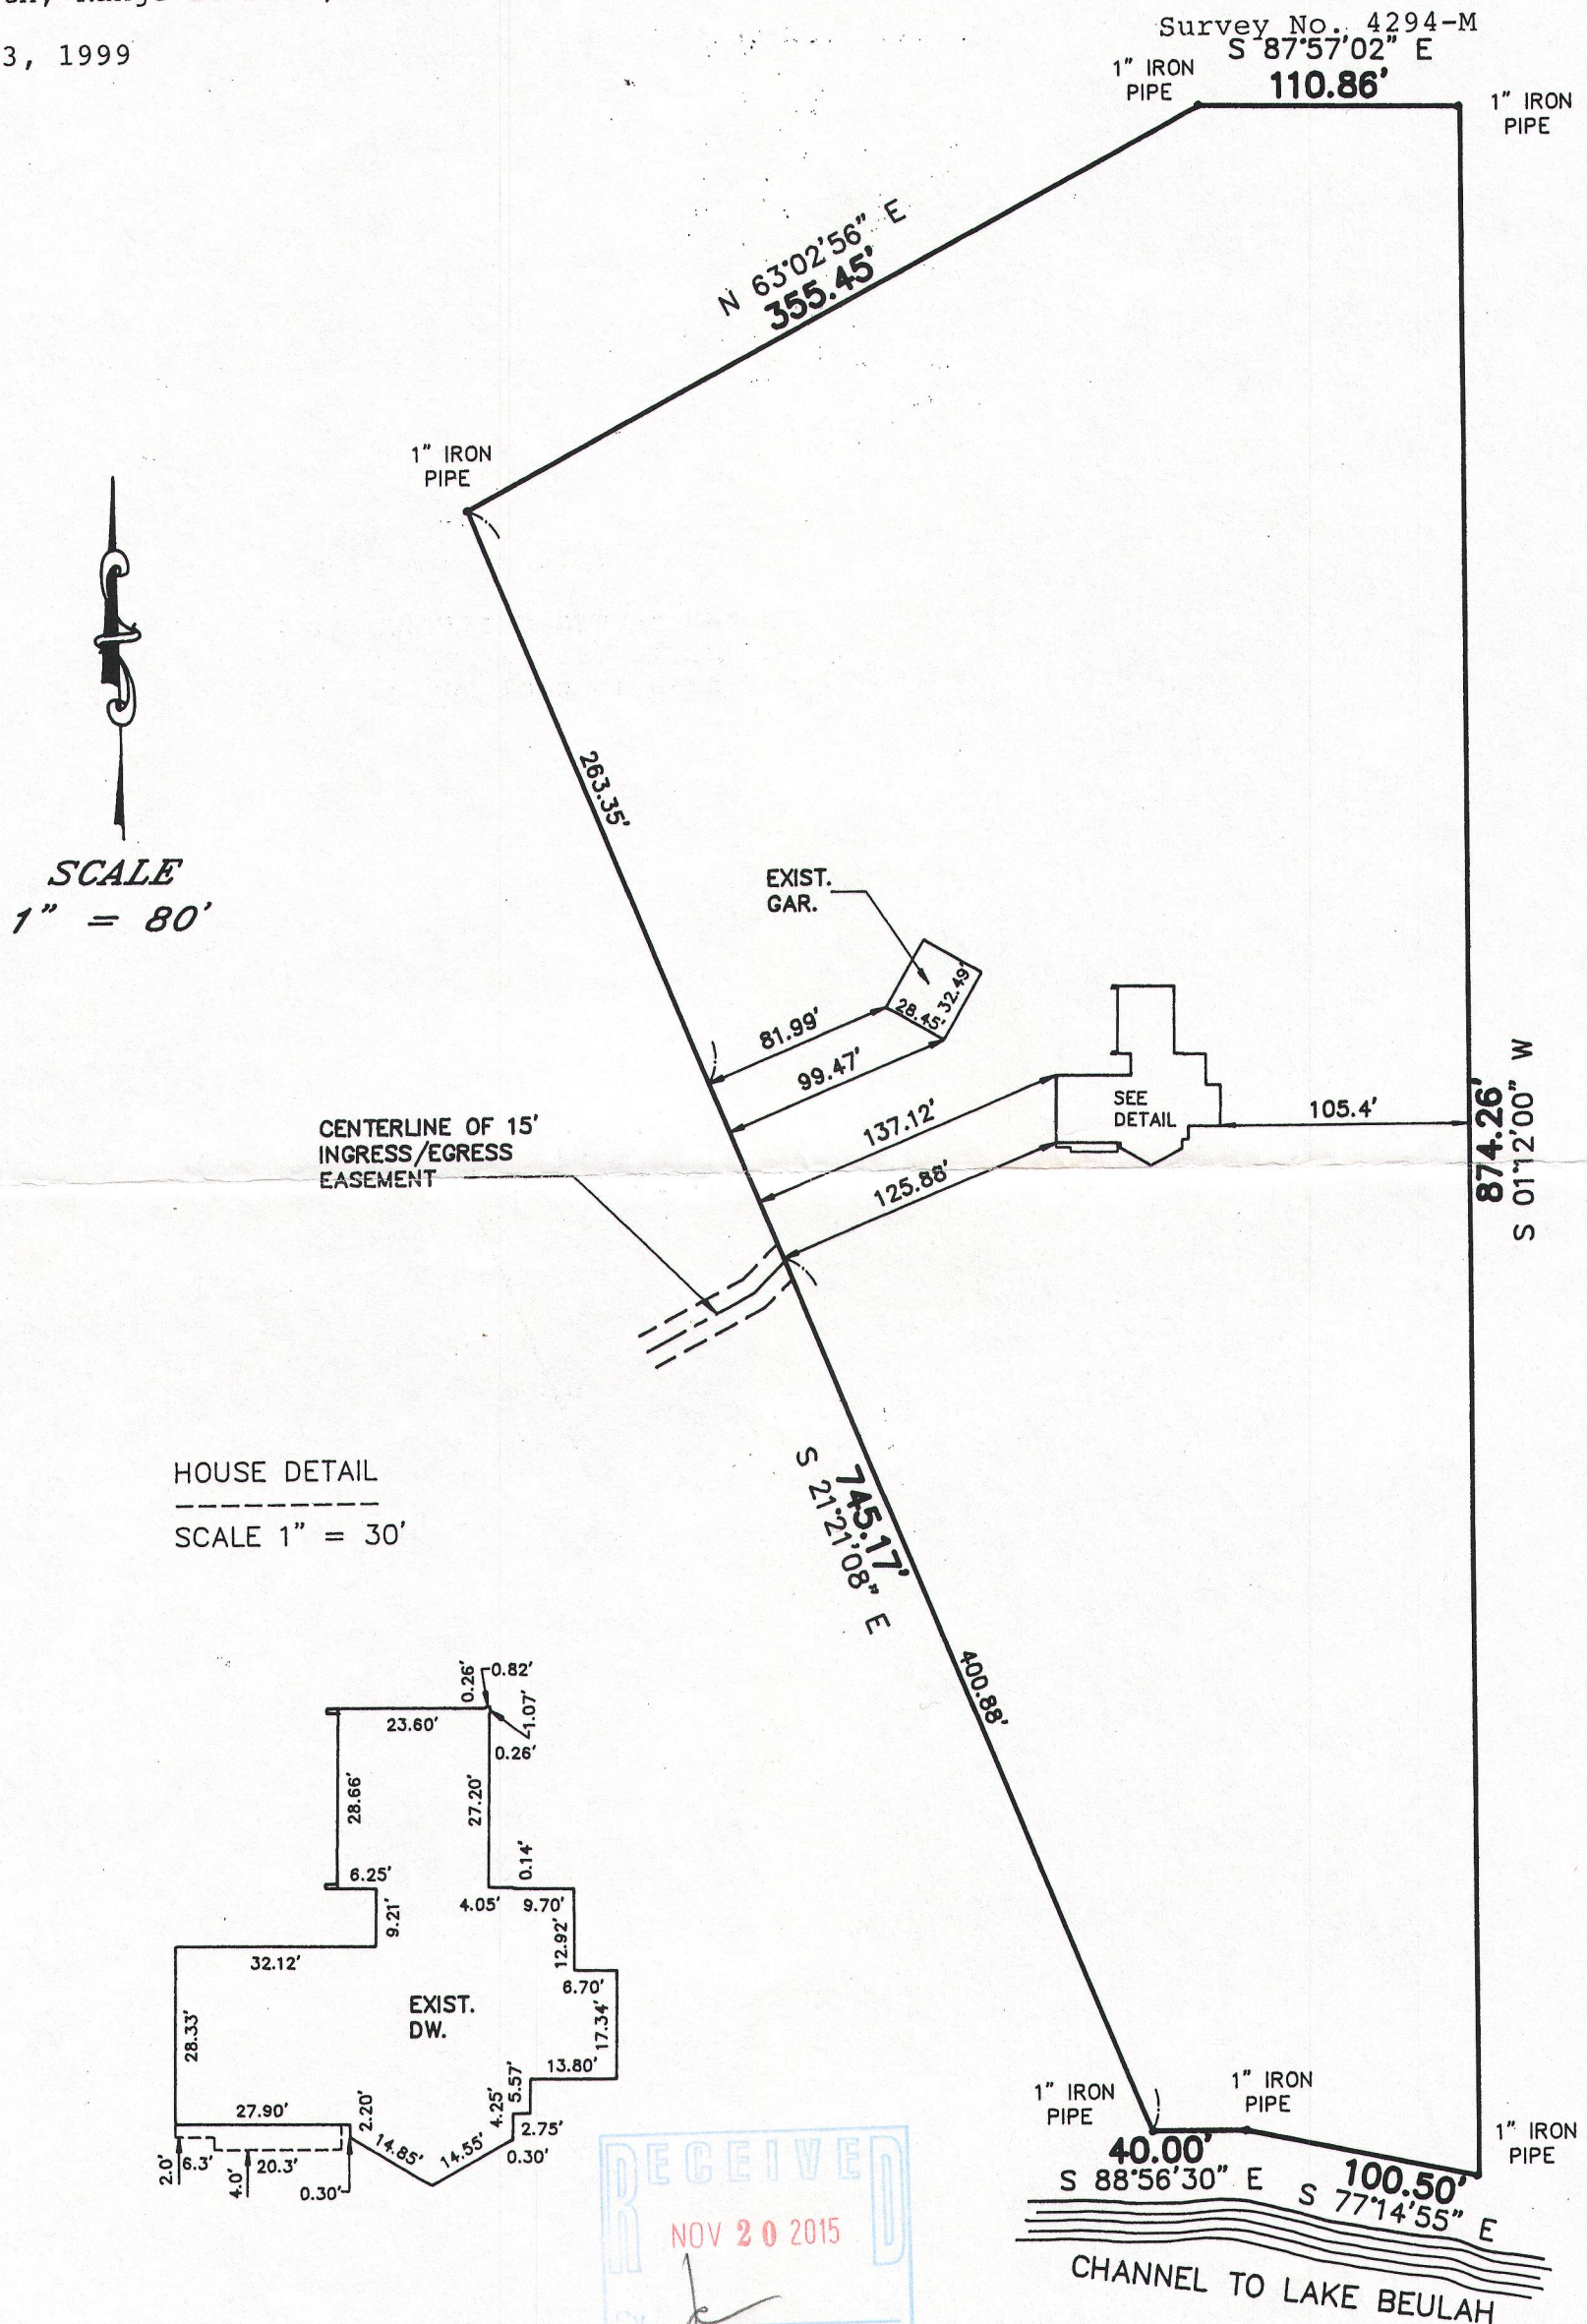

RECEIVED

NOV 20 2015

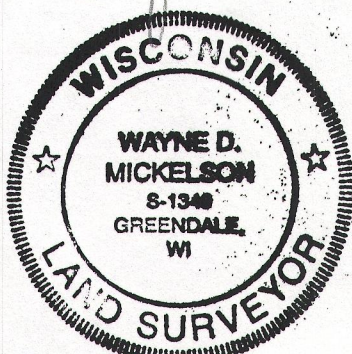

**METROPOLITAN ENTERPRISES, INC.**  
 REGISTERED LAND SURVEYORS  
 9415 W. FOREST HOME AVE., SUITE 202, HALES CORNERS, WI 53130  
 PH. 529-5380 FAX 529-9787

I HEREBY CERTIFY THAT I HAVE SURVEYED THE ABOVE DESCRIBED PROPERTY AND THAT THE ABOVE MAP IS A TRUE REPRESENTATION THEREOF AND SHOWS THE SIZE AND LOCATION OF THE PROPERTY, ITS EXTERIOR BOUNDARIES, THE LOCATION OF ALL VISIBLE STRUCTURES AND DIMENSIONS OF ALL PRINCIPAL BUILDINGS THEREON, BOUNDARY FENCES, APPARENT EASEMENTS AND ROADWAYS AND VISIBLE ENCROACHMENTS, IF ANY.

THIS SURVEY IS MADE FOR THE EXCLUSIVE USE OF THE PRESENT OWNERS OF THE PROPERTY, AND ALSO THOSE WHO PURCHASE, MORTGAGE, OR GUARANTEE THE TITLE THERETO WITHIN ONE (1) YEAR FROM DATE HEREOF.

SIGNED *Wayne D. Mickelson*

Wayne D. Mickelson  
 Registered Land Surveyor S-1348