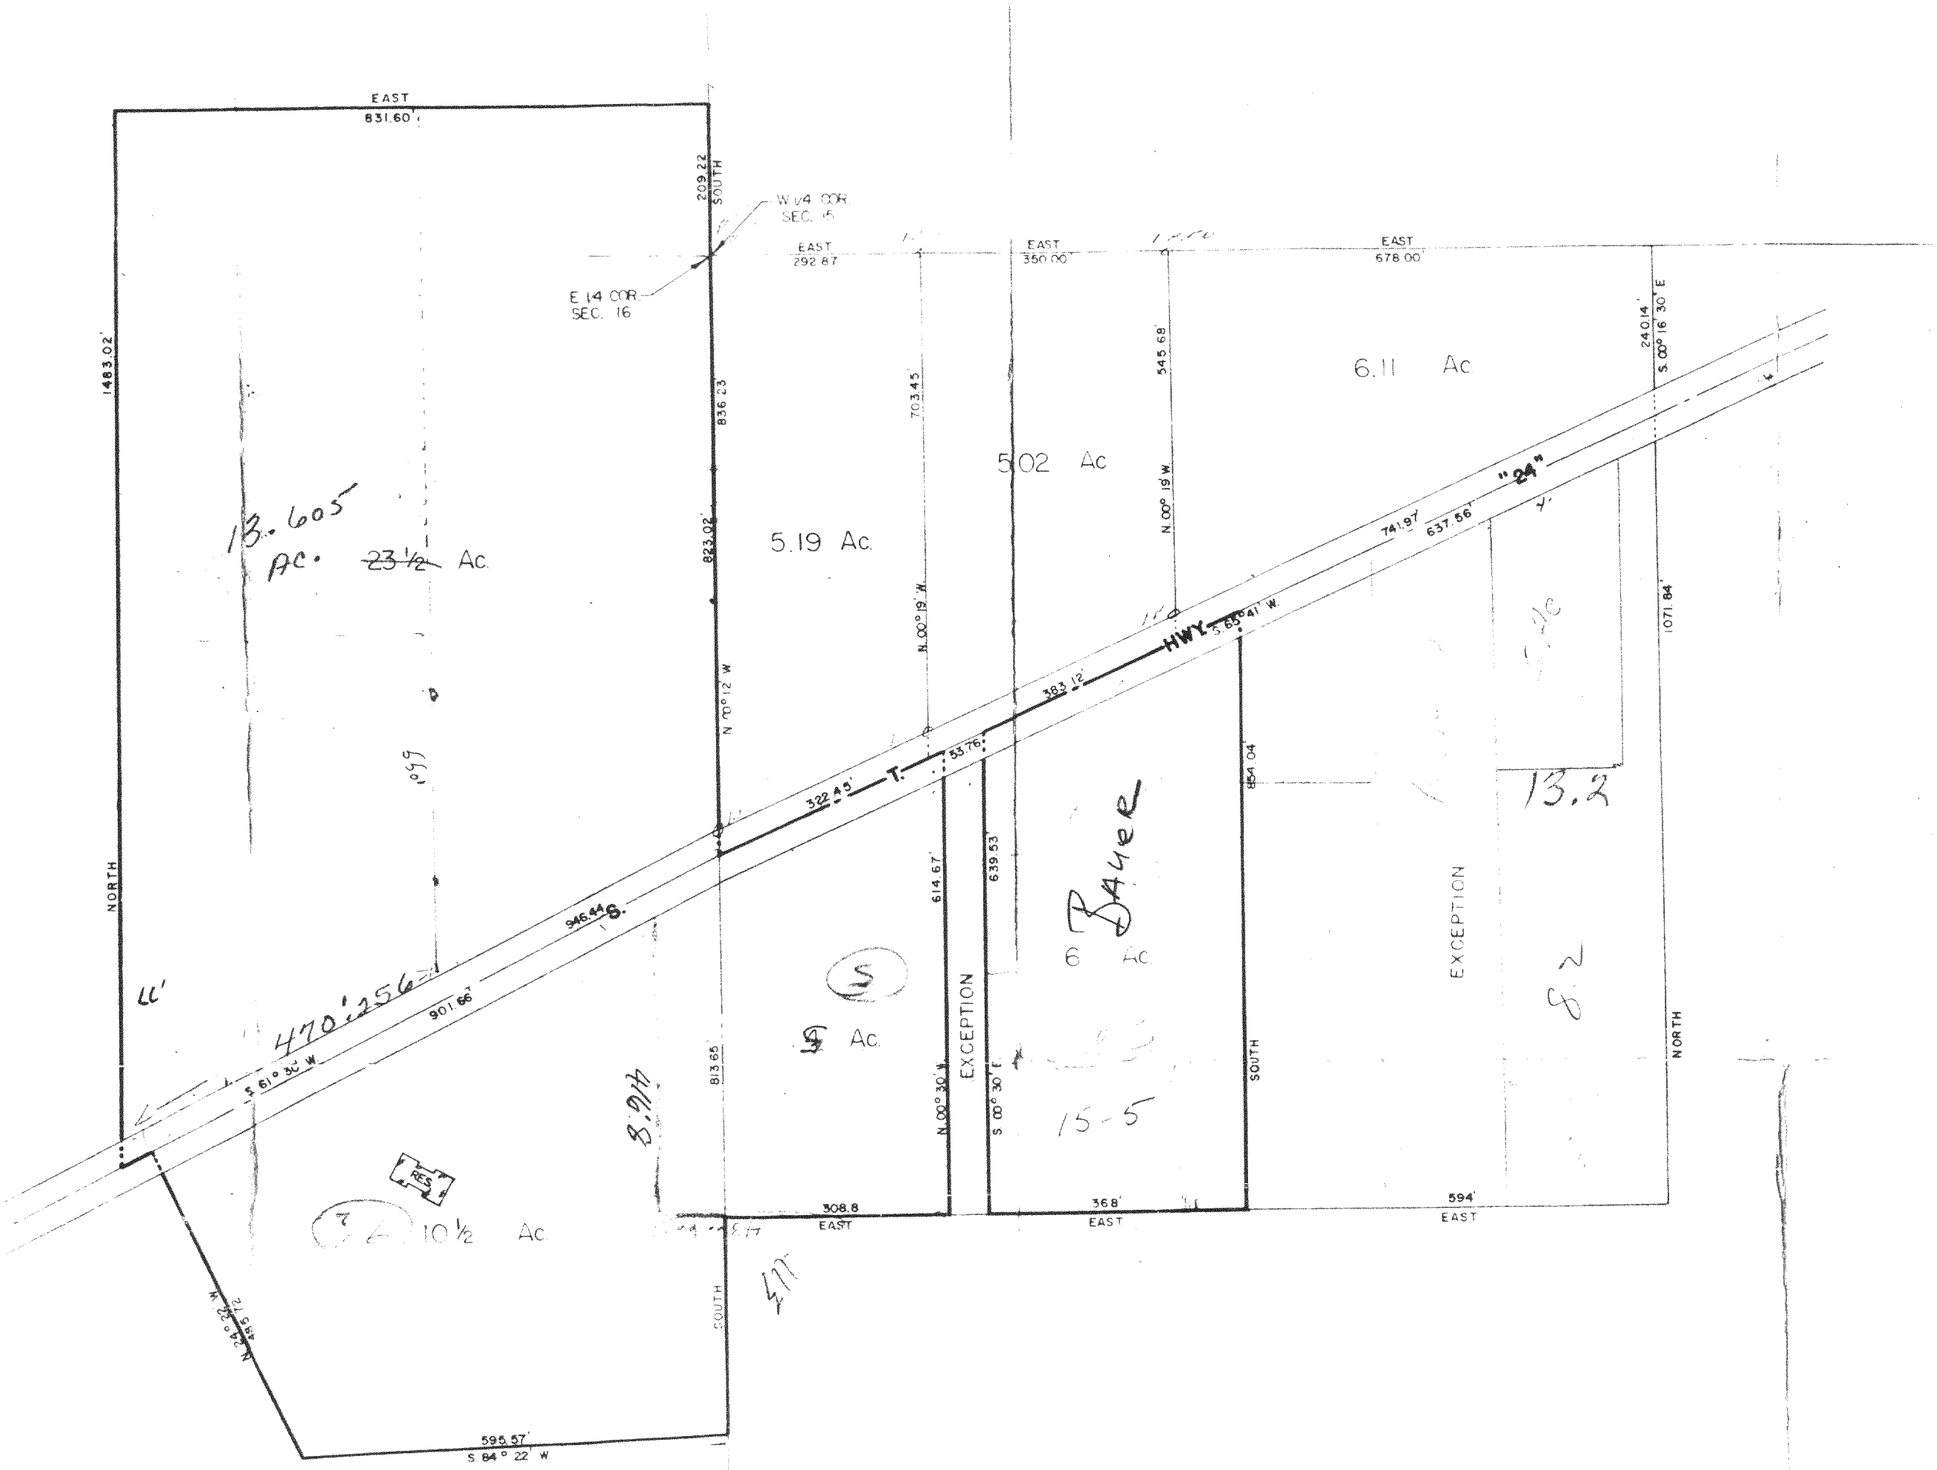

STATE OF WISCONSIN } SS
COUNTY OF WAUKESHA

CERTIFICATION

I, RONALD H. ZIMMERMAN, REGISTERED LAND SURVEYOR, DO HEREBY CERTIFY THAT I HAVE MADE A MAP OF OF THE GERALD BAUER PROPERTY SHOWN ABOVE AND THAT THE PLAT HEREWITH DRAWN IS A CORRECT REPRESENTATION THEREOF

DATE SEPT 2, 1971

RONALD H. ZIMMERMAN S 868

PLAT OF REC
FOR
GERALD BA

PART — S.W. 1/4 SECTION
E. 1/2 SECTION
TOWN OF EAST TROY, WALWORTH

BY · RONALD H. ZIM
REGISTERED LAND SUR
WAUKESHA, WIS.

DRAWN BY — DATE —
CHK'D BY — FILE —

418-280-Z