PLAT OF SURVEY

OF LOT 2 OF CERTIFIED SURVEY #27 LOCATED IN THE EAST 1/2 OF SECTION 9, T4N, R18E, WALWORTH COUNTY, WISCONSIN

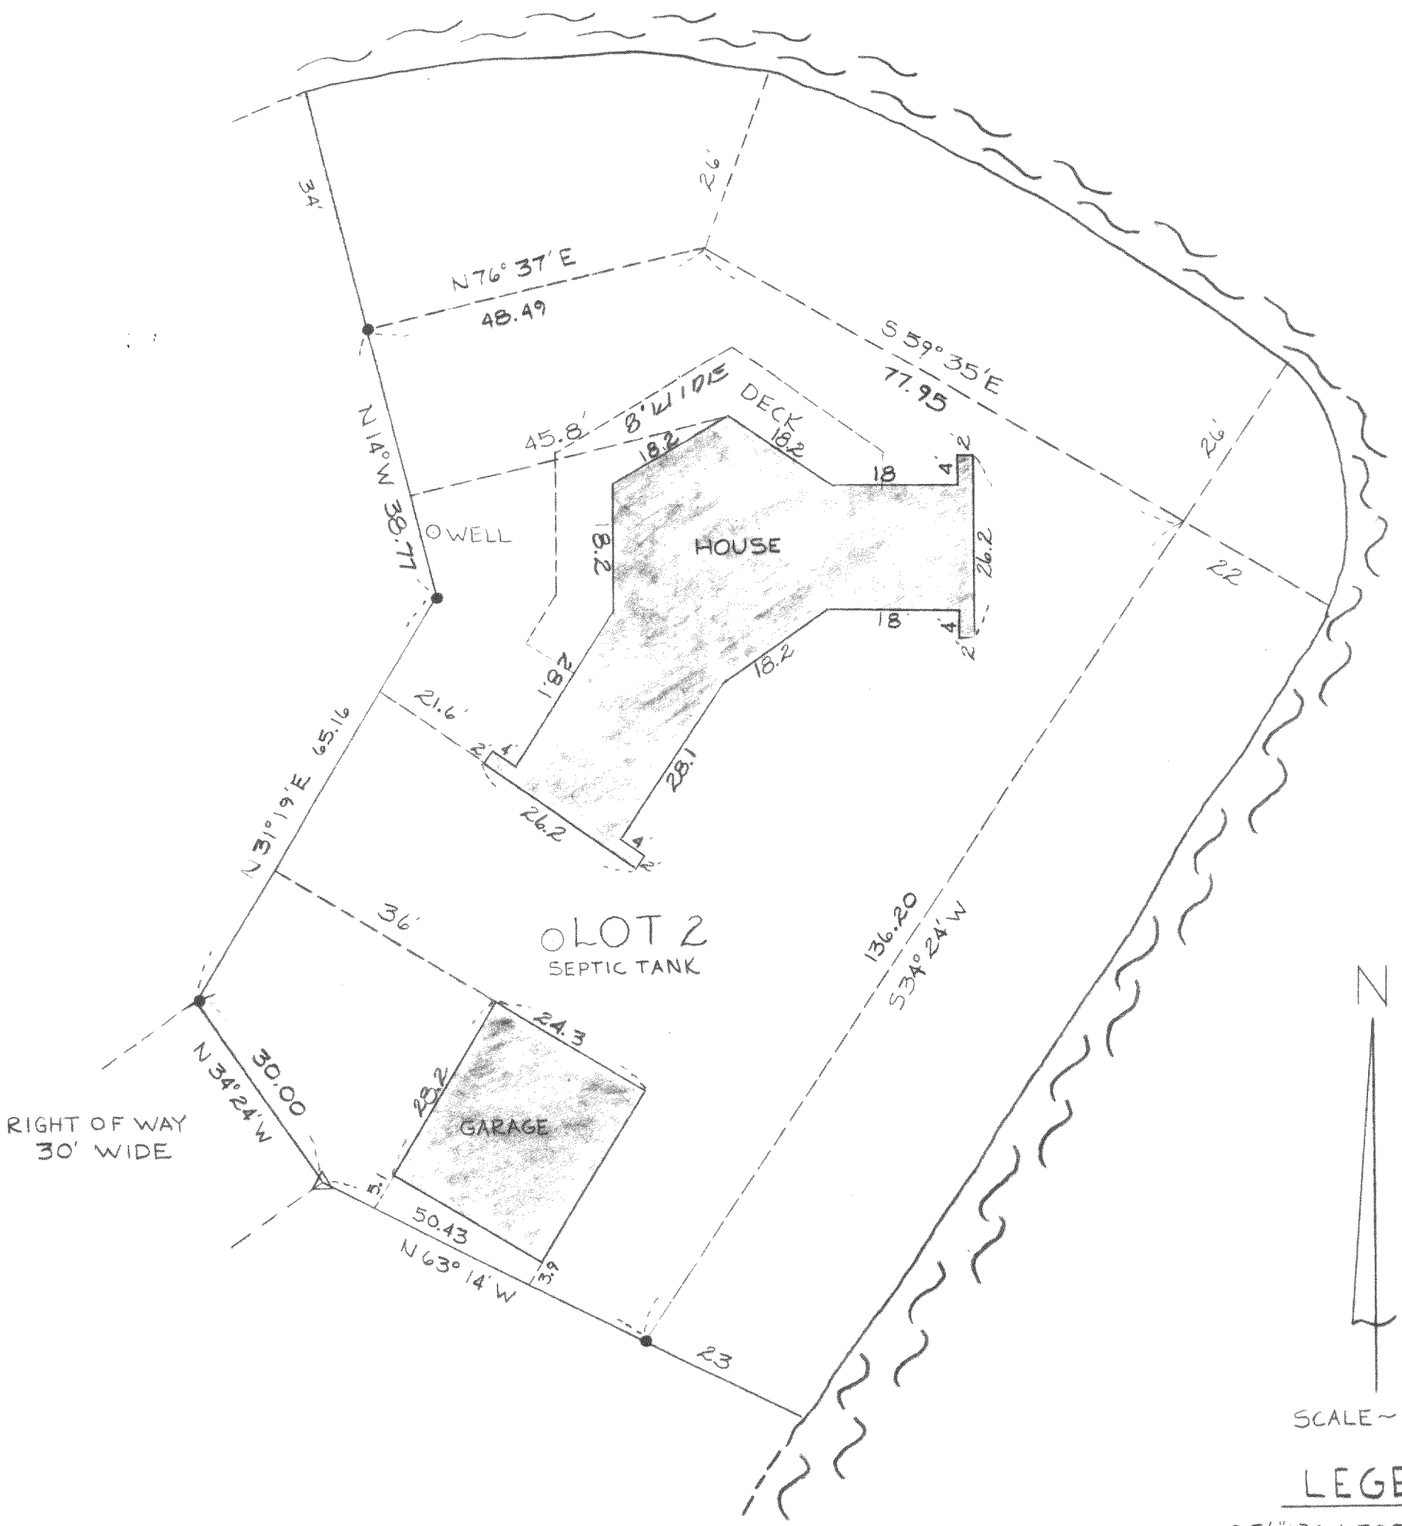

SURVEYED FOR: RICHARD BOHL
1108 SOUTH SHORE LANE
EAST TROY WISC.

SURVEYED BY: THOMAS P.A. JENSEN S-1084
DRAFTED BY: R.L. MEADOWS

LEGEND

- ● 3/4" IRON ROD FOUND
- ⌀ 3/4" IRON ROD SET
- △ RAILROAD SPIKE SET

JENSEN SURVEYING & MAPPING S.C.
P.O. BOX 322
ELKHORN WISC 53121

I HEREBY CERTIFY THAT I HAVE SURVEYED THE ABOVE DISCRIBED PARCEL OF LAND, AND THAT THE PLAT HEREON DRAWN IS AN ACCURATE SURVEY AND A TRUE REPRESENTATION THEREOF, AND CORRECTLY SHOWS THE BOUNDARY LINES OF SAID PROPERTY.

APRIL 28, 1981

WISCONSIN
THOMAS P. A. JENSEN
S-1084
ELKHORN, WIS
LAND SURVEYOR

Thomas P. A. Jensen

PA 27-2

418-412 J

1981.029