CURVE DATA

LOT	RADIUS	CENTRAL ANGLE	CHORD BEARING	CHORD DISTANCE	ARC
1	60.00'	50°00'02"	S 50°55'28"E	50.715'	52.360'
OUT-LOT 1	60.00'	9°35'35"	S80°43'16.5"E	10.034'	10.046'
2	60.00'	49°29'57"	N69°43'57.5"E	50.238'	51.835'
3	60.00'	75°24'25"	N 7°16'46.5 E	73.389'	78.966'
①~②	60.00'	184°29'59"	S61°49'34"W	119.91'	193.208'

RECEIVED
OCT 14 1986

Building Setback line (where lot is 100' in width, normal to curve)

66' WIDE PUBLIC ROAD

KOENIG COURT

Iron Rod B.M. = 110.91

LOT 3 CSM No 1326

R=60'

N27°34'00"W 61.69'

S69°53'00"E 135.85'

6' EASEMENT

S76°01'01"E 30.00'

S32°01'01"E 71.91'

N89°18'58"E 149.43'

N58°51'31"E 65.64'

169.43'

S1°36'00"E 69.41'

S14°04'30"W 88.58'

S14°04'30"W 99.92'

R-2 15,019.39 sq.FT.

459.29'

S68°24'00"W 196.85'

134.41'

158.41'

S18°24'00"W

LOT 3

R-2 = 33,35[illegible]

103.65

LOT R-2 = 27,676 SQ.FT.

Proposed House Location

Note: Revised 3/14/86 To Show Actual Location

S1°00'00"E 75.00'

N73°34'50"E 223.29'

204.29'

63.11'

206.43'

OUTLOT 1

6,301 sq. FT.

220.43'

252.94'

S68°24'00"W

R-2 = 6500 sq FT.

ZONING LINE

S60°18'00"E 80.87'

N72°24'00"E

LOT 2

C-1 = 17,253.24 sq. FT.

174.48'

S77°56'00"E 49.92'

246.96'

C-1 = 10,900 sq FT.

ZONING LINE

Elevation of Lake assumed 100.00'

NOTE: HOUSE FOUNDATION IS BUILT IN THE POSITION SHOWN ABOVE. WELL WITHIN THE LOT & BUILDING SETBACKS

Scale 1"=50'

ELEVATION OF LAKE ASSUMED 100.00

GROUND ELEVATION AT HSE CORNERS

① 106.7
② 107.8
③ 107.6
④ 104.8
⑤ 106.1
⑥ 102.0
⑦ 102.6
⑧ 102.9
⑨ 103.0
⑩ 105.5
⑪ 105.7
⑫ 104.6

Surveyed for: Embassy Construction
4701 N. 76th St.
Milwaukee, WI. 53218

POTTERS LAKE

X 1985.14

LOCATION SKETCH

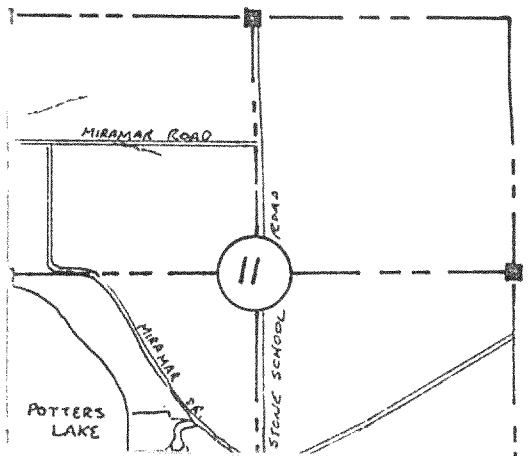

Jensen Surveying & Mapping S.C.
Po. Box 322
Elkhorn, WI. 53121

REVISED 2/3/86

4/P-538