FARRIS, HANSEN & ASSOCIATES, INC.

7 RIDGEWAY COURT, P.O. BOX 487, ELKHORN, WISCONSIN TEL. 414-723-2098

LOCATION: PART OF LOT 10 OF BEULAH LAKE PARK SUB.
IN SEC. 4, T.4N., R.18E., WALWORTH CO. WI.

WORK ORDERED BY: RODERICK MANN

10 0 10 20 30 40 50 60 70 80 90 100

MAP SCALE IN FEET

MAP LEGEND
- Ø = IRON PIPE STAKE FOUND
- = IRON PIPE STAKE SET
- ⌀ = IRON NAIL STAKE FOUND
- O = IRON ROD STAKE SET
- = CONCRETE MONUMENT FOUND
- (XXXXX) = RECORD DIMENSION

LEGAL DESCRIPTION OF LAND SURVEYED:

LOT 10 OF THE SUBDIVISION OF LOT 10 BUELAH LAKE PARK T4N : R18E, TOWN OF EAST TROY, WALWORTH COUNTY, WISC.

RECEIVED JAN 25 1988

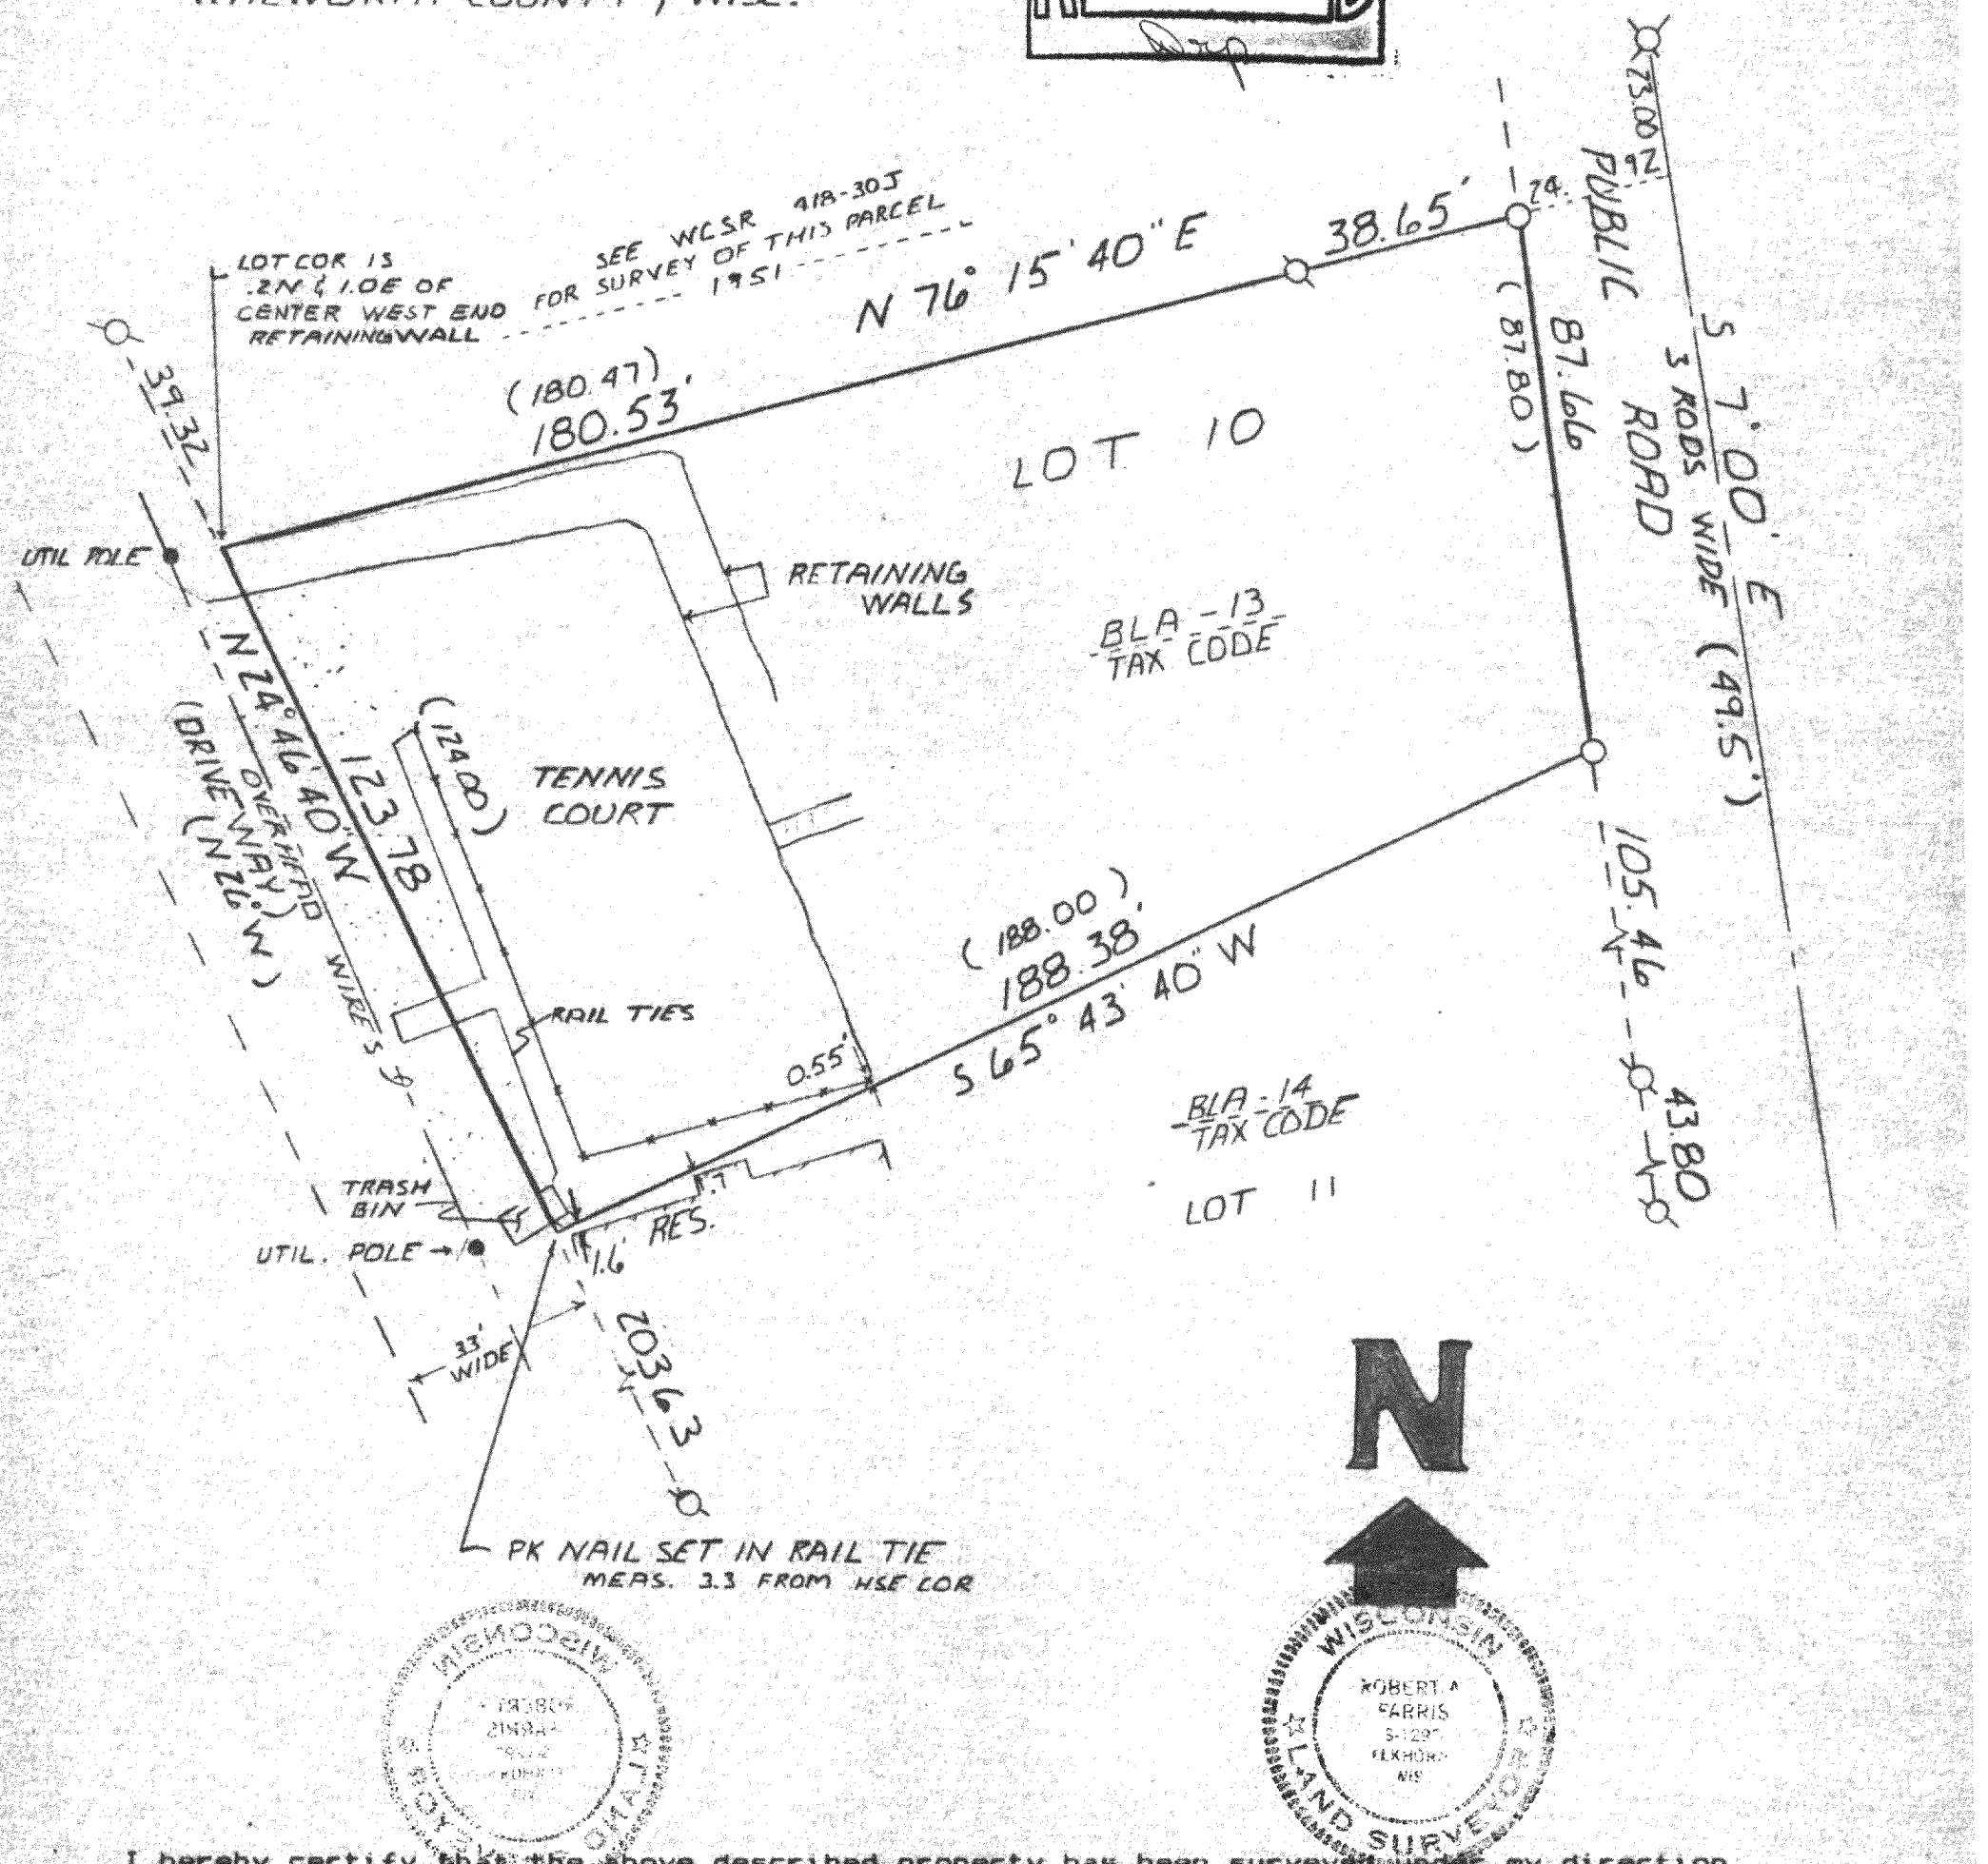

WISCONSIN ROBERT A FARRIS S-1297 ELKHORN WIS LAND SURVEYOR

I hereby certify that the above described property has been surveyed under my direction and that the above map is a true representation thereof and shows the size and location of the property, its exterior boundaries, the location of all visible structures and dimensions of all principal buildings thereon, boundary fences, apparent easements, roadways and visible encroachments, if any. This survey is made for the use of the present owners of the property, and also those who purchase, mortgage, or guarantee the title thereto within one year from the date hereof.

DATED : Jan 18, 1988 Robert A. Farris PROJ. NO. 2770-A

PBLA-13 418-600