PLAT OF SURVEY
OF

Let 12 Mc Graw's Park Subdivision located in the NE 1/4 of Section 9, T 4 N, R 18 E, Walworth County, Wisconsin.

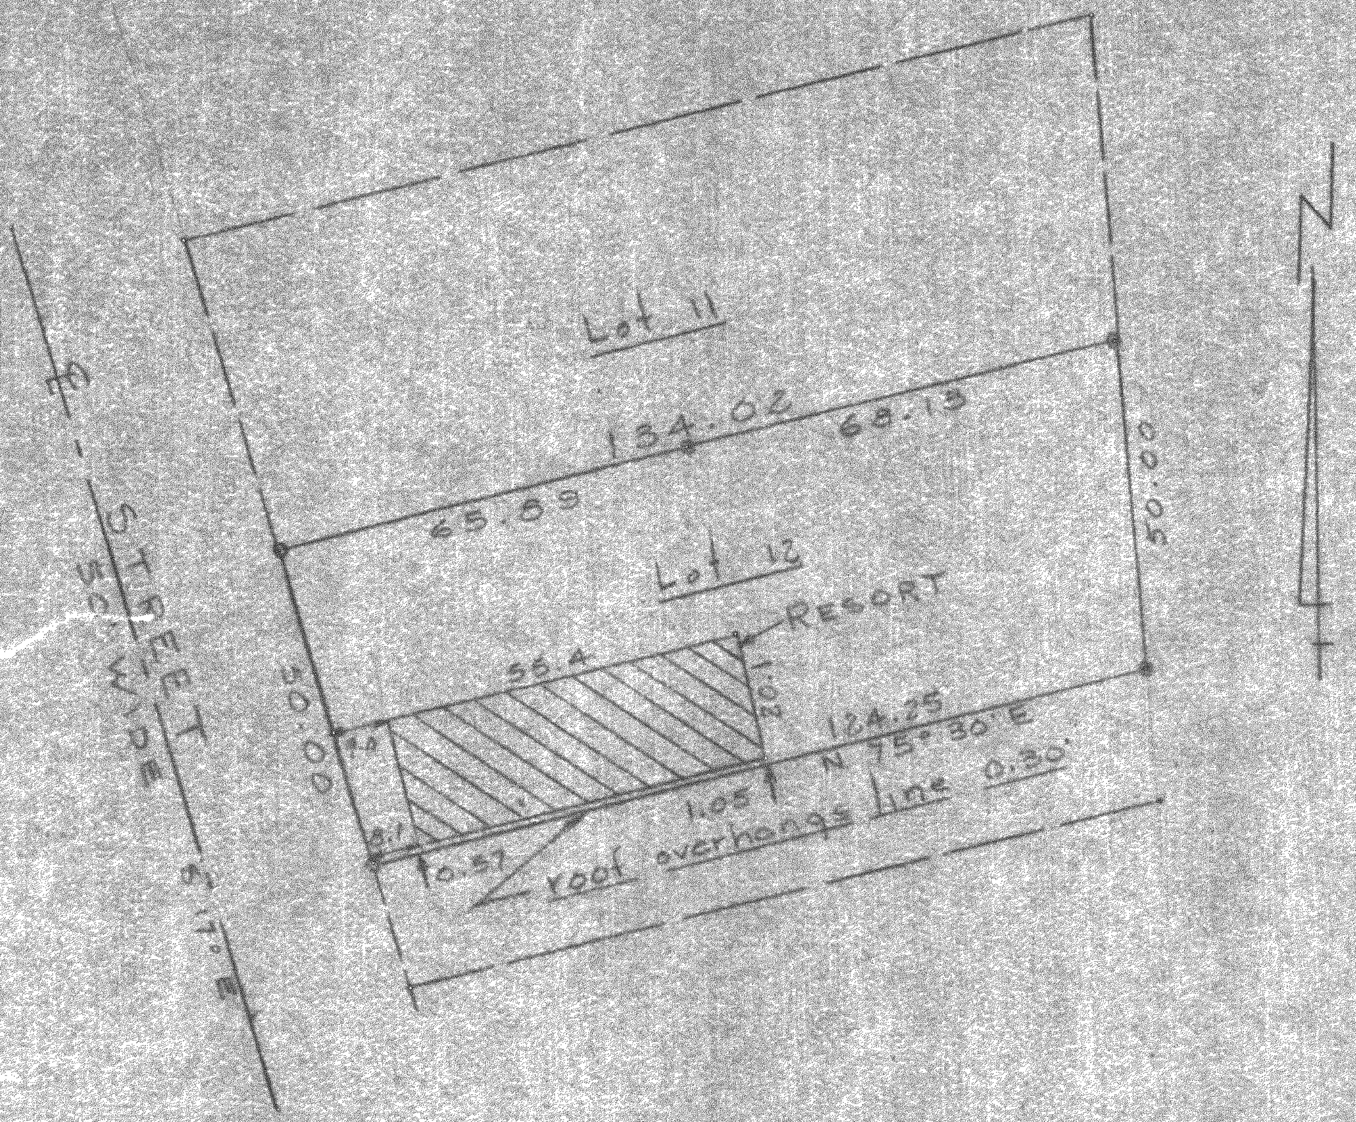
Lot 11
134.02
68.13
65.89
50.00
Lot 12
RESORT
55.4
1.02
30.00
4.4
124.25
N 75° 30' E
1.05
8.1
0.57
roof overhangs line 0.30
E
STREET
SQUARE
S 17° E

SURVEY AND PLAT BY

JENSEN & JOHNSON

CIVIL ENGINEERS AND SURVEYORS

Elkhorn, Wisconsin

LEGEND

o — Iron Pipe

● — Concrete Monument

Scale 1" = 30

WE CERTIFY: That we have surveyed the above described property and that the plat shown hereon is an accurate survey and a true representation thereof and correctly shows the exterior boundary lines and all divisions of said property, and buildings located thereon.

Date April 24, 1963

Lloyd L. Jensen

LLOYD L. JENSEN, Partner

Wisconsin Registered Land Surveyor, No. S-211

418-96

418-96 J

NO. 175H—400—1-30-58