272

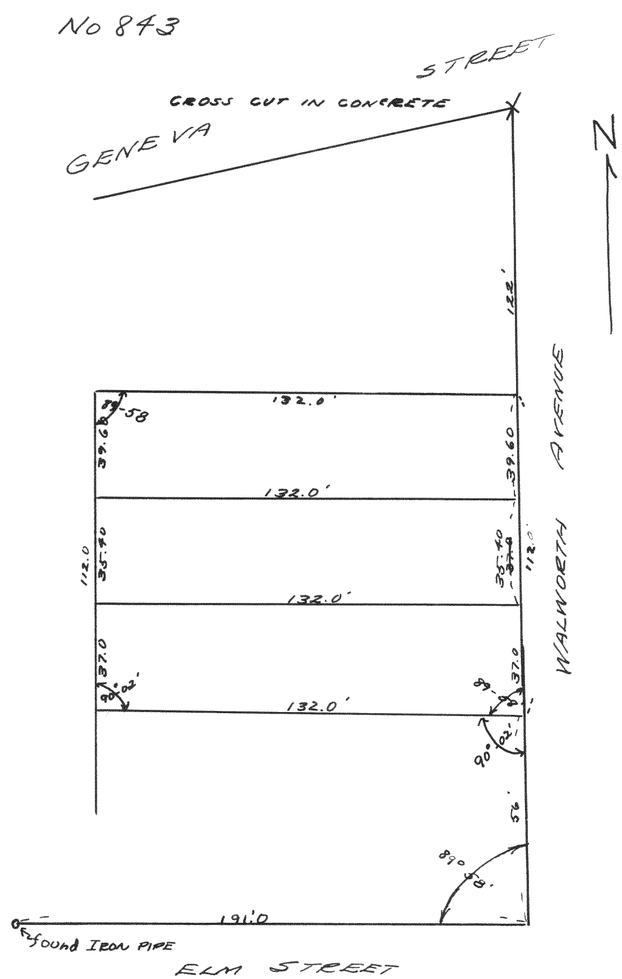

Survey of lot 1 - blk. 4 of
the original plat of Wms. Bay.

11-24-26-37 Lloyd L Jensen
by H. E. J.

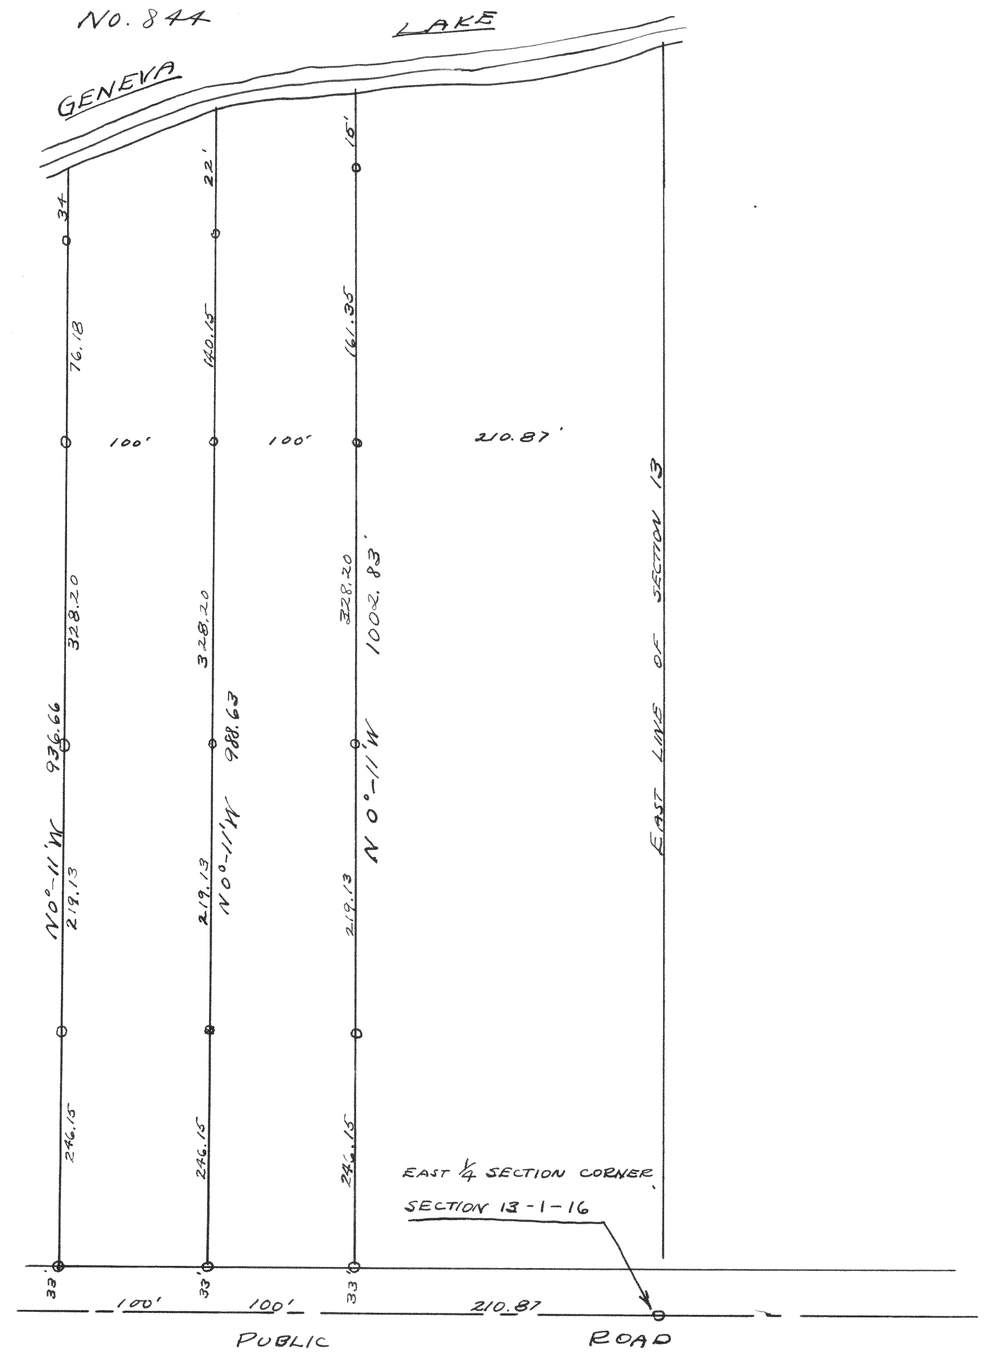

Survey of part of section 13-1-16
April 1938 Lloyd L. Jensen by H.E.J.