Record of Survey.

no 135

Carl Schwabe

Township....., North of Range 22 & 15 - 1 - 16 of 4 Principal Meridian

as presented by the courses and distances on the following plat and annexed field-notes of survey:

Established the center of the section at the point of intersection of straight quarter lines.

Established all quarter-quarter corners upon the section boundary at proportional distances between known section and quarter section corners, according to the original field-notes of the Government survey.

Established all lost corners at proportional distances between known corners according to the original field-notes of the Government survey.

from corner of Churchs lot 330 make point this point is 64 + 724.5 + 330 = 1118.5 N. of R.R. line. From this point E 1441 to stone Trods E of gr. post & 12.1 more stone for corner N. on stone line fence. Transit line run goes over stone and is 11.5 more fence. 8 corners 3147.5

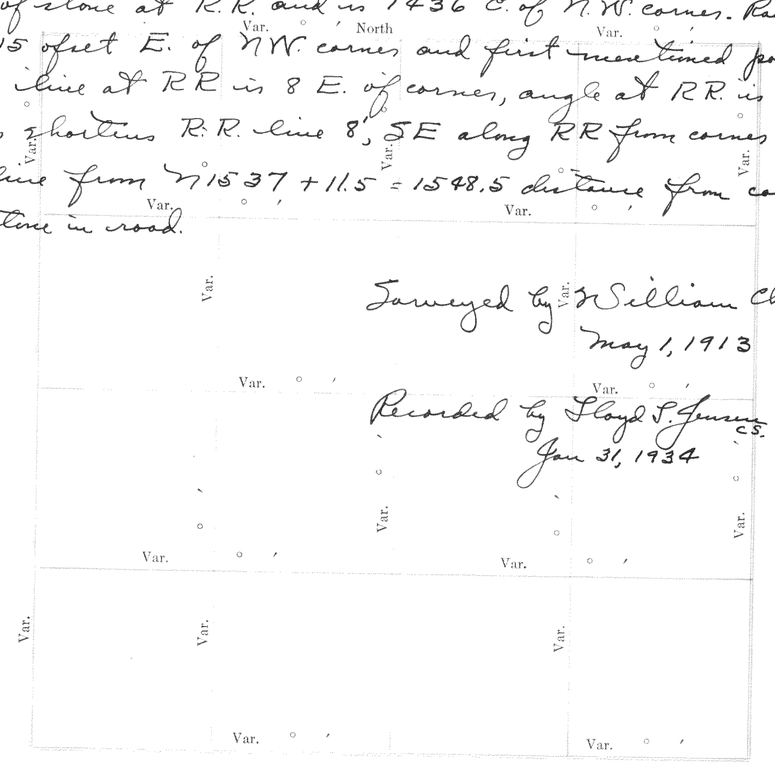

W. of stone at R.R. and is 1436 E. of N.W. corner. Run line on 15 offset E. of NW. corner and first mentioned point, This line at RR is 8 E. of corner, angle at RR is 69°-30' This shortens R.R. line 8, 5E along RR from corner to line from N 1537 + 11.5 = 1548.5 distance from corner to stone in road.

Surveyed by William Child C.S.
May 1, 1913

Recorded by Lloyd S. Jensen C.S.
Jan 31, 1934

Plat of Section....., Township..... North, Range..... of 4 Principal Meridian Scale 80 chains to 6 inches. The figures in red ink are the lengths of the lines as stated in the field-notes of the Government survey.

Declination of the Magnetic Meridian from the True Meridian.....

Surveyed and sub-divided..... A. D. 1 , in accordance with the State Laws and Instructions of the Commissioner of the General Land office, and recorded on pages ..... of Register in the County Clerk's office.

Witness my hand this..... day of..... A. D. 1

..... SURVEYOR.

DESCRIPTION

OF SECTION, QUARTER SECTION AND QUARTER QUARTER SECTION CORNERS

H. C. MILLER CO. MFG. STATIONERS, MILWAUKEE X15000

GOVERNMENT CORNERS	Bearing Trees	In. Dia.	Courses they bear	Links Distant	Bearing Trees	In. Dia.	Courses they bear	Links Distant	Bearing Trees	In. Dia.	Courses they bear	Links Distant	Bearing Trees	In. Dia.	Courses they bear	Links Distant
No.																
1. N. W. Sec. Cor. indentified,																
2. N. E. Sec. Cor. indentified,																
3. S. E. Sec. Cor. indentified,																
4. S. W. Sec. Cor. indentified,																
5. N. ¼ Sec. Cor. indentified,																
6. E. ¼ Sec. Cor. indentified,																
7. S. ¼ Sec. Cor. indentified,																
8. W. ¼ Sec. Cor. indentified,																
Subdivision Corners																
No.																
1. Center ¼ Sec. Cor.																
2. North ¼-⅛s N. W. qr.,																
3. East ¼-⅛s N. W. qr.,																
4. South ¼-⅛s N. W. qr.,																
5. West ¼-⅛s N. W. qr.,																
6. Center ¼-⅛s N. W. qr.,																
7. North ¼-⅛s N. E. qr.,																
8. East ¼-⅛s N. E. qr.,																
9. South ¼-⅛s N. E. qr.,																
10. Center ¼-⅛s N. E. qr.,																
11. East ¼-⅛s S. E. qr.,																
12. South ¼-⅛s S. E. qr.,																
13. West ¼-⅛s S. E. qr.,																
14. Center ¼-⅛s S. E. qr.,																
15. South ¼-⅛s S. W. qr.,																
16. West ¼-⅛s S. W. qr.,																
17. Center ¼-⅛s S. W. qr.																

no 136

Walworth Village

Stake at NW of Wilson lot pt. at SW of old parsonage lot 13" E & 2 N. of seam in walk. SW of Ride out lot 2" N & 7" E of corner of Blk in walk 3" E of seam and 4" S. of walk. Found stake at NE corner of Blk W and take pt. at south end of street on W. line of crosswalk being 1' W. of west side of walk. Run line between these and 49.5 E of this line make line for E. line of street and on this line make pt. for SW. cor. of old parsonage lot 13" E. of walk & 2" N. of seam. 66 N. of this is 7" E & 2" N. of NE. cor of Cement walk 115.5 N. being Trods drive pipe for cor. of Blk, being 4" S. of walk & 2" E of seam, find stake at NW. corner of Wilson lot. Run to that for S. line of St. From these 2 lines lay out lot Trods N & S by 8 Rds E & W.

Surveyed by William Child C.S.
Recorded by Lloyd S. Jensen C.S.
Jan 31, 1934

NAMES OF SWORN ASSISTANTS

CHAINMEN	FLAGMEN	AXMEN

no 137

Walworth Village

Hansen Oil Co.

Beginning at the ¼ sec. corner on the W. line of said Sec. 22, Thence E. on the ¼ Sec. line 90.5 ft. to a point Thence S 33.5 ft. to an iron stake, at the S. line of Cement walk and 96.5 ft. to an iron stake, Thence E. 11 ft. to an iron stake, Thence S 44 ft. Then W 64.3 ft. to the E. line of the Cement walk, and 99.3 ft. to the N & S ¼ Sec. line, Thence N. on the said ¼ Sec. line 142 ft. to the place of beginning, said grantors reserving for themselves their heirs executors, and assigns, the use of the driveway as it now exists at the present time, on the S side of the real estate herein conveyed, for all purposes of passing to and from all lands of said grantors heretofore reached by said driveway, until such time as a public street or alley shall be provided or laid out by the village of Walworth, which shall communicate with the said lands of said grantors.

William Child
C.S.

Recorded by Floyd F. Jensen C.S.
Feb. 1, 1934

no 138

William Child
C.S.

Recorded by Floyd F. Jensen C.S.
Feb. 1, 1934